IREDELL COUNTY HEALTH DEPARTMENT

STATESVILLE 704-878-5305 MOORESVILLE 704-664-5281

IMPROVEMENT PERMIT / CERTIFICATE OF COMPLETION / OPERATION PERMIT / EXISTING SYSTEM INSPECTION

PROPERTY DESCRIPTION NO. REPAIR DATE 9/23/94 TAX MAP NO. REPAIR Watershed: ☐ Yes ☒ No

OWNER OR CONTRACTOR BOBBY & MARGIE ELLIOTT PHONE: Business Home 872-3844

ADDRESS 3915 TAYLORSVILLE HWY STATESVILLE, NC 28677

LOCATION NC 90 W, 2ND HOUSE ON (L) PAST LORAY STATION (BRICK STRIP SHOPPING CTR)

SUBDIVISION BLOCK / SECTION LOT LOT AREA SITE CLASS. PS DESIGN FLOW 360 L.T.A.R. EXISTING

Septic Tank: EXISTING Gallons; STB Date

Pump Tank: Gallons; PT Date

Pump Make: Model Serial No.

Nitrification Field: No Fields 1 Square Feet 330 Linear Feet 110

No Lines 1 Trench Width 36" Max Trench Bottom Depth 30-36" Gravel Depth (24)

☐ New System ☒ Repair System Type: I, (II), III, IV, V, VI

System Description:

Repair System Description: CONV. GRAVITY

Maintenance Agreement Required: ☐ Yes ☒ No

☒ House/Mod. Home No. Bedrooms 3

☐ Mobile Home No. Bathrooms 1

☐ Business No. Employees

☐ Other


☐ Slab ☒ Crawl Space ☐ Basement w/plumbing ☐ Basement wo/plumbing

Water Supply: ☒ Individual ☐ Community ☐ Public WELL

Comments: (1) PUMP OUT SEPTIC TANK CHECK SANITARY "TEE" REPLACE IF NECESSARY (2) INSTALL 1 NEW DIST. BOX AS SHOWN (3) INSTALL NEW 3' X 110' LINE USING 24" STONE

Comments:

INITIAL SITE SKETCH

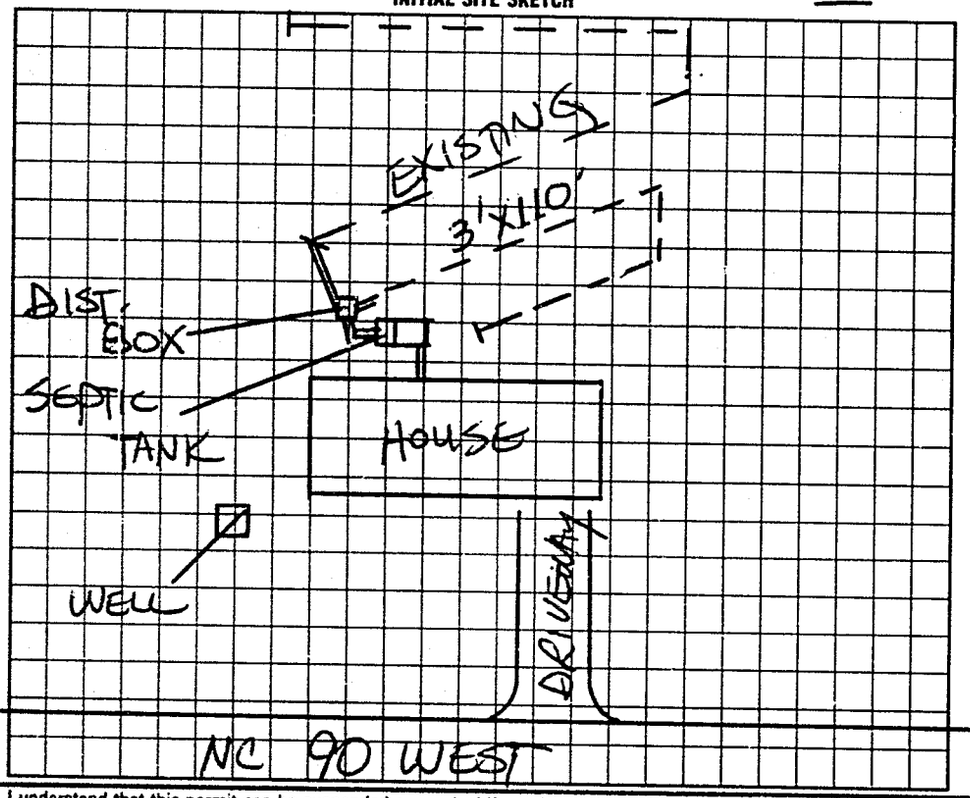

AS BUILT SKETCH

SYSTEM REPAIRED ACCORDING TO INITIAL SITE SKETCH

I understand that this permit can be suspended or revoked if any false information is supplied toward securing the permit/any unauthorized changes are made to the site/any unauthorized changes are made in the installation of the system. Improvement Permit is valid for 60 months from date of issuance.

Signed: X Marjorie H. Elliott

Improvement Permit by: STEVE HEDRICK date 9/23/94

Existing System Inspection by: date

Installed by: DONALD LACKEY

Certificate of Completion by: STEVE HEDRICK date 10/5/94

Operation Permit by: date

HEALTH DEPT. COPY: WHITE INSPECTION COPY (FINAL): GREEN OWNER COPY (FINAL): YELLOW INSPECTION COPY (INITIAL): PINK OWNER COPY (INITIAL): GOLD