IREDELL COUNTY HEALTH DEPARTMENT

STATESVILLE 704-878-5305 MOORESVILLE 704-664-5281

IMPROVEMENT PERMIT / CERTIFICATE OF COMPLETION / OPERATION PERMIT / EXISTING SYSTEM INSPECTION

PROPERTY DESCRIPTION NO. 17033 DATE 9-22-93 TAX MAP NO. 9D-B-7

OWNER OR CONTRACTOR Marjorie Hall Elliott PHONE: Business Home

ADDRESS Rt. 8 Box 480 Statesville, N.C. 28677

LOCATION Hwy 90 W Lot on L after Cook's Shopping area. (after Concord Presbiterian church).

SUBDIVISION NA BLOCK / SECTION LOT LOT AREA 2.35 acres SITE CLASS Existing ~~I I A R~~ →

Water Supply: ☑ Individual ☐ Community ☐ Public Well

Septic Tank: Existing ~~Gallons; STB~~ → Date

Pump Tank: Gallons; PT Date

Nitrification Field: No. Fields Square Feet Linear Feet

No. Lines Trench Width Trench Depth Gravel Depth

☐ New System ☐ Repair System Type: I, II, III, IV, V, VI

System Description:

Repair System Description:

Maintenance Agreement Required: ☐ Yes ☐ No

House/Mod. Home / Mobile Home / ✓ Business / ✓ Other Bed + Breakfast

No. Bedrooms 3 No. Bathrooms 1 No. Employees 1

☐ Slab ✓ Crawl Space ☐ Basement w/plumbing ☐ Basement wo/plumbing

Garbage Disposal: ☐ Yes ✓ No


Auto. Dishwasher: ✓ Yes ☐ No

Auto. Washing Machine: ✓ Yes ☐ No

Other

Comments System shows no visible signs of malfunction at time of inspection. Undetermined what size tank or amount of drainlines on lot.

INITIAL SITE SKETCH

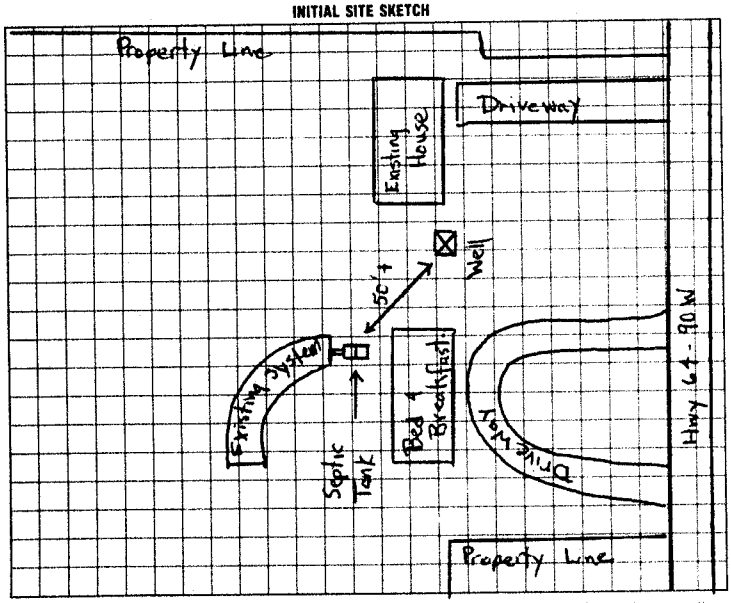

AS BUILT SKETCH

I understand that this permit can be suspended or revoked if any false information is supplied toward securing the permit/any unauthorized changes are made to the site/any unauthorized changes are made in the installation of the system. Improvement Permit is valid for 60 months from date of issuance.

Signed:

Improvement Permit by: date

Existing System Inspection by: Michael J. Dennis date 9-22-93

Installed by

Certificate of Completion by: date

Operation Permit by: date

HEALTH DEPT. COPY: WHITE INSPECTION COPY (FINAL) GREEN OWNER COPY (FINAL) YELLOW INSPECTION COPY (INITIAL) PINK OWNER COPY (INITIAL) GOLD