IREDELL COUNTY HEALTH DEPARTMENT

Statesville Phone TR 3-7271 Mooresville Phone No. 664-5281

PERMIT TO INSTALL SEPTIC TANK

Permit No. 26 Permit Date 10-26 1972

Owner Bobby Cook Address Loray NC

Installed By Harlie Lackey Address Stony Point NC.


Location of Property Hwy 90 Near Loray - T.L. on Rd #1512 T.R. 1st road - House on L. directly behind Concord Presbyterian Church

Tank		Capacity		Length of Lines		Fixtures	
Block	( )	1000	(✓)	225'	( )	No. of Baths	(2½)
Precast	(✓)	1250	( )	250'	( )	Dishwasher	( )
		1500	( )	Other 240		Garbage Grdr.	( )
		Other				Other	

NOTIFY HEALTH DEPARTMENT AT LEAST EIGHT HOURS BEFORE TANK IS TO BE INSPECTED.

Final Inspection 10-26 1972 Approved (✓) Disapproved ( )

Remarks Well More than 100 ft from System Soil very red and hard. Poor soil for absorption.

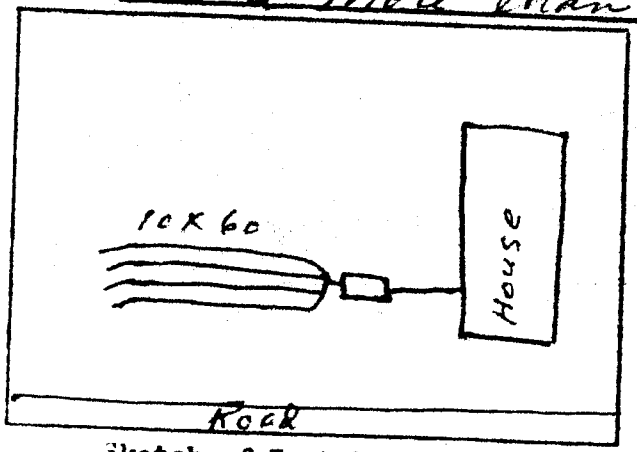

Sketch of Installation

E. G. Stevenson
Sanitarian