IREDELL COUNTY HEALTH DEPARTMENT - *ENVIRONMENTAL HEALTH* ☑ STATESVILLE OFFICE 704-878-5305 ☐ MOORESVILLE OFFICE 704-664-5281

IMPROVEMENT PERMIT / AUTHORIZATION TO CONSTRUCT / OPERATION PERMIT / EXISTING SYSTEM INSPECTION

PERMIT # Repair PIN # 47155 86233 DATE 7-30-12

OWNER Sue Stevenson APPLICANT: Same PHONE: Home/Cell # 704-873-7879 Business # N/A

SITE ADDRESS 146 Stevenson Farm Rd. OWNER / APPLICANT ADDRESS PO Box 27 Scotts NC 28679

SITE DIRECTIONS 90W, TR on Little Farm Rd. TL Stevenson Farm Rd. 6th House on Right

SUBDIVISION N/A BLOCK / SECTION N/A LOT # N/A LOT AREA 0.19 acres DESIGN FLOW 240 gpd L.T.A.R. 0.3

Septic Tank Existing Gallons: STB ____ Date ____

Pump Tank ____ Gallons: P T ____ Date ____

Pump Make ____ Model ____ Serial # ____

No. Nitrification Fields: 1 No. Lines 1 Bed Linear Feet 75' X 2

Trench Width 72" Max. Trench Bottom Depth 54" Gravel Depth 18"

☐ New System ☑ Repair ☐ Expansion System Type I (II) III IV V VI

System Description: ____

Repair System Description: 6' wide Bed

Maintenance Agreement Required ☐ YES ☑ NO

☑ GRAVITY ☐ PRESSURE

☑ Residence No. Bedrooms 2

☐ Business No. Persons ____

☐ Other No. Employees ____


☐ Slab ☑ Crawl Space

☐ Basement w/plumbing ☐ Basement w/o plumbing


Water Supply: ☐ Private ☑ Public ☐ Community

Comments / Conditions - Install a 6' wide bed with 2 corrugated lines & 18" of gravel. Maintain a minimum of 12" cover @ lowest elevation. Recommend removing maple trees or adding copper sulfate a couple times/year to reduce root damage

INITIAL SITE SKETCH

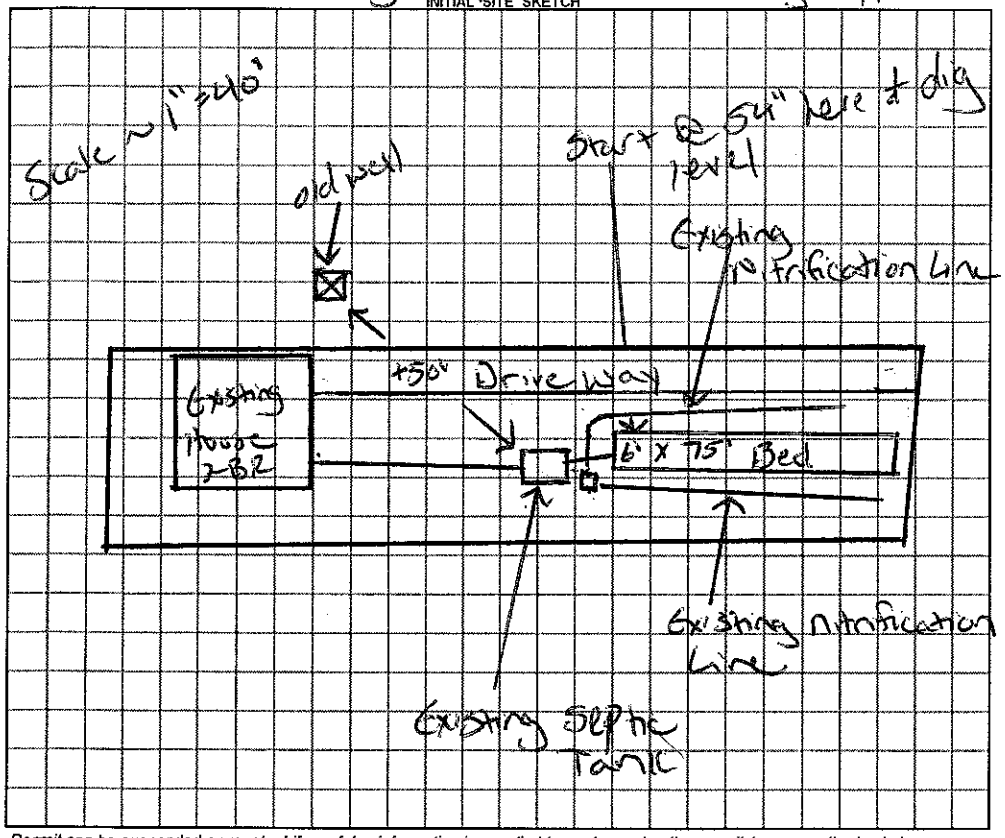

AS BUILT SKETCH

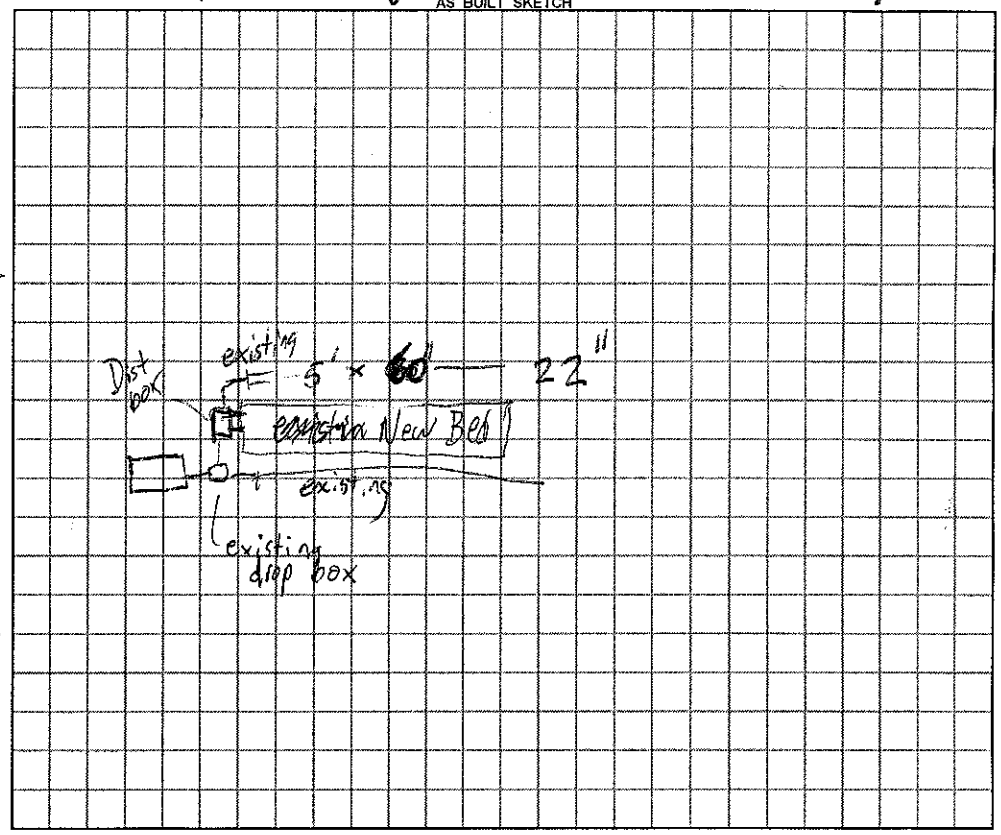

Permit can be suspended or revoked if any false information is supplied toward securing the permit / any unauthorized changes are made to the site / any unauthorized changes are made in the installation of the system.

☐ ***IMPROVEMENT PERMIT*** with plat valid without expiration. ☑ ***IMPROVEMENT PERMIT*** with ~~plat valid without expiration.~~ site plan valid 60 mo. ☑ ***AUTHORIZATION TO CONSTRUCT*** valid for period equal to IMPROVEMENT PERMIT--not to exceed 60 mo.

Owner / Applicant Signature: Sue Ann Stevenson Date 7-31-2012 Installed by: Art Backhoe

IMPROVEMENT PERMIT by: Justin Henderson REHS Date 7-30-12 OPERATION PERMIT by: ____ REHS Date 9-20-12

AUTHORIZATION TO CONSTRUCT by: Justin Henderson REHS Date 7-30-12 Existing System Inspected by: ____ REHS Date ____

YOU SHOULD CONTACT A LOCATOR SERVICE PRIOR TO ANY EXCAVATION

White Copy -- Environmental Health YELLOW COPY (Final) Owner / Applicant PINK COPY (Initial) Owner / Applicant