IREDELL COUNTY HEALTH DEPARTMENT

STATESVILLE 704-878-5305 MOORESVILLE 704-664-5281

IMPROVEMENT PERMIT / CERTIFICATE OF COMPLETION / OPERATION PERMIT / EXISTING SYSTEM INSPECTION

PROPERTY DESCRIPTION NO. 68946 DATE 8-25-97 TAX MAP NO. [redacted] 4715 65 2390 Watershed: ☐ Yes ☐ No

OWNER OR CONTRACTOR Jeffrey A Cook PHONE: Business _____ Home _____ P.T. 873 8516

ADDRESS 540 W Bobbridge Rd

LOCATION 90 W TL Woodbridge Rd sta, T/Hwy PT

SUBDIVISION _____ BLOCK / SECTION _____ LOT _____ LOT AREA 1.7 acres SITE CLASS. PS DESIGN FLOW 480 L.T.A.R. .3

Septic Tank: 1000 Gallons; STB 794 Date 9-4-98

Pump Tank: _____ Gallons; PT _____ Date _____

Pump Make: _____ Model _____ Serial No. _____

Nitrification Field: No Fields 1 Square Feet 1600 Linear Feet 533

No Lines 4 Trench Width 36" Max Trench Bottom Depth 36" Gravel Depth 12"

☑ New System ☐ Repair System Type: I, II, III, IV, V, VI

System Description: Conv. Gravity

Repair System Description: " "

Maintenance Agreement Required: ☐ Yes ☑ No

☐ House/Mod. Home No. Bedrooms 4

☐ Mobile Home No. Bathrooms 2½


☐ Business No. Employees _____

☐ Other _____

☐ Slab ☐ Crawl Space ☑ Basement w/plumbing ☐ Basement wo/plumbing

Water Supply: ☑ Individual ☐ Community ☐ Public

Comments:

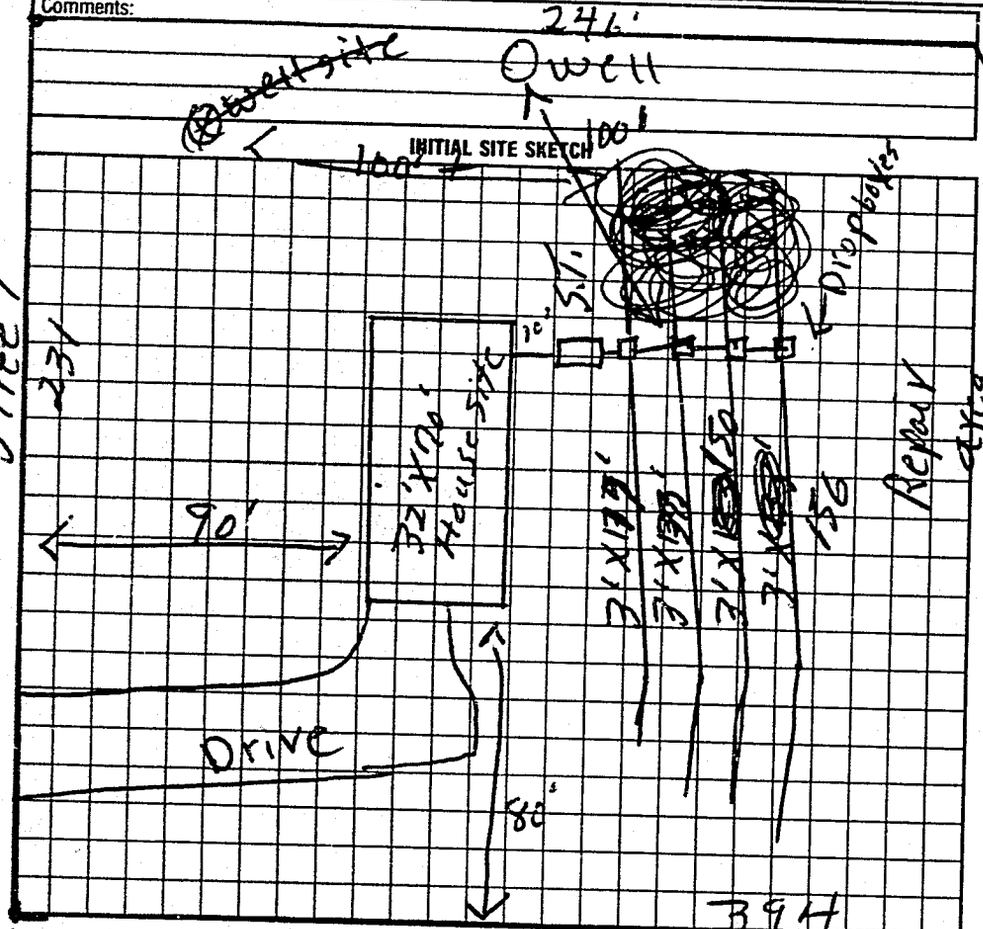

Comments:

AS BUILT SKETCH

Same as initial sketch except S.T. is 50' from House and Lines are as shown

275'

I understand that this permit can be suspended or revoked if any false information is supplied toward securing the permit/any unauthorized changes are made to the site/any unauthorized changes are made in the installation of the system. Improvement Permit is valid for 60 months from date of issuance.

Signed: Sandra L. Cook

Improvement Permit by: L. C. Moore date 8-25-97

~~Existing System Inspection by~~ Authorization L. C. Moore date 8-25-97 to Const.

Installed by: James Hutley

Certificate of Completion by: L. C. Moore date _____

Operation Permit by: _____ date 11-18-98

HEALTH DEPT. COPY: WHITE INSPECTION COPY (FINAL): GREEN OWNER COPY (FINAL): YELLOW INSPECTION COPY (INITIAL): PINK OWNER COPY (INITIAL): GOLD

Authorization to const Expires 60 mos from issue