IREDELL COUNTY HEALTH DEPARTMENT

STATESVILLE 704-878-5305 MOORESVILLE 704-664-5281 54071

IMPROVEMENT PERMIT / CERTIFICATE OF COMPLETION / OPERATION PERMIT / EXISTING SYSTEM INSPECTION

PROPERTY DESCRIPTION NO. 19913 DATE 12/27/94 TAX MAP NO. PART OF 9A-B-13 Watershed: ☐ Yes ☐ No

OWNER OR CONTRACTOR ROBERT S. EARNHARDT JR PHONE: Business Home 873-7581

ADDRESS RT. 8, BOX 483 STATESVILLE, NC 28677

LOCATION NC 90 W, TL WOODBRIDGE ROAD, 2ND LOT ON (R) PAST KIT CARSON ROAD

SUBDIVISION BLOCK / SECTION LOT LOT AREA 2.5 ACRES SITE CLASS. PS DESIGN FLOW 480 L.T.A.R. 0.35 GPD/FT2

Septic Tank: 1000 Gallons; STB 1012 Date 10/14/94

Pump Tank: Gallons; PT Date

Pump Make: Model Serial No.

Nitrification Field: No Fields 1 Square Feet 1380 Linear Feet 460

No Lines 4 Trench Width 36" Max Trench Bottom Depth 18-36" Gravel Depth 12"

☐ New System ☐ Repair System Type: I, II, III, IV, V, VI

System Description: CONVENTIONAL GRAVITY

Repair System Description: CONV. GRAVITY

Maintenance Agreement Required: ☐ Yes ☑ No

☐ House ☑ Mod. Home No. Bedrooms 4

☐ Mobile Home No. Bathrooms 2

☐ Business No. Employees

☐ Other


☐ Slab ☑ Crawl Space ☐ Basement w/plumbing ☐ Basement wo/plumbing

Water Supply: ☐ Individual ☐ Community ☑ Public

Comments: ① KEEP SYSTEM MINIMUM 5' FROM HOUSE 10' FROM PROPERTY LINE, 10' FROM WATER LINE, 100' FROM WELL ② INSTALL LINES AS SHOWN, ON CONTOUR, NO DEEPER THAN 36", 9' APART ON CENTERS

Comments:

INITIAL SITE SKETCH

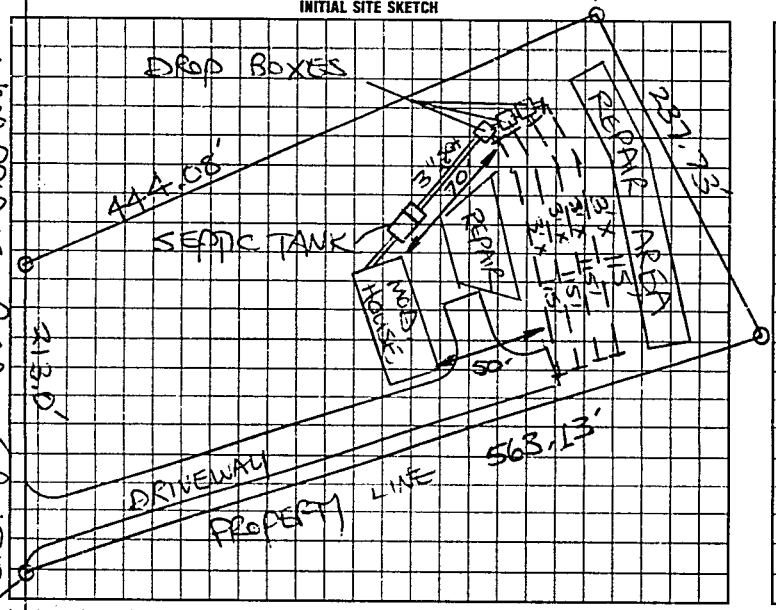

AS BUILT SKETCH

SYSTEM INSTALLED ACCORDING TO INITIAL SITE SKETCH

I understand that this permit can be suspended or revoked if any false information is supplied toward securing the permit/any unauthorized changes are made to the site/any unauthorized changes are made in the installation of the system. Improvement Permit is valid for 60 months from date of issuance.

Signed: Robert S Earnhardt Jr

Improvement Permit by: STEVE HEDRICK date 12/27/94

Existing System Inspection by: date

Installed by: TOMMY FRYE

Certificate of Completion by: STEVE HEDRICK date 1/31/95

Operation Permit by: date

HEALTH DEPT. COPY: WHITE INSPECTION COPY (FINAL): GREEN OWNER COPY (FINAL): YELLOW INSPECTION COPY (INITIAL): PINK OWNER COPY (INITIAL): GOLD

8510000