IREDELL COUNTY HEALTH DEPARTMENT

STATESVILLE 704-878-5305 MOORESVILLE 704-664-5281

IMPROVEMENT PERMIT / AUTHORIZATION TO CONSTRUCT / OPERATION PERMIT / EXISTING SYSTEM INSPECTION

PERMIT# Repair PIN# 4715-68-2256 DATE 7/1/04

OWNER OR CONTRACTOR Stephen Misenheimer PHONE: Business Home (704) 873-9825

ADDRESS 114 Stevenson Farm Rd Statesville N.C. 28625

LOCATION Hwy 90 West, (R) Little Farm Rd, (L) Stevenson Farm Rd, 2nd House on right

SUBDIVISION — BLOCK / SECTION — LOT — LOT AREA 3.75 Ac. SITE CLASS. 15 DESIGN FLOW 240 L.T.A.R.

Septic Tank: Ex. Gallons; STB Date

Pump Tank: Gallons; PT Date

Pump Make: Model Serial No.

Nitrification Field: No Fields 1 Square Feet 800 Linear Feet ~~220~~

No Lines 2@110' Trench Width 36" Max Trench Bottom Depth ~~44~~ Gravel Depth 15"

☐ New System ☒ Repair System Type: I (II) III, IV, V, VI

System Description:

Repair System Description: Gravity Conv.

Maintenance Agreement Required: ☐ Yes ☒ No

☒ House/Mod. Home No. Bedrooms 1

☐ Mobile Home No. Bathrooms

☐ Business No. Employees

☐ Other


☐ Slab ☒ Crawl Space ☐ Basement w/plumbing ☐ Basement wo/plumbing

Water Supply: ☐ Individual ☐ Public ☐ Community


Comments/Conditions: (1) Pump out Septic Tank (2) Replace Supply Lines to New Septic Lines (3) Replace Septic Tee in tank if Needed. (4) This permit serves as N.O.V. 30day to complete repair. (8-1-04)

Comments/Conditions: Tee not replaced, old tee okay

INITIAL SITE SKETCH (Not to scale)

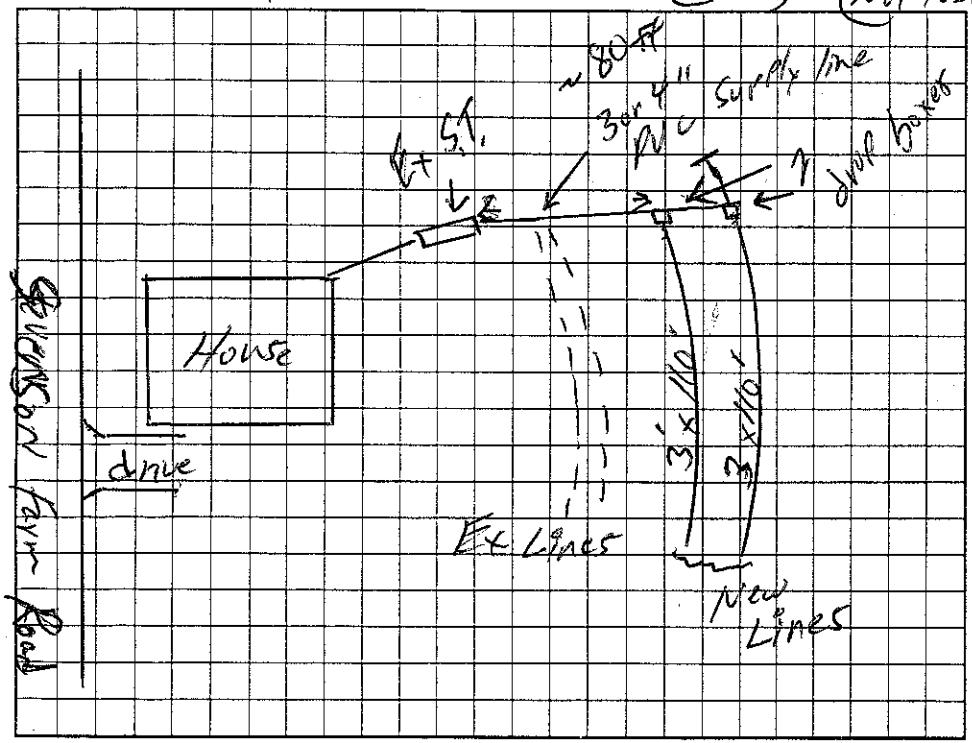

AS BUILT SKETCH

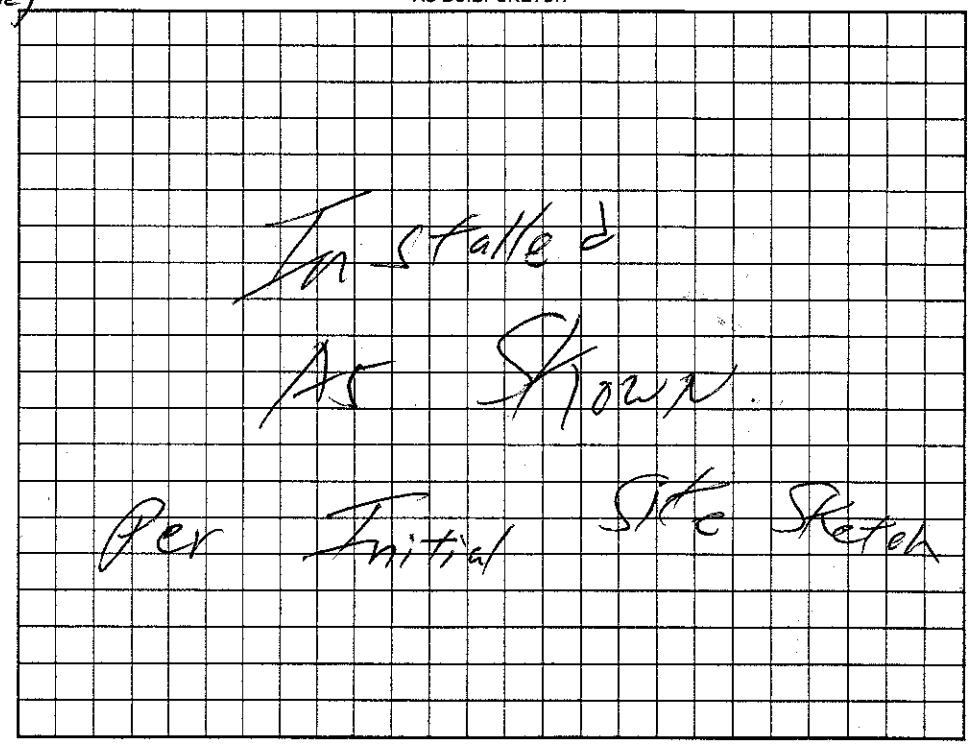

Permit can be suspended or revoked if any false information is supplied toward securing the permit/any unauthorized changes are made to the site/any unauthorized changes are made in the installation of the system. Improvement Permit with plat valid without expiration. Improvement Permit with site plan valid for sixty months. Authorization to Construct is valid for a period equal to that of Improvement Permit – not to exceed sixty months.

Signed: Stephen Misenheimer date 7-1-04 Installed by: Andy Daniels

Improvement Permit by: William O. Johnson date 7/1/04 Operation Permit by: William O. Johnson date 8/17/04

Authorization to Construct by: William O. Johnson date 7/1/04 Existing System Inspection by: date

HEALTH DEPT. COPY: WHITE OWNER COPY (FINAL): YELLOW OWNER COPY (INITIAL): PINK