IREDELL COUNTY HEALTH DEPARTMENT

Statesville Office (704) 878-5305 Mooresville Office (704) 660-3625 PERMIT # 203838

IMPROVEMENT PERMIT / AUTHORIZATION TO CONSTRUCT / OPERATION PERMIT / EXISTING SYSTEM

PIN # 4715682506

APPLICANT: Bruce Massey APPLICANT ADDRESS: 123 Peacock Hollar Rd

PHONE: 704-252-2714 ALT. PHONE: N/A

SITE ADDRESS: 123 Peacock Hollar Rd.

SITE DIRECTIONS: Hwy 90W TR Little Farm Rd TL Peacock Hollar Rd Property on Left.

SUBDIVISION: Concordia Place SECTION: N/A LOT # 16 LOT AREA: 0.35 acres DESIGN FLOW: 360gpd L.T.A.R.: 0.3

Septic Tank 1000 (gal) STB 760 - 1000 Date 7-5

Pump Tank (gal) PT Date

Pump Make Model Serial #

Nitrification Fields 1 # Lines 5 Linear Ft: 300

Trench Width 36" Max. Trench Bottom Depth 36" Gravel Depth N/A

☐ New System ☐ Repair ☐ Expansion System Type: I II ☑ III IV V VI

System Description: 25% Reduction

Repair System Description: 15A NCAC 18A .1945 max. feasible

Maintenance Agreement Required: ☐ YES ☑ NO

☑ GRAVITY ☐ PRESSURE

☑ Residence ☐ Business ☐ Other ☐ Slab ☐ Basement w/plumbing


No. Bedrooms 3 No. Persons 6 No. Employees

☑ Crawl Space ☐ Basement w/o plumbing


Water Supply: ☐ Private ☑ Public ☐ Community

Comments / Conditions: Install a 25% Reduction system on contour with serial distribution. Do NOT Grade for House SITE.

INITIAL SITE SKETCH

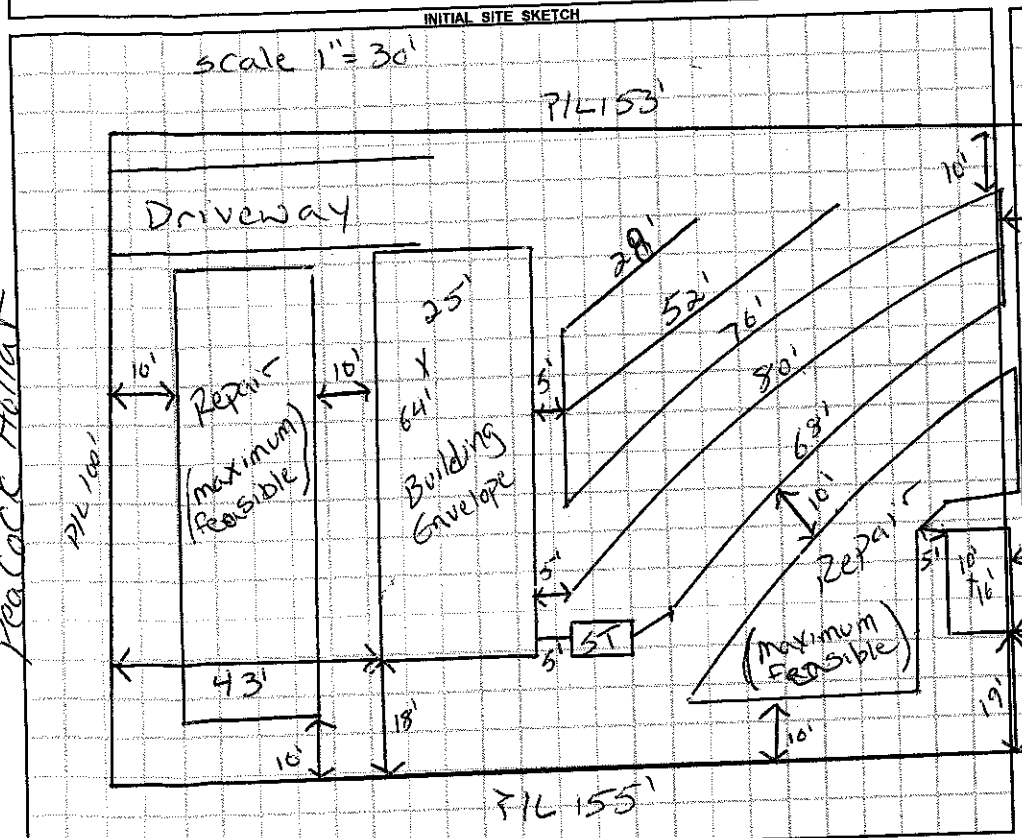

AS BUILT SKETCH

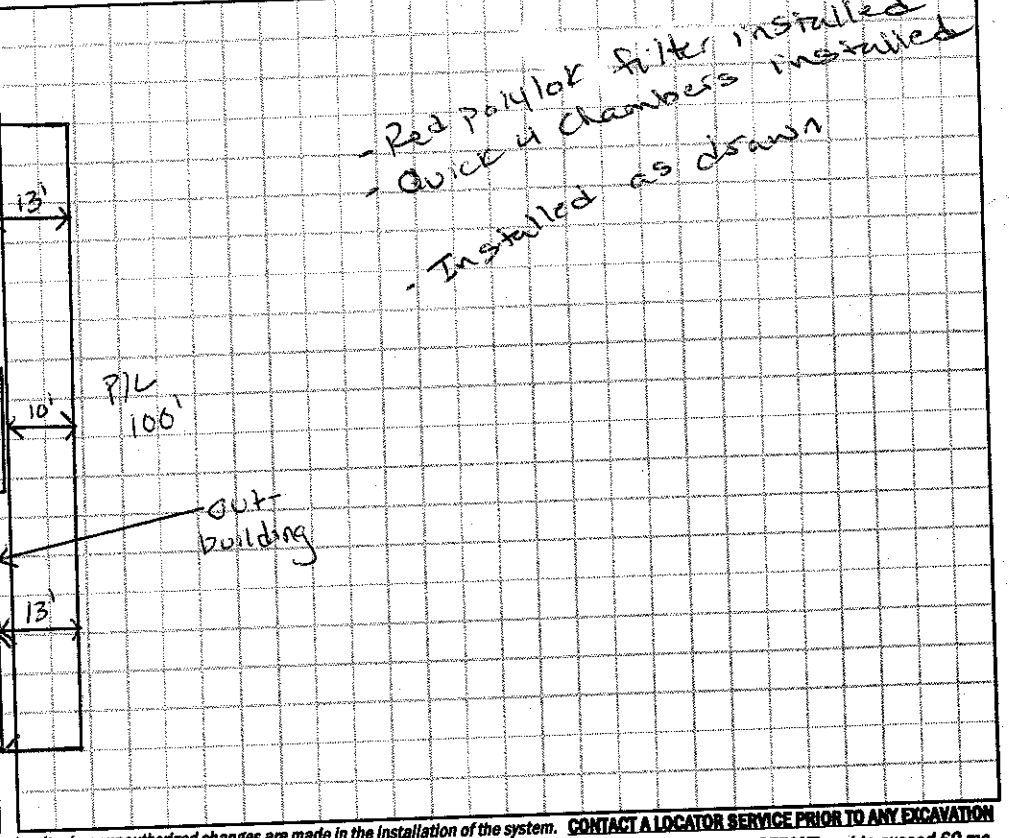

CONTACT A LOCATOR SERVICE PRIOR TO ANY EXCAVATION

Permit can be suspended or revoked if any false information is supplied toward securing the permit / any unauthorized changes are made to the site / any unauthorized changes are made in the installation of the system.

☐ **IMPROVEMENT PERMIT** *with plat valid without expiration.* ☑ **IMPROVEMENT PERMIT** *with site plan valid for 60 mos.* ☑ **AUTHORIZATION TO CONSTRUCT** *valid for period equal to IMPROVEMENT PERMIT--not to exceed 60 mo.*

Owner / Applicant Signature: Andrea Massey Date: 7-2-14 Installed by: A1 - Backhoe

IMPROVEMENT PERMIT by: Justin Henderson Date: 7-2-14 OPERATION PERMIT by: Justin Henderson Date: 10-7-14

AUTHORIZATION TO CONSTRUCT by: Justin Henderson Date: 7-2-14 Existing System Inspected by: Date:

Health Dept. Copy - WHITE Applicant (Final Approval) - YELLOW Applicant (Conditional Approval) - PINK