IREDELL COUNTY HEALTH DEPARTMENT

Statesville Phone TR 3-7271 Mocresville Phone No. 664-5281

PERMIT TO INSTALL SEPTIC TANK

Permit No. 681 Permit Date Aug. 7 1973

Owner Ray Johnson Address Statesville, NC

Installed By York Rutty Address Stony Point, NC

Location of Property 90 W Turn Rt on Rd # 1548 1st Trailer on Lt.


Tank		Capacity		Length of Lines		Fixtures	
Block	( )	1000	( )	225'	(✓)	No. of Baths	(1)
Precast	(✓)	1250	( )	250'	( )	Dishwasher	( )
		1500	( )	Other		Garbage Grdr.	( )
		Other				Other	

Trailer

NOTIFY HEALTH DEPARTMENT AT LEAST EIGHT HOURS BEFORE TANK IS TO BE INSPECTED.

Final Inspection Aug. 7 1973 Approved (✓) Disapproved ( )

Remarks Alexander Water

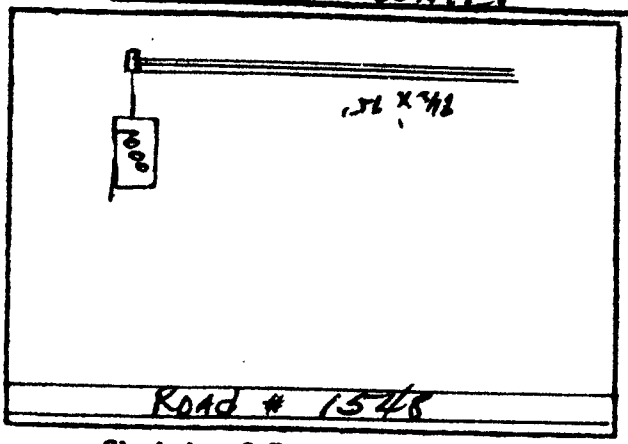

Sketch of Installation

Sanitarian