IREDELL COUNTY HEALTH DEPARTMENT

STATESVILLE 704-878-5305 MOORESVILLE 704-664-5281

IMPROVEMENT PERMIT / CERTIFICATE OF COMPLETION / OPERATION PERMIT / EXISTING SYSTEM INSPECTION

PROPERTY DESCRIPTION NO. 24569 DATE 8-1-96 TAX MAP NO. 9D-12-A-12 Watershed: ☐ Yes ☒ No

OWNER OR CONTRACTOR ARTIS FELTON BROWN PHONE: Business Home 528-5940

ADDRESS 332 WINCHESTER TRAILMAN NC 28166

LOCATION NC 90 W, TR LITTLE FARM RD, TL 1ST CEDAR RIDGE LANE, 2ND LOT ON LEFT

SUBDIVISION CEDAR RIDGE BLOCK / SECTION LOT 12 LOT AREA 1 SITE CLASS. PS DESIGN FLOW 240 L.T.A.R. EXISTING

Septic Tank: EXISTING Gallons; STB Date

Pump Tank: Gallons; PT Date

Pump Make: Model Serial No.

Nitrification Field: No Fields Square Feet Linear Feet EXISTING

No Lines Trench Width Max Trench Bottom Depth Gravel Depth

☐ New System ☐ Repair System Type: ☐ I ☐ II ☐ III ☐ IV ☐ V ☐ VI

System Description: CONV. GRAVITY

Repair System Description:

Maintenance Agreement Required: ☐ Yes ☒ No

☐ Slab ☐ Crawl Space ☐ Basement w/plumbing ☐ Basement wo/plumbing

☐ House/Mod. Home ☒ Mobile Home ☐ Business ☐ Other


No. Bedrooms 3 No. Bathrooms 2 No. Employees

Water Supply: ☐ Individual ☐ Community ☐ Public


Comments:

Comments: ① SYSTEM UNDERSIZED BY TODAYS STANDARDS ② SYSTEM RUNS OUT OF GRADE ③ COLLECTION SEWER NEEDS TO BE REPLACED

INITIAL SITE SKETCH

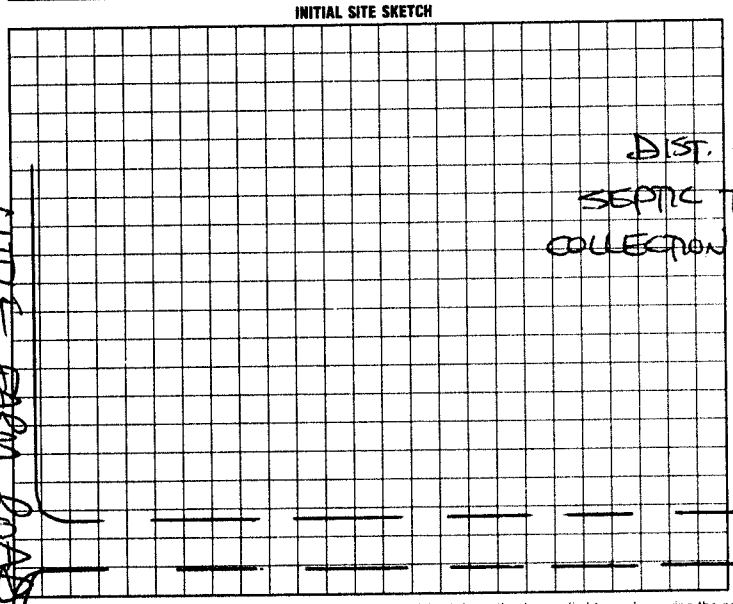

AS BUILT SKETCH

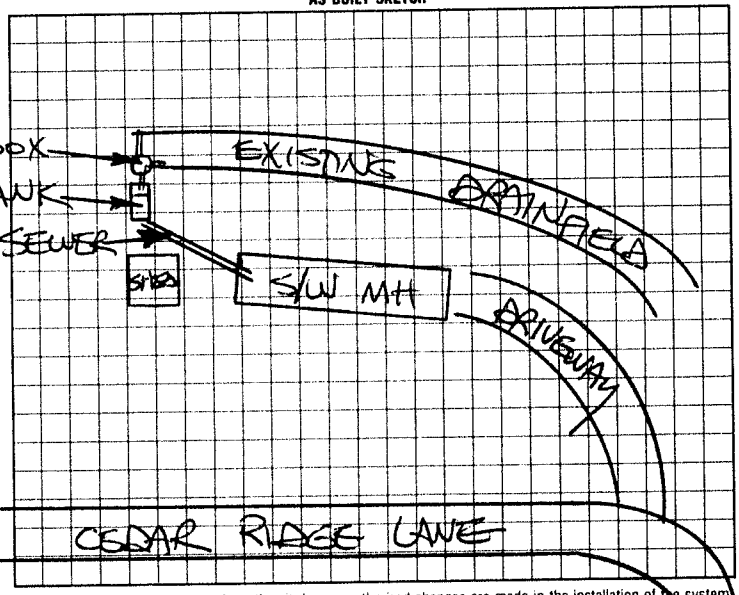

I understand that this permit can be suspended or revoked if any false information is supplied toward securing the permit/any unauthorized changes are made to the site/any unauthorized changes are made in the installation of the system.

Signed:

Improvement Permit by: date

Existing System Inspection by: STEVE HEDRICK date 8-1-96

Installed by:

Certificate of Completion by: date

Operation Permit by: date

HEALTH DEPT. COPY: WHITE INSPECTION COPY (FINAL): GREEN OWNER COPY (FINAL): YELLOW INSPECTION COPY (INITIAL): PINK OWNER COPY (INITIAL): GOLD