1100

IREDELL COUNTY HEALTH DEPARTMENT

Statesville Office (704) 878-5305 Mooresville Office (704) 660-3625 PERMIT # 177166

IMPROVEMENT PERMIT / AUTHORIZATION TO CONSTRUCT / OPERATION PERMIT / EXISTING SYSTEM

PIN # 4715692918

APPLICANT: Tammy M Shepard APPLICANT ADDRESS: 182 Cedar Ridge

SITE ADDRESS: 182 Cedar Ridge Loop PHONE: 704 382 3383 ALT. PHONE:

SITE DIRECTIONS: Old 90 (R) onto Little Farm Rd, (L) onto Cedar Ridge, follow loop around and 182 on (R)

SUBDIVISION: n/a SECTION: n/a LOT # n/a LOT AREA: .64 Acres DESIGN FLOW: 360 L.T.A.R.: .3

Septic Tank	Ex	(gal)	STB		Date						
Pump Tank		(gal)	PT		Date						
Pump Make		Model			Serial #						
# Nitrification Fields	1	# Lines	6		Linear Ft:	270					
Trench Width	36"	Max. Trench Bottom Depth	36"		Gravel Depth	n/a					

☐ New System ☒ Repair ☐ Expansion System Type: I II (III) IV V VI

System Description: 25% Reduction

Repair System Description:

Maintenance Agreement Required: ☐ YES ☒ NO

☐ GRAVITY ☐ PRESSURE

☒ Residence No. Bedrooms 3

☐ Business No. Persons

☐ Other No. Employees

☐ Slab ☒ Crawl Space

☐ Basement w/plumbing ☐ Basement w/o plumbing

Water Supply


☐ Private

☒ Public

☐ Community

Comments / Conditions: Using existing tank, connect to new field lines. 100' of line above system (existing) is reserved to bring system in compliance for 33R. 100' of line above existing system does not need to be installed until that system is to USE

INITIAL SITE SKETCH

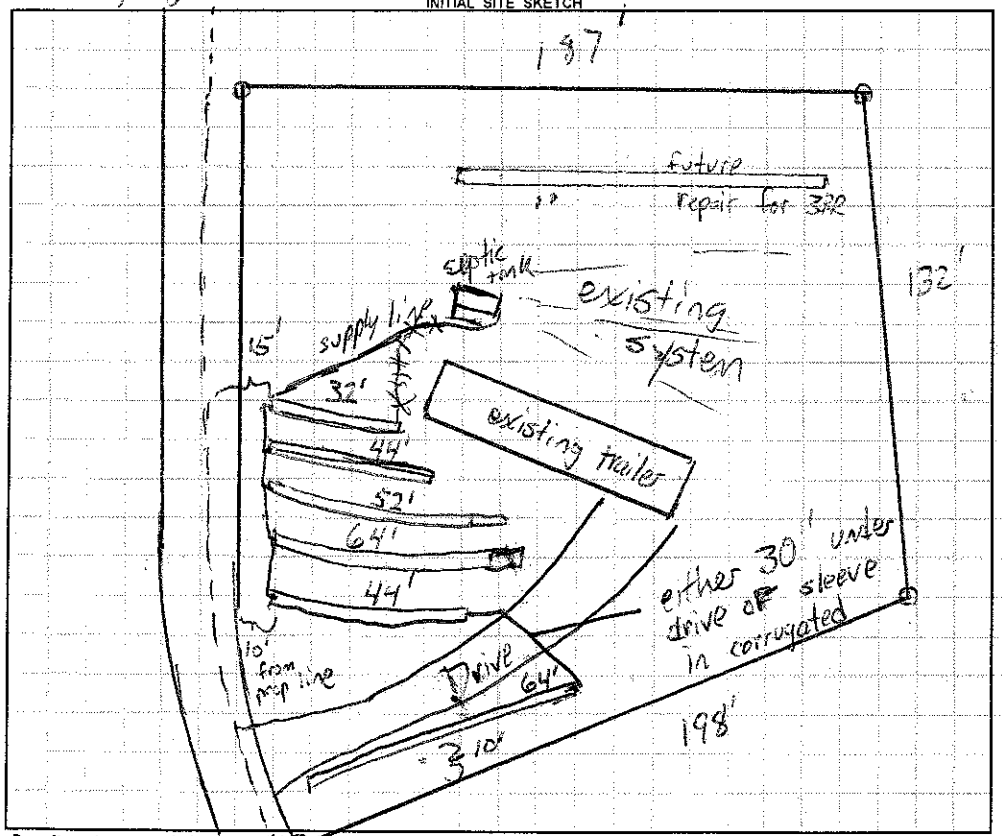

AS BUILT SKETCH

Permit can be suspended or revoked if any false information is supplied toward securing the permit / any unauthorized changes are made to the site / any unauthorized changes are made in the installation of the system. **CONTACT A LOCATOR SERVICE PRIOR TO ANY EXCAVATION**

☐ **IMPROVEMENT PERMIT** *with plat valid without expiration.* ☒ **IMPROVEMENT PERMIT** *with site plan valid for 60 mos.* ☒ **AUTHORIZATION TO CONSTRUCT** *valid for period equal to IMPROVEMENT PERMIT--not to exceed 60 mo.*

Owner / Applicant Signature: Tammy Shepard Date: Installed by: Piedmont Backhoe

IMPROVEMENT PERMIT by: Date: 2-26-13 OPERATION PERMIT by: Date: 3-8-13

AUTHORIZATION TO CONSTRUCT by: Date: 2-26-13 Existing System Inspected by: Date:

Health Dept: Copy - WHITE Applicant (Final Approval) - YELLOW Applicant (Conditional Approval) - PINK