IREDELL COUNTY HEALTH DEPARTMENT

STATESVILLE 704-878-5305 ✓ MOORESVILLE 704-664-5281

IMPROVEMENT PERMIT / AUTHORIZATION TO CONSTRUCT / OPERATION PERMIT / EXISTING SYSTEM INSPECTION

PERMIT# 107070 PIN# 4715-69-5522

OWNER OR CONTRACTOR Phyllis Benton PHONE Business — Home (704) 924-7825 DATE 6/28/02

ADDRESS 151 Cedar Ridge Loop Statesville N.C. 28625

LOCATION Hwy 90 West @ Little Farm Road @ on Cedar Ridge Loop, 4th Lot on Left

SUBDIVISION Cedar Ridge BLOCK / SECTION — LOT 10 LOT AREA .75 Ac. SITE CLASS PS DESIGN FLOW 240 L T A R.

Septic Tank: 1,000 Gallons STB 1007 Date 6-4-02
Pump Tank: Gallons PT Date
Pump Make: Model Serial No
Nitrification Field: No Fields 1 Square Feet 840 to 800 Linear Feet 200
No Lines 4 @ 50' Trench Width 36" Max Trench Bottom Depth 36" Gravel Depth —

X New System Repair System Type I II III IV V
System Description Gravity, 25% Reduction
Repair System Description Gravity, Soil's Rejection
Maintenance Agreement Required: Yes X No

House/Mod Home No. Bedrooms 2
X Mobile Home No. Bathrooms 2
Business No. Employees
Other


Water Supply: ☐ Individual X Public ☐ Community

Slab X Crawl Space Basement w/plumbing Basement wo/plumbing


Comments/Conditions: (1) Install Liner on Contour (2) Install 25% Reduction System (3)

Comments/Conditions: Septic Tank Marker Installed — Polylok Filter Installed — 33 Bio Assister Installed

INITIAL SITE SKETCH (Not to Scale)

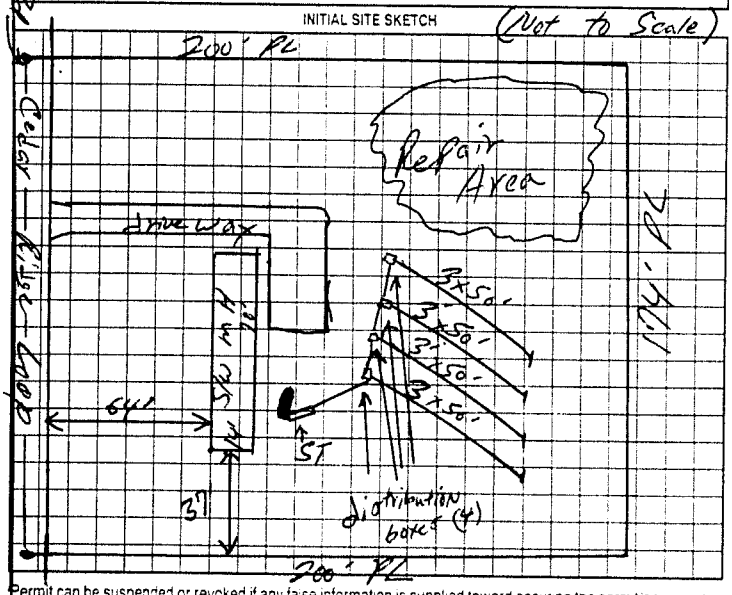

AS BUILT SKETCH

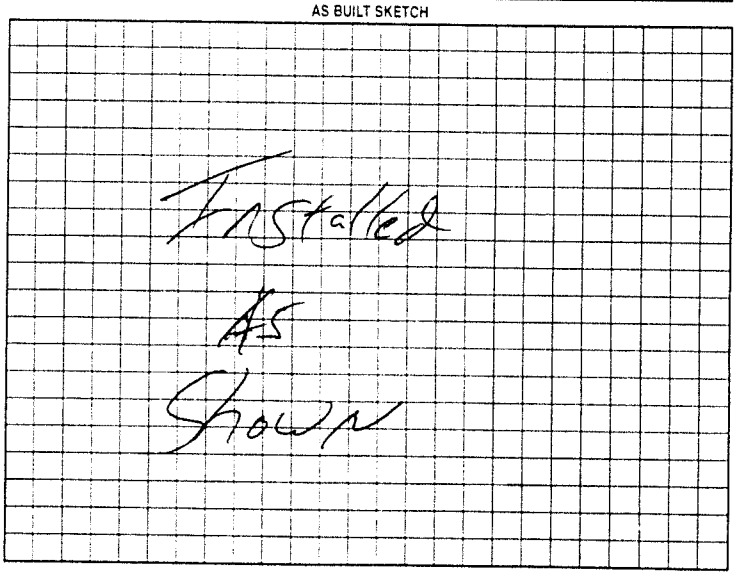

Permit can be suspended or revoked if any false information is supplied toward securing the permit, any unauthorized changes are made to the site, any unauthorized changes are made in the installation of the system. Improvement Permit with plat valid without expiration. Improvement Permit with site plan valid for sixty months. Authorization to Construct is valid for a period equal to that of Improvement Permit - not to exceed sixty months

Signed: Phyllis D. Benton date 7-1-02 Installed by James Husker

Improvement Permit by: William O Johnson date 6/28/02 Operation Permit by William O Johnson date 7/10/02

Authorization to Construct by: William O Johnson date 6/28/02 Existing System Inspection by: — date —

HEALTH DEPT COPY WHITE OWNER COPY (FINAL) YELLOW OWNER COPY (INITIAL) PINK