3'08

IREDELL COUNTY HEALTH DEPARTMENT

STATESVILLE 704-878-5305 (ca) (ar) MOORESVILLE 704-664-5281 A

IMPROVEMENT PERMIT / AUTHORIZATION TO CONSTRUCT / OPERATION PERMIT / EXISTING SYSTEM INSPECTION

PERMIT # 159712 PIN # 4715-34-4471 DATE 19 February 10

OWNER or APPLICANT Phoenix Rising / Ray Short PHONE: Business Cell (704)-202-1366 Home:

OWNER or APPLICANT ADDRESS P.O. Box 3792 Mooresville

LOCATION / DIRECTIONS Township Hwy Two North from Two into Statesville TR Crythogn-TL Nat Fnds

SUBDIVISION Castlegate BLOCK / SECTION LOT # 56 LOT AREA 0.47ac DESIGN FLOW 360.0 L.T.A.R. 0.5 Attd

Septic Tank 1000 Gallons: STB Date

Pump Tank Gallons: P T Date

Pump Make Model Serial #

Nitrification Field No Fields 1 No Lines 4 Linear Feet 300

Trench Width 36" Max. Trench Bottom Depth 36" Gravel Depth NA

☑ New System ☐ Repair ☐ Expansion System Type I II III IV V VI

System Description: 25% Reduction

Repair System Description: 50 % Reduction

Maintenance Agreement Required ☐ YES ☐ NO

☑ GRAVITY ☐ PRESSURE

☑ Residence No. Bedrooms 3

☐ Business No. Persons

☐ Other No. Employees

☐ Slab ☑ Crawl Space


☐ Basement w/plumbing ☐ Basement w/o plumbing

Water Supply: ☐ Private ☑ Public ☐ Community


Comments / Conditions

Comments / Conditions Poly Lock Felt - Installed

INITIAL SITE SKETCH

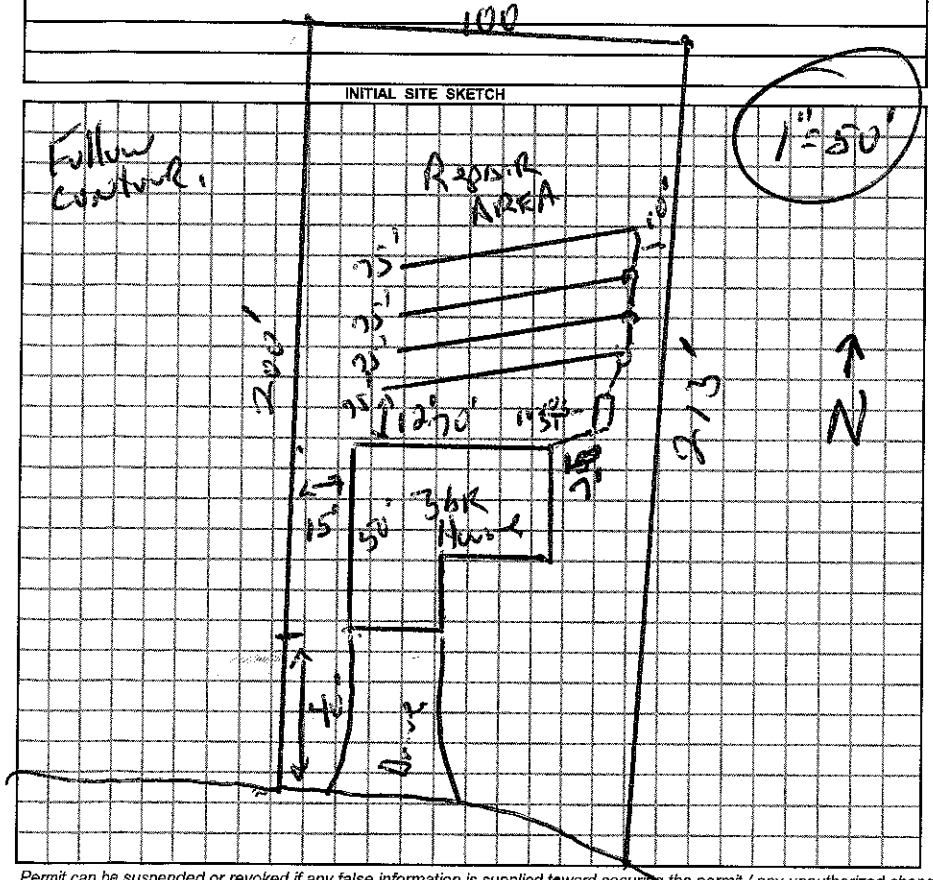

AS BUILT SKETCH

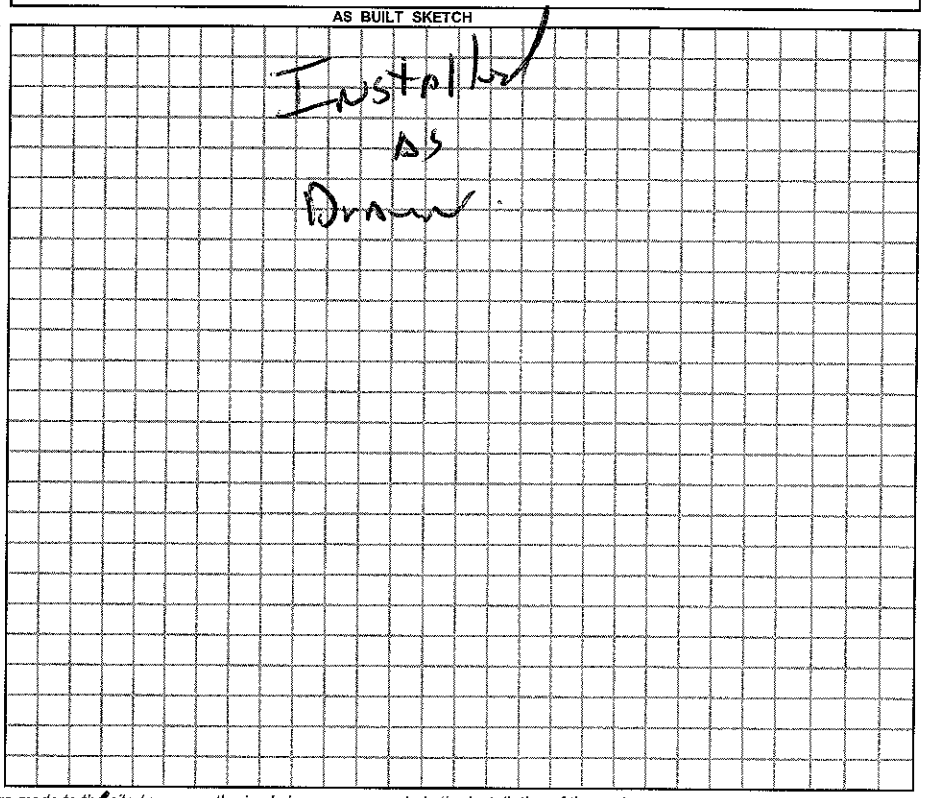

Permit can be suspended or revoked if any false information is supplied toward securing the permit / any unauthorized changes are made to the site / any unauthorized changes are made in the installation of the system.

☐ *IMPROVEMENT PERMIT w / plat valid without expiration.* ☑ *IMPROVEMENT PERMIT w / site plan valid for 60 mos.* ☑ *AUTHORIZATION TO CONSTRUCT valid for period equal to IMPROVEMENT PERMIT-not to exceed 60 mo.*

Owner / Applicant Signature: Date 2/19/10

Improvement Permit by: R.S. Date 19 Feb. 10

Authorization to Construct by: R.S. Date 19 Feb. 10

Installed by: Chris Gunter

Operation Permit by: R.S. Date: 14 April 10

Existing System Inspected by: Date:

YOU SHOULD CONTACT A LOCATOR SERVICE PRIOR TO ANY EXCAVATION.

WHITE COPY Environmental Health YELLOW COPY (Final) Owner / Applicant PINK COPY (Initial) Owner / Applicant