Site address: 179 Greythorn Dr., Statesville

IREDELL COUNTY HEALTH DEPARTMENT

STATESVILLE 704-878-5305 (AW) (AR) MOORESVILLE 704-664-5281

IMPROVEMENT PERMIT / AUTHORIZATION TO CONSTRUCT / OPERATION PERMIT / EXISTING SYSTEM INSPECTION

PERMIT # 160221 PIN # 4715-75-6653 DATE 11 MARCH 10

OWNER or APPLICANT Michael Lovan PHONE: ~~Business~~ Cell (704) 902-6866 Home:

OWNER or APPLICANT ADDRESS PO Box 1717 Statesville

LOCATION / DIRECTIONS Taylorsville Hwy TL Absher Farm LN TL Staffordshire TR Greythorn Lot on left.

SUBDIVISION Castlegate BLOCK / SECTION LOT # 44 LOT AREA 0.41 ac. DESIGN FLOW 360 g/d L.T.A.R. 0.3 g/Ft²/d

Septic Tank 1000 Gallons: STB 1012 Date 10-3-07

Pump Tank Gallons: PT Date

Pump Make Model Serial #

Nitrification Field No Fields 1 No Lines 4 Linear Feet 300

Trench Width 36" Max. Trench Bottom Depth 24" Gravel Depth NA

☑ New System ☐ Repair ☐ Expansion System Type I II (III) IV V VI

System Description: 25% Reduction

Repair System Description: 25% Reduction

Maintenance Agreement Required ☐ YES ☑ NO

☑ GRAVITY ☐ PRESSURE

☑ Residence No. Bedrooms 3

☐ Business No. Persons

☐ Other No. Employees

☐ Slab ☑ Crawl Space


☐ Basement w/plumbing ☐ Basement w/o plumbing

Water Supply: ☐ Private ☑ Public ☐ Community


Comments / Conditions: Follow contour
* 24" maximum trench depth

Comments / Conditions

INITIAL SITE SKETCH

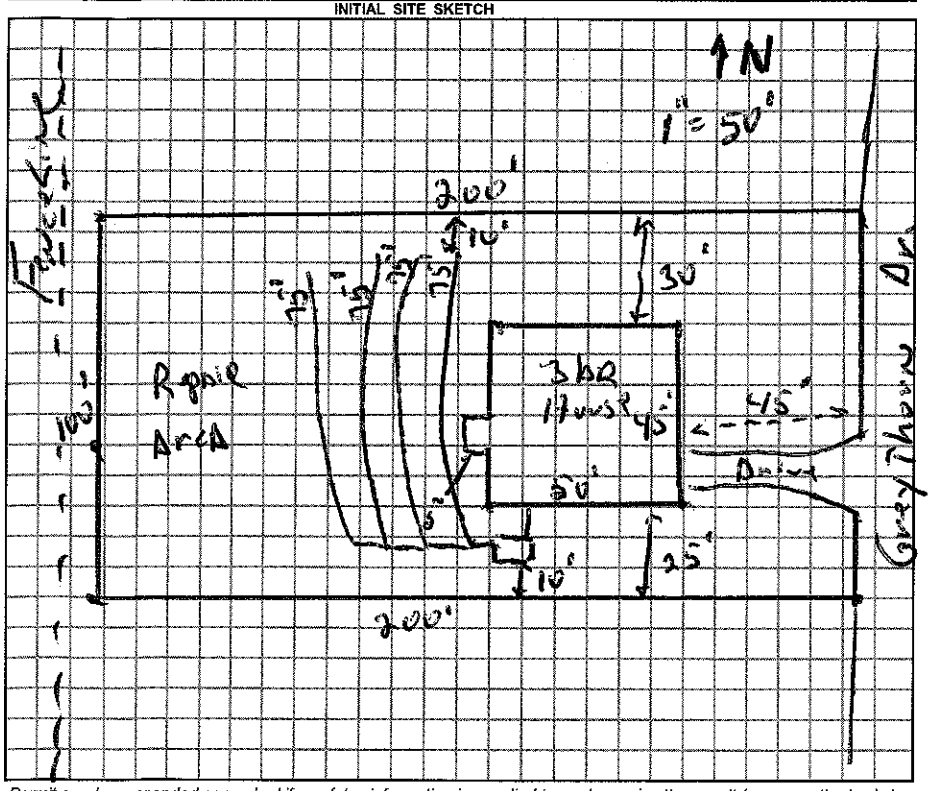

AS BUILT SKETCH

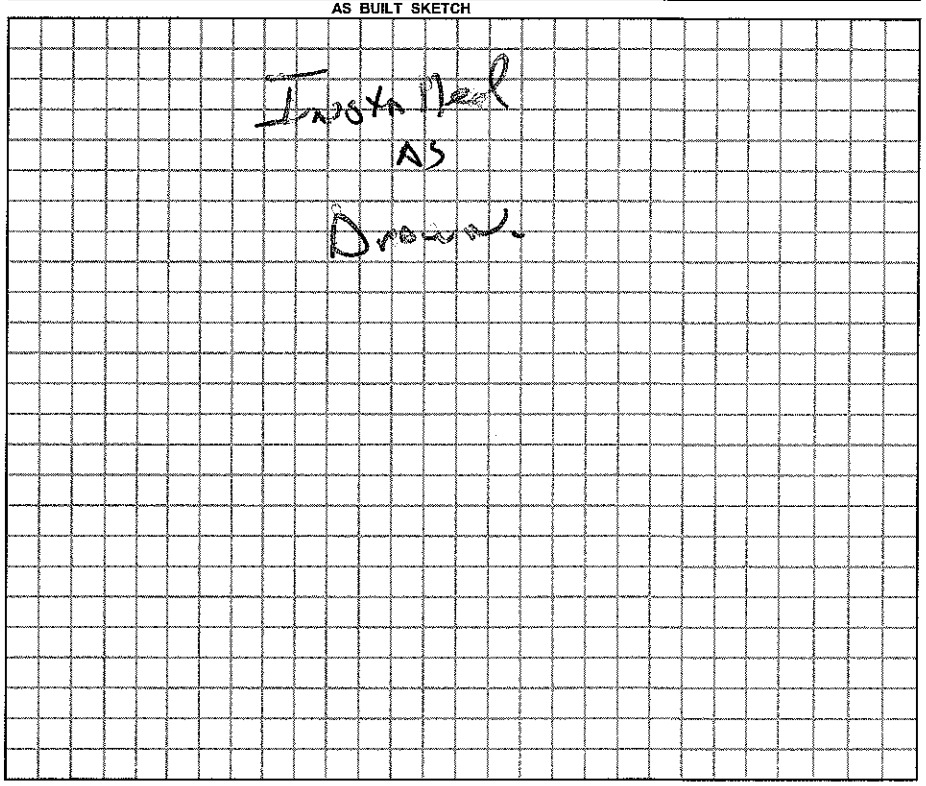

Permit can be suspended or revoked if any false information is supplied toward securing the permit / any unauthorized changes are made to the site / any unauthorized changes are made in the installation of the system.

☐ *IMPROVEMENT PERMIT w / plat valid without expiration.* ☑ *IMPROVEMENT PERMIT w / site plan valid for 60 mos.* ☑ *AUTHORIZATION TO CONSTRUCT valid for period equal to IMPROVEMENT PERMIT-not to exceed 60 mo.*

Owner / Applicant Signature: Date 17 March 10

Improvement Permit by: , R.S. Date 16 March 10

Authorization to Construct by: , R.S. Date 16 March 10

Installed by: Gunter Grading

Operation Permit by: , R.S. Date: 11 May 10

Existing System Inspected by: Date:

YOU SHOULD CONTACT A LOCATOR SERVICE PRIOR TO ANY EXCAVATION.

WHITE COPY Environmental Health YELLOW COPY (Final) Owner / Applicant PINK COPY (Initial) Owner / Applicant