IREDELL COUNTY HEALTH DEPARTMENT

STATESVILLE 704-878-5305 MOORESVILLE 704-664-5281

IMPROVEMENT PERMIT / AUTHORIZATION TO CONSTRUCT / OPERATION PERMIT / EXISTING SYSTEM INSPECTION

PERMIT # 156532 PIN # 4715-75-9984 DATE 5 June 09

OWNER or APPLICANT Mid-Atlantic Custom Builders, Inc. PHONE: Business (828) 478-2761 Home:

OWNER or APPLICANT ADDRESS P.O. Box 3792 Mooresville, N.C.

LOCATION / DIRECTIONS Taylorsville Hwy. TL Absher Farm Lp. TL Staffordshire TR Greythorn - on Rt. At end.

SUBDIVISION Castlegate BLOCK / SECTION LOT # 38 LOT AREA 0.588ac. DESIGN FLOW 360gpd L.T.A.R. 0.3gpd/ft²

Septic Tank 1000 Gallons: STB 1012 Date 4-22-08
Pump Tank Gallons: P T Date
Pump Make Model Serial #
Nitrification Field No Fields 1 No Lines 4 Linear Feet 300
Trench Width 36" Max. Trench Bottom Depth 36" Gravel Depth N/A

☑ New System ☐ Repair ☐ Expansion System Type I II ☑III IV V VI
System Description: 25% Reduction
Repair System Description: 50% Reduction · LPP
Maintenance Agreement Required ☐ YES ☑ NO
☑ GRAVITY ☐ PRESSURE

☑ Residence No. Bedrooms 3
☐ Business No. Persons
☐ Other No. Employees
☐ Slab ☑ Crawl Space
☐ Basement w/plumbing ☐ Basement w/o plumbing

Water Supply: ☐ Private ☑ Public ☐ Community


Comments / Conditions: Follow contour / Honor all setback requirements. /

Comments / Conditions: Polylock filter
Bio-Filter Arc 36

INITIAL SITE SKETCH

Please see Attached site sketch.

AS BUILT SKETCH

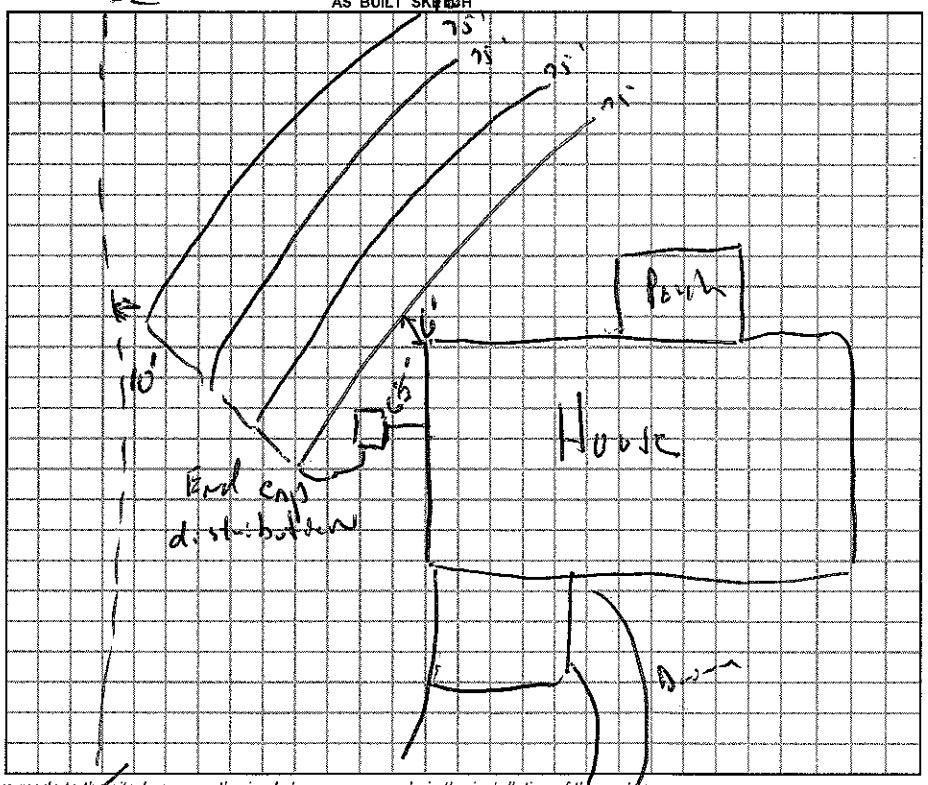

Permit can be suspended or revoked if any false information is supplied toward securing the permit / any unauthorized changes are made to the site / any unauthorized changes are made in the installation of the system.

☐ *IMPROVEMENT PERMIT w / plat valid without expiration.* ☑ *IMPROVEMENT PERMIT w / site plan valid for 60 mos.* ☑ *AUTHORIZATION TO CONSTRUCT valid for period equal to IMPROVEMENT PERMIT-not to exceed 60 mo.*

Owner / Applicant Signature: Date 6/8/09

Improvement Permit by: , R.S. Date 5 June 09

Authorization to Construct by: , R.S. Date 5 June 09

Installed by: Greywood Excavating

Operation Permit by: , R.S. Date: 9 September 09

Existing System Inspected by: Date:

YOU SHOULD CONTACT A LOCATOR SERVICE PRIOR TO ANY EXCAVATION.

WHITE COPY Environmental Health YELLOW COPY (Final) Owner / Applicant PINK COPY (Initial) Owner / Applicant