IREDELL COUNTY HEALTH DEPARTMENT

STATESVILLE 704-878-5305 MOORESVILLE 704-664-5281

IMPROVEMENT PERMIT / AUTHORIZATION TO CONSTRUCT / OPERATION PERMIT / EXISTING SYSTEM INSPECTION

PERMIT # 16202 PIN # 4715-77-4035 DATE 3 August 10

OWNER or APPLICANT Saul Pedroza PHONE: Business Home: (704) 437-5142

OWNER or APPLICANT ADDRESS P.O. Box 144 Hiddenite

LOCATION / DIRECTIONS Taylorsville Hwy TL Snowbird Loop. Lot on Left.

SUBDIVISION BLOCK / SECTION LOT # 38-41 LOT AREA 0.5ac. DESIGN FLOW 240gpd L.T.A.R.

Septic Tank Exist. Gallons: STB Date

Pump Tank Gallons: P T Date

Pump Make Model Serial #

Nitrification Field No Fields No Lines Linear Feet Ex. ST.

Trench Width Exist Max. Trench Bottom Depth Gravel Depth

☐ New System ☐ Repair ☐ Expansion System Type I II III IV V VI

System Description: Conventional

Repair System Description:

Maintenance Agreement Required ☐ YES ☑ NO

☑ GRAVITY ☐ PRESSURE

☑ Residence No. Bedrooms 2

☐ Business No. Persons

☐ Other No. Employees

☐ Slab ☑ Crawl Space

☐ Basement w/plumbing ☐ Basement w/o plumbing


Water Supply: ☐ Private ☑ Public ☐ Community

Comments / Conditions

Comments / Conditions

INITIAL SITE SKETCH

AS BUILT SKETCH

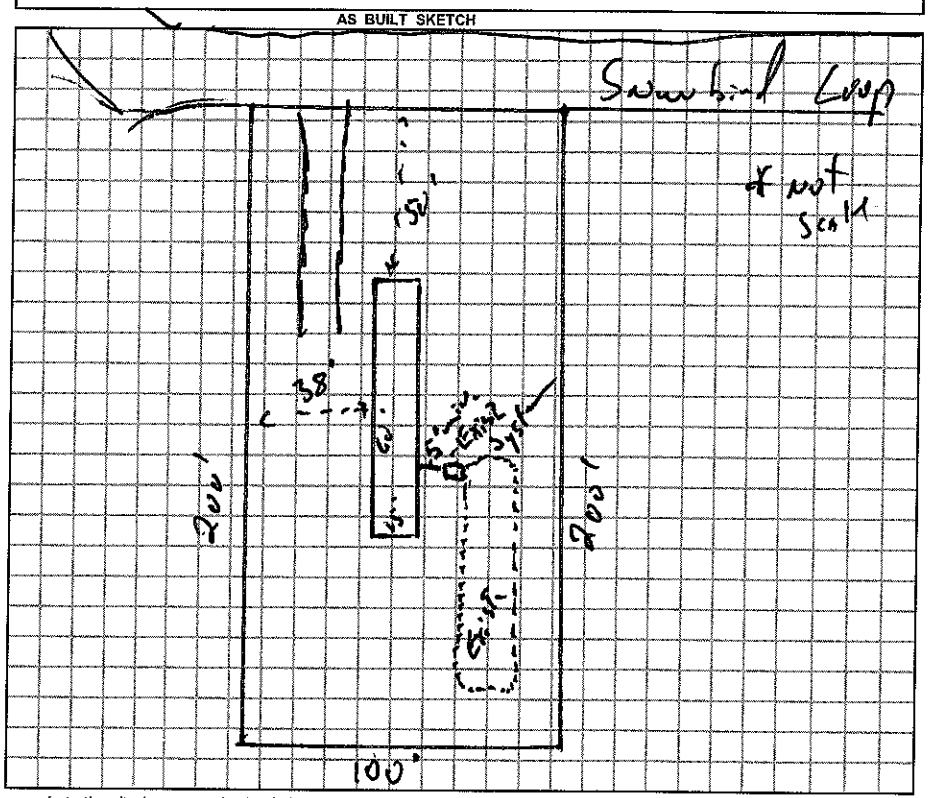

Permit can be suspended or revoked if any false information is supplied toward securing the permit / any unauthorized changes are made to the site / any unauthorized changes are made in the installation of the system.

☐ *IMPROVEMENT PERMIT w / plat valid without expiration.* ☐ *IMPROVEMENT PERMIT w / site plan valid for 60 mos.* ☐ *AUTHORIZATION TO CONSTRUCT valid for period equal to IMPROVEMENT PERMIT-not to exceed 60 mo.*

Owner / Applicant Signature: Date

Improvement Permit by: Date

Authorzation to Construct by: Date

YOU SHOULD CONTACT A LOCATOR SERVICE PRIOR TO ANY EXCAVATION.

Installed by:

Operation Permit by: Date:

Existing System Inspected by: R.S. Date: 3 Aug. 10

WHITE COPY Environmental Health YELLOW COPY (Initial) Owner / Applicant PINK COPY (Initial) Owner / Applicant