IREDELL COUNTY HEALTH DEPARTMENT

STATESVILLE 704-878-5305 MOORESVILLE 704-664-5281

Expansion

IMPROVEMENT PERMIT / AUTHORIZATION TO CONSTRUCT / OPERATION PERMIT / EXISTING SYSTEM INSPECTION

PERMIT# 89887 PIN# 4715793040

OWNER OR CONTRACTOR TERRY SPARKMAN PHONE: Business _____ DATE June 26 2000

ADDRESS 174 Little Farm Rd Statesville Home 873-8864

LOCATION Scotts Creek & Little Farm Toward end on left Torley Lane 1st home on Right

SUBDIVISION _____ BLOCK / SECTION _____ LOT _____ LOT AREA 2.2 Ac SITE CLASS P5 DESIGN FLOW 480 L.T.A.R. .35

Septic Tank: Existing 1000 Gallons; STB _____ Date _____

Pump Tank: _____ Gallons; PT _____ Date _____

Pump Make: _____ Model _____ Serial No. _____

Nitrification Field: No Fields 1 Square Feet _____ Linear Feet _____

No Lines 5 TOTAL Trench Width 24" Max Trench Bottom Depth 36" Gravel Depth N/A

☐ New System ☐ Repair System Type: I, II, III, IV, V, VI

System Description: GRAVITY, 50% Reduction

Repair System Description: _____

Maintenance Agreement Required: ☐ Yes ☒ No

☐ House/Mod. Home ☒ Mobile Home S.W. ☐ Business ☐ Other _____

No. Bedrooms 4 No. Bathrooms 2 No. Employees _____


☐ Slab ☒ Crawl Space ☐ Basement w/plumbing ☐ Basement wo/plumbing

Water Supply: ☐ Individual ☒ Public ☐ Community


Comments:/Conditions: INSTALL TOTAL of 25 PANELS ACCORDING TO MANUFACTURER SPECIFICATIONS, USE 18¼ TON STAND Keep min. 50FT from well

Comments:/Conditions: Single wide home is to be Removed
6.28 1st Line to DistBox inspected
6.30

INITIAL SITE SKETCH

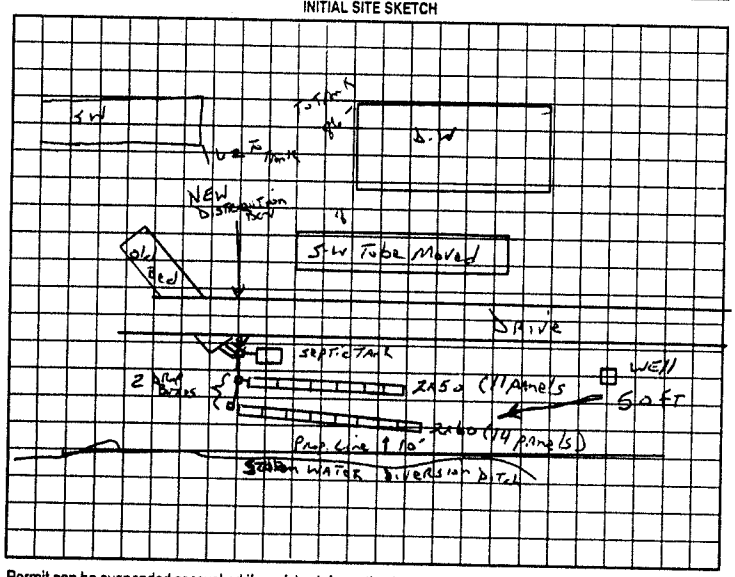

AS BUILT SKETCH

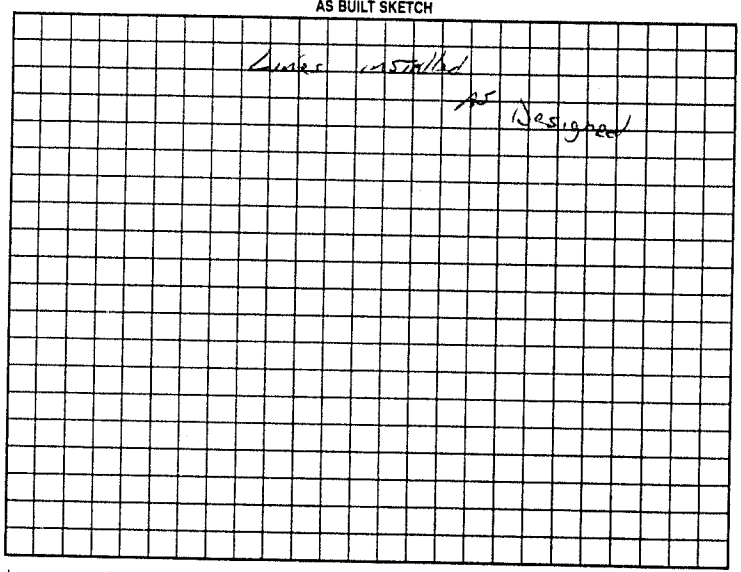

Permit can be suspended or revoked if any false information is supplied toward securing the permit/any unauthorized changes are made to the site/any unauthorized changes are made in the installation of the system. Improvement Permit with plat valid without expiration. Improvement Permit with site plan valid for sixty months. Authorization to Construct is valid for a period equal to that of Improvement Permit – not to exceed sixty months.

Signed: Terry Sparkman date June 26 2000 Installed by: TERRY SPARKMAN

Improvement Permit by: jc Potter date June 26 2000 Operation Permit by: jc Potter date June 30 2000

Authorization to Construct by: jc Potter date June 26 2000 Existing System Inspection by: _____ date _____

HEALTH DEPT. COPY: WHITE OWNER COPY (FINAL): YELLOW OWNER COPY (INITIAL): PINK