IREDELL COUNTY HEALTH DEPARTMENT

Statesville Phone TR 3-7271 Mooresville Phone NO 3-1271

PERMIT TO INSTALL SEPTIC TANK

Permit No. 204 Permit Date 3/24 19 71

Owner Dan McKinney Address Statesville, NC

Installed By H.L. Hedrick Address Statesville NC


Location of Property W. on Hwy #90 to road 1548 Turn right. 1st gravel drive on right. No trailer on site yet. No well yet.

Tank		Capacity		Length of Lines		Fixtures	
Block	( )	1000	( )	225'	( )	No. of Baths	( ) ?
Precast	( )	1250	( )	250'	( )	Dishwasher	( )
		1500	( )	Other		Garbage Grdr.	( )
		Other				Other	

NOTIFY HEALTH DEPARTMENT AT LEAST EIGHT HOURS BEFORE TANK IS TO BE INSPECTED.

Final Inspection 3-24-1971 Approved ( ) Disapproved ( )

Remarks

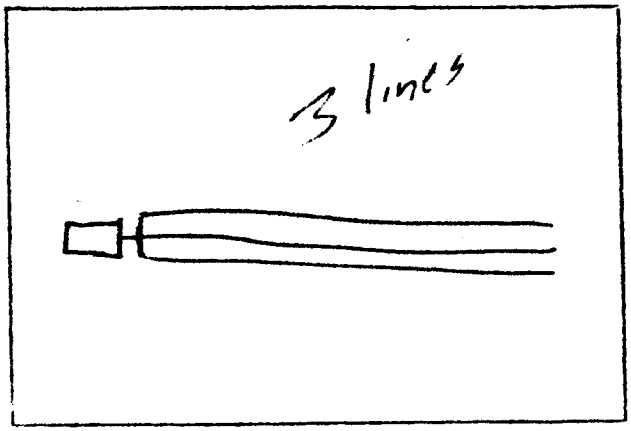

Sketch of Installation

Cross S. Hall

Sanitarian