IREDELL COUNTY HEALTH DEPARTMENT

STATESVILLE 704-878-5305 MOORESVILLE 704-664-5281

IMPROVEMENT PERMIT / AUTHORIZATION TO CONSTRUCT / OPERATION PERMIT / EXISTING SYSTEM INSPECTION

PERMIT# 088211 PIN# 4715 79 3915 DATE 3-28-00

OWNER OR CONTRACTOR DONALD WILLIAMS PHONE: Business Home (828) 635-0590

ADDRESS 27 NORTHSIDE DRIVE, HIDDENITE, NC 28636

LOCATION NC 90 W, TR LITTLE FARM ROAD, 3RD LOT ON LEFT BEFORE 2ND CEDAR RIDGE ENTRANCE

SUBDIVISION CEDAR RIDGE BLOCK / SECTION II LOT 48 LOT AREA 1.3346 AC SITE CLASS PS DESIGN FLOW 360 L.T.A.R. 0.25 GPD/FT²

Septic Tank: 1000 Gallons; STB 1012 Date 12-9-99
Pump Tank: _____ Gallons; PT _____ Date _____
Pump Make: _____ Model _____ Serial No. _____
Nitrification Field: No Fields 1 Square Feet 1440 Linear Feet 480
No Lines SIX Trench Width 36" Max Trench Bottom Depth 36" Gravel Depth 12"

☑ New System ☐ Repair System Type: I II III IV V VI
System Description: CONVENTIONAL GRAVITY
Repair System Description: CONV. GRAVITY
Maintenance Agreement Required: ☐ Yes ☑ No

☐ House/Mod. Home ☑ Mobile Home ☐ Business ☐ Other
No. Bedrooms 3 No. Bathrooms 2 No. Employees ____


☐ Slab ☑ Crawl Space ☐ Basement w/plumbing ☐ Basement wo/plumbing

Water Supply: ☐ Individual ☐ Public ☐ Community


Comments/Conditions: INSTALL LINES ON CONTOUR AS FLAGGED
SEPTIC TANK
FLOW DIVIDER

Comments/Conditions: SEPTIC TANK W/ RISERS INSTALLED USING "POLY LOK" FILTERS

INITIAL SITE SKETCH SCALE: 1" = 50'

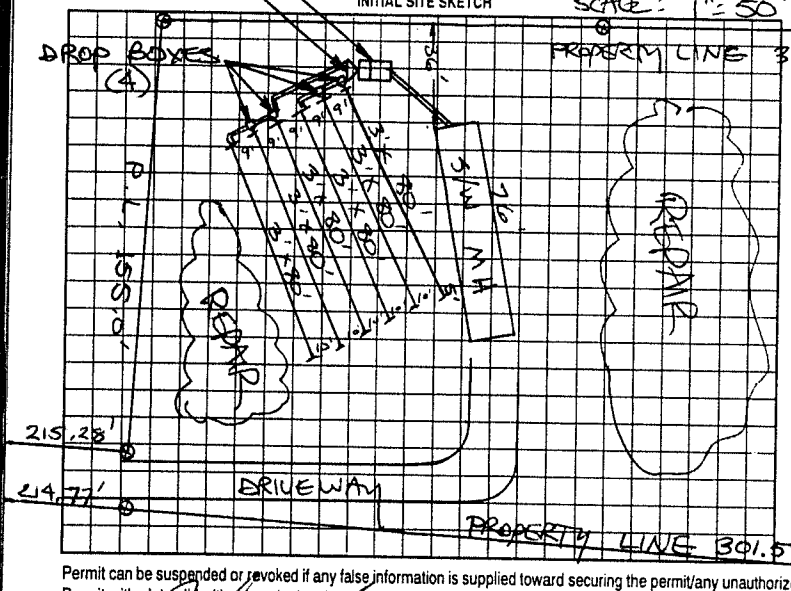

AS BUILT SKETCH

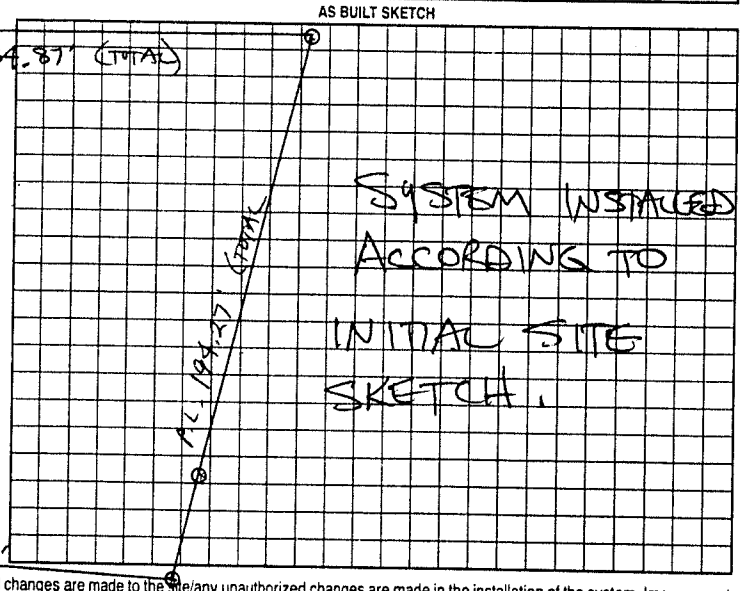

Permit can be suspended or revoked if any false information is supplied toward securing the permit/any unauthorized changes are made to the site/any unauthorized changes are made in the installation of the system. Improvement Permit with plat valid without expiration. Improvement Permit with site plan valid for sixty months. Authorization to Construct is valid for a period equal to that of Improvement Permit – not to exceed sixty months.

Signed: John Varley date 3-28-00 Installed by: A-1 BACKHOE

Improvement Permit by: STEVE HENDRICK date 3-28-00 Operation Permit by: STEVE HENDRICK date 3-31-00

Authorization to Construct by: STEVE HENDRICK date 3-28-00 Existing System Inspection by: _____ date _____

HEALTH DEPT. COPY: WHITE OWNER COPY (FINAL): YELLOW OWNER COPY (INITIAL): PINK