ICHD - ENVIRONMENTAL HEALTH DIVISION

Statesville Office (704) 878-5305 Mooresville Office (704) 660-3625 PERMIT # AP 309488.

SEPTIC: IMPROVEMENT PERMIT / AUTHORIZATION TO CONSTRUCT / OPERATION PERMIT / EXISTING SYSTEM

PIN # 4715 --84 --2811 2761

APPLICANT/OWNER: Castlegate LLC APPLICANT ADDRESS: 7271 Long Island Rd Catawba NC

SITE ADDRESS: 189 Staffordshire Drive Statesville NC 28625 PHONE: ALT. PHONE

SITE DIRECTIONS: RT 64 RT 90 Ashes Farm Loop Staffordshire SAP CONTROLLED: ☒ YES ☐ NO

SUBDIVISION: Castlegate SECTION: - LOT # 117 LOT AREA: .6 Acres DESIGN FLOW: 360 L.T.A.R.: .30

Septic Tank	1000	(gal)	STB SHOAF760	Date 2-26	☒ New System	☐ Repair	☐ Expansion	System Type: I II III IV V VI	☒ Residence	No. Bedrooms 3	Water Supply
Pump Tank		(gal)	PT	Date	System Description: Gravity - 25% Reduction				☐ Business	No. Persons 6	☐ Private
Pump Make		Model		Serial #	Repair System Description: LPD - 50% Reduction				☐ Other	No. Employees	☒ Public
# Nitrification Fields	1	# Lines	5	Linear Ft. 300	Maintenance Agreement Required:	☐ YES	☒ NO		☐ Slab	☒ Crawl Space	☐ Community
Trench Width	36	Trench Bottom Depth (below grade)	30in	Gravel Depth -		☒ GRAVITY	☐ PRESSURE		☐ Basement w/ plumbing	☐ Basement w/o plumbing	

Comments / Conditions:

INITIAL SITE SKETCH

This permit is issued pursuant to Section 11 . (C) of S.L. 2018-114 using the signed and sealed LSS Evaluation by:

The Davis Group PA

LSS # 1313 April 15, 2021

AS BUILT SKETCH

FOR SEPTIC FINAL INSPECTION CALL: 704-664-3703 between 8am-9am the day the inspection is needed. Be sure to speak with an inspector to confirm your time.

As Built Attached

Permit can be ... changes are made to the site / any unauthorized changes are made in the installation of the system. **CONTACT A LOCATOR SERVICE PRIOR TO ANY EXCAVATION**

☐ **IMPROVEMENT PERMIT** *with plat valid without expiration.* ☒ **IMPROVEMENT PERMIT** *with site plan valid for 60 mos.* ☒ **AUTHORIZATION TO CONSTRUCT** *valid for period equal to IMPROVEMENT PERMIT--not to exceed 60 mo.*

Owner / Applicant Signature: Date: 4-28-21 Installed by: Rowan Septic

IMPROVEMENT PERMIT by: Date: 4-26-2021 OPERATION PERMIT by: D. Wiebers Date: 4/29/21

AUTHORIZATION TO CONSTRUCT by: Date: 4/28-22 Existing System Inspected by: Date:

FOR SEPTIC FINAL INSPECTION: CALL 704-664-3703 between 8am-9am the day the inspection is needed.

Notes:

1) This property may be subject to any Easements, Rights-of-way, and/or Restrictive Covenants.

2) Boundary information based on Map Book: 54 at Page: 98-100 as recorded in the Iredell County Register of Deeds.

3) No N.C.G.S. or U.S.G.S. Monuments could be located within 2000'.

4) Area by coordinate method.

5) This survey is of an existing parcel of land.

P.B. 54, Pg. 98

Legend

R/W = Right-of-way
I.P.S. = #4 Rebar Set
B.O.C. = Back of Curb
= Not to scale
= Telephone Pedestal
= Utility Pole
= Cable Pedestal
= Calculated Point

Lot 17
PB 54 pg 99

Lot 16
PB 54 pg 99

Lot 17
PB 54 pg 99

S8°48'23"W 100.01'

2 54' Rep

Rep

35' Setback

80

80

Rep

3

10' Utility And Storm Drainage Easement

Lot 117
25,937 Sq.Ft.
0.60 Acres

260.06'

S81°59'14"E

258.68'

N81°59'14"W

15' Setback

50'

Lot 118
MB 54 PG 98

Lot 116
MB 54 PG 98

16.0

26.5

10.0

64.5

21.5

Proposed House

21.5

14.5

17.8

12.0

5.0

22.0

10.0

7.0

7.5

10.0

3.0

16.0

17.8

35' Setback

10' Utility And Storm Drainage Easement

Drive

37.0

N8°00'46"E 100.00'

Staffordshire Drive

50' Public R/W

GRAPHIC SCALE

0 25 50 100

THE OAKS GROUP, PA

To: Iredell County Environmental Health Department (ICHD)

From: Kathleen Saunders, LSS

RE: 189 Stafforshire Dr

Date: April 15, 2021

Attached is the septic specification information required to permit 189 Staffordshire Dr for an Improvement Permit and/or Construction Authorization Permit in Iredell County via the Session Law 14 permitting process.

The attached information is not an Improvement Permit or an Authorization to Construct, and is only to assist the Iredell with permitting. The ICHD has to approve each lot and only the ICHD can issue these permits. The system should be installed according to the ICHD permits, policies, and NC Rules, which these specifications are in accordance with. If the ICHD wishes to change tank locations, distribution devices, etc they may do so at their discretion.

All information and specifications have been prepared in conjunction with ICHD permitting guidelines for the current lot owners to acquire an Improvement Permit and/or Authorization to Construct on this lot. It is ultimately the ICHD's responsibility to verify all specifications before permitting and/or septic system installation. The site contains highly variable soils; there may be soil features present that were not encountered during the evaluation.

The LSS Evaluation attached to this application is to be used to produce design and construction features for permitting in accordance with SL 2018-114 Section 11.(c). The LSS Evaluation is being submitted pursuant to and meets the requirements of SL 2018-114 11.(c). The LSS Evaluation contains sufficient information to produce design and construction features for an IP/CA, and the LSS contains the proper insurance with the proper coverage.

Kathleen Saunders

LICENSED SOIL SCIENTIST
KATHLEEN M. SAUNDERS
1313
STATE OF NORTH CAROLINA

Castlegate Lot 117 - The Oaks Group, PA

Number of Bedrooms	**3**
Basement or Crawl	**Crawl Space**
Design Flow (gpd)	**360**
Primary System LTAR (gpd/ft2)	**0.3**
Primary System Type	**25% Reduction**
No. Lines	5 (See Table)
Total Linear Feet	300
Trench Width	3' min.
Trench Spacing	9' min.
Distribution Device	Drop Boxes or Other
Tank Size	1000 gallon tank
Max Trench Bottom Depth (Low Side)	30"
Maintenance Agreement Required	No
Repair System	**LP PPBPS**
Total Linear Feet	214
Repair Loading Rate	0.3
Repair trench depth	30"

Table: Summary of Primary and Repair Nitrification Line Specifications

Line No.	Use	Line Color	System Type	Line Length (Ft.)
1	System	Blue	25% Reduction	65 endfed
2	System	Red	25% Reduction	65 endfed
3	System	Yellow	25% Reduction	65 endfed
4	System	Orange	25% Reduction	60 endfed
5	System	Pink	25% Reduction	50 endfed
6	Repair	Pink	LP PPBPS	54
7	Repair	Orange	LP PPBPS	80
8	Repair	Yellow	LP PPBPS	80
				Total System: 300'
				Total Repair: 214'

Note: Keep necessary setbacks to foundation drains if used
Tank locations and distribution devices can be altered at ICHD's discretion

The LSS evaluation attached is being submitted pursuant to and meets the requirements of SL 2018-114 Section 11.(c).

Sheet ___ of ___
PROPERTY ID #: ___
COUNTY: Iredell

SOIL/SITE EVALUATION
for **ON-SITE WASTEWATER SYSTEM**
(Complete all fields in full)

OWNER: Castlegate LLC
ADDRESS: 7271 Long Island Rd Catawba NC
PROPOSED FACILITY: SFR
PROPOSED DESIGN FLOW (.1949): 360
LOCATION OF SITE: Castlegate Lot 117
APPLICATION DATE ___
DATE EVALUATED: 4/9/21
PROPERTY SIZE: 0.60
PROPERTY RECORDED: yes

WATER SUPPLY: ☐ Private ☒ Public ☐ Well ☐ Spring ☐ Other ___
EVALUATION METHOD: ☐ Auger Boring ☒ Pit ☐ Cut
TYPE OF WASTEWATER: ☒ Sewage ☐ Industrial Process ☐ Mixed

PROFILE #	.1940 LANDSCAPE POSITION/ SLOPE %	HORIZON DEPTH (IN.)	SOIL MORPHOLOGY (.1941) .1941 STRUCTURE/ TEXTURE	.1941 CONSISTENCE/ MINERALOGY	OTHER PROFILE FACTORS .1942 SOIL WETNESS/ COLOR	.1943 SOIL DEPTH	.1956 SAPRO CLASS	.1944 RESTR HORIZ	PROFILE CLASS & LTAR
1	L 2%	0-29	Mo SBK C	FR SS/SP	R	36"	PS	N/A	0.3
		29-36	WK SBK C	↓	R; F/C Sap				
		36-48	MA L Sap	↓	yel R				
2	L 5-10	0-15	Mo SBK C	FR SS/SP	R	29"	PS	N/A	0.3
		15-29	WK SBK CL	↓	R yel; C Sap				
		29-48	MA L Sap	↓	yel R				
3	L 5-10%	0-12	WK SBK C	FR SS/SP	R; C Sap	12"	PS	N/A	0.35
		12-55	MA L Sap	↓	yel R				
4	L 2%	0-7	Compacted clay						0.3
		7-39	Mo SBK C	Fi SS/SP	R				
		39-48	WK SBK C	FR SS/SP	R; C Sap				

DESCRIPTION	INITIAL SYSTEM	REPAIR SYSTEM
Available Space (.1945)	PS	PS
System Type(s)	III g	IV
Site LTAR	0.3	0.3

OTHER FACTORS (.1946): ___
SITE CLASSIFICATION (.1948): ___
EVALUATED BY: ___
OTHER(S) PRESENT: ___

LICENSED SOIL SCIENTIST
KATHLEEN M. SAUNDERS
THE GREAT SEAL OF THE STATE OF NORTH CAROLINA
1313
STATE OF NORTH CAROLINA

Kathleen Saunders

COMMENTS: ___

Updated February 2014

RECEIVED APR 15 2021

Session Law

IREDELL COUNTY DEPARTMENT of ENVIRONMENTAL HEALTH

APPLICATION FORM AP-309488 $500.00

Application For: ( ) New Well Permit ( ) Well Repair Permit ( ) Well Abandonment
(X) Septic Improvement Permit (X) Authorization to Construct ( ) Existing System Inspection ( ) Septic System Repair

THE ABOVE PERMIT DOCUMENTS WILL BECOME INVALID IF INFORMATION PROVIDED ON THIS APPLICATION IS FALSIFIED OR CHANGED, OR IF THE SITE IS ALTERED. THE IMPROVEMENT PERMIT IS VALID FOR EITHER 60 MONTHS OR WITHOUT EXPIRATION DEPENDING UPON DOCUMENTATION SUBMITTED. APPLICATION WITH SITE PLAN 60 MONTHS. APPLICATION WITH COMPLETE, SCALED PLAT WITHOUT EXPIRATION. SEE 15A NCAC 18A .1937(f) FOR DETAILS.

Page 2: *Site Plan Worksheet* form MUST accompany this application

The following optional attachments may also be submitted: ( ) Survey Plat, scaled no more than 1 inch = 60 feet
Place an (X) beside whichever is submitted if applicable ( ) Custom Site Plan, scaled no more than 1 inch = 60 feet

Applicant Information: (PRINT CLEARLY)

Applicant Name: Castlegate LLC Address: 7271 Long Island Rd Catawba Zip: NC

Applicant Email: _____ Phone: _____ Alt. Phone: _____

Owner Name: Same Address: _____ Zip: _____

Owner Email: _____ Phone: _____ Alt. Phone: 704-578-4951 (LSS)

Property Information:

Street Address: 189 Staffordshire Dr

Subdivision Name: Castlegate Section/Phase: _____ Lot Number: 117

Driving Directions: Rt 64, Rt 90, Absher Farm Loop, Staffordshire

Site Development Information: *(check or complete ALL that apply*

(X) New Single Family Residence
( ) New Multi-Family Residence
( ) Accessory Building
( ) Bedroom(s) Addition
( ) Repair to failing septic system ___ Tank ___ Drain lines Describe Problem: _____

Maximum Number of Bedrooms: 3
Maximum Number of Occupants: 6
( ) Swimming Pool
( ) Other Addition/Structure: _____

CHECK FOUNDATION TYPE
(X) Crawl Space Foundation
( ) Concrete Slab Foundation
( ) Basement with Plumbing
( ) Basement without Plumbing

Non-Residential Site Development: Type of Business: _____
Square Footage of Building: _____ Max. Number of Employees: _____ Max. Number of Seats/Beds/Other: _____

Water Supply: ( ) Replacement Well – Reason: _____
( ) Multi-connection Well Number of Houses: _____ Number of Persons: _____

( ) New Well ( ) Existing Well ( ) Community Well (X) City Water ( ) Other Public Water

Desired Septic System Type: *(you may rank in order of preference)* Year existing system installed: _____
( ) No Preference ( ) Alternative ( ) Conventional ( ) Innovative ( ) Modified Conventional ( ) Other: _____

Please answer the following to the best of your ability:

( ) Yes (X) No Does the site contain any jurisdictional wetlands?
( ) Yes (X) No Is any non-domestic sewage (i.e. industrial) to be generated?
( ) Yes (X) No Is the site subject to approval by any other public agency?

I have read this application and certify that the information provided herein is true, complete, and correct. Authorized county and state officials are granted right of entry to conduct necessary inspections to determine compliance with applicable laws and rules. I understand that I am solely responsible for the proper identification and labeling of all property lines and corners and making the site accessible so that a complete site evaluation can be performed.

Signature: Kathleen Saunders 4-15-21
Property owner or owner's legal representative signature (SIGNATURE REQUIRED) DATE

AUTHORIZATION TO ACT AS AGENT FOR OWNER

Any application/document/permit requiring a signature must be signed by the property owner or their authorized agent. This form shall be provided by the owner to allow specified individuals to act as agents for the owner. This form allows the specified individuals to sign or receive any application/document/permit on behalf of the owner. This form allows the authorized agent to make decisions on behalf of the owner pertaining to modifications of permits in the field. It is the responsibility of the owner to assure that any/all permit conditions specified on permits issued by this Division are followed.

I, Ray Short, am the legal owner of the property located at 189 Staffordshire, identified as PIN(Parcel Identification Number)_____, located in Iredell County, North Carolina.

I do hereby authorize (print authorized agent/company name) The Oaks Group, _____, _____, _____, _____, to act as an agent on my behalf in applying for/signing/obtaining any of the documents described below.

1. Improvement Permit (IP)/ Authorization to Construct (AC).
2. Application for soil-site evaluation (new/repair).
3. Application/permit for water well/well abandonment.
4. Application for existing system.
5. Application for Improvement Permit (IP)/ Authorization to Construct (AC).

I agree to abide by any and all decisions and/or conditions between the agent acting on my behalf and the Iredell County Department of Public Health, Environmental Health Division. This form must be fully executed before the individual's specified above will be recognized as the authorized agent.

Signature of Owner — Date: 4.15.21

Signature of Witness — Date


IREDELL COUNTY DEPARTMENT of ENVIRONMENTAL HEALTH

SITE PLAN WORKSHEET

SEE THE "SAMPLE SITE PLAN" BELOW. ***INCOMPLETE SITE PLANS WILL BE RETURNED TO YOU FOR COMPLETION AND MAY RESULT IN A DELAY IN THE ISSUANCE OF YOUR SEPTIC SYSTEM OR WELL PERMIT!!!***

Place an (X) beside each item as you complete the site plan:

- (✓) Property Line measurements are clearly identified
- (✓) All proposed structures are indicated
- (✓) Front and side setbacks from property line
- (✓) Preferred driveway location
- (✓) Preferred well location
- (✓) Preferred septic system location
- (✓) North arrow, or other sufficient indicator of direction

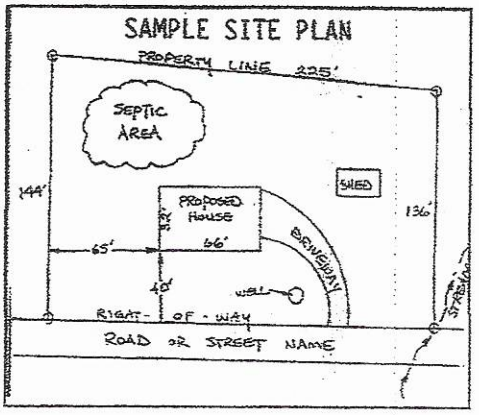

Circle N/A on the following if appropriate:

- Location of septic systems and wells within 100' of your property (N/A)
- Location of easements and rights of ways on your property (N/A)
- Location of any designated wetlands on the property (N/A)

USE THIS SPACE TO DRAW YOUR SITE PLAN

Show: proposed house or business footprint, wells, water lines, patios, pools and decks, and any other item that will occupy space on the site

Please see Attached

Signature: Kathleen Saunders

Property owner or owner's legal representative signature (SIGNATURE REQUIRED)

4.15.21

DATE

Notes:

1) This property may be subject to any Easements, Rights-of-way, and/or Restrictive Covenants.

2) Boundary information based on Map Book: 54 at Page: 98-100 as recorded in the Iredell County Register of Deeds.

3) No N.C.G.S. or U.S.G.S. Monuments could be located within 2000'.


4) Area by coordinate method.

5) This survey is of an existing parcel of land.

P.B. 54, Pg. 98

Legend

R/W = Right-of-way
I.P.S. = #4 Rebar Set
B.O.C. = Back of Curb
= Not to scale
= Telephone Pedestal
= Utility Pole
= Cable Pedestal
= Calculated Point

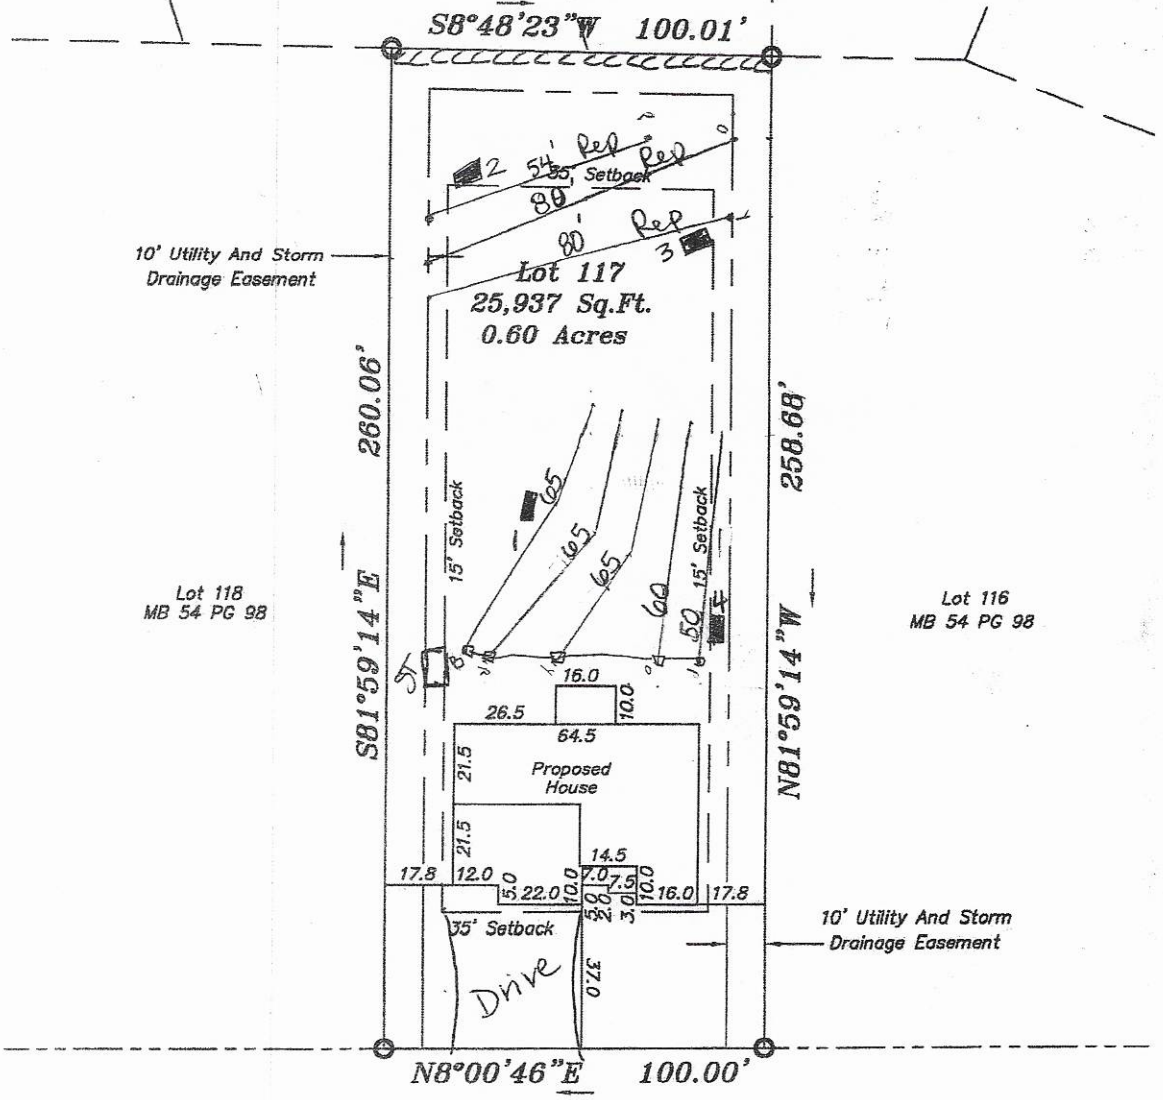


Staffordshire Drive

50' Public R/W

GRAPHIC SCALE

0 25 50 100

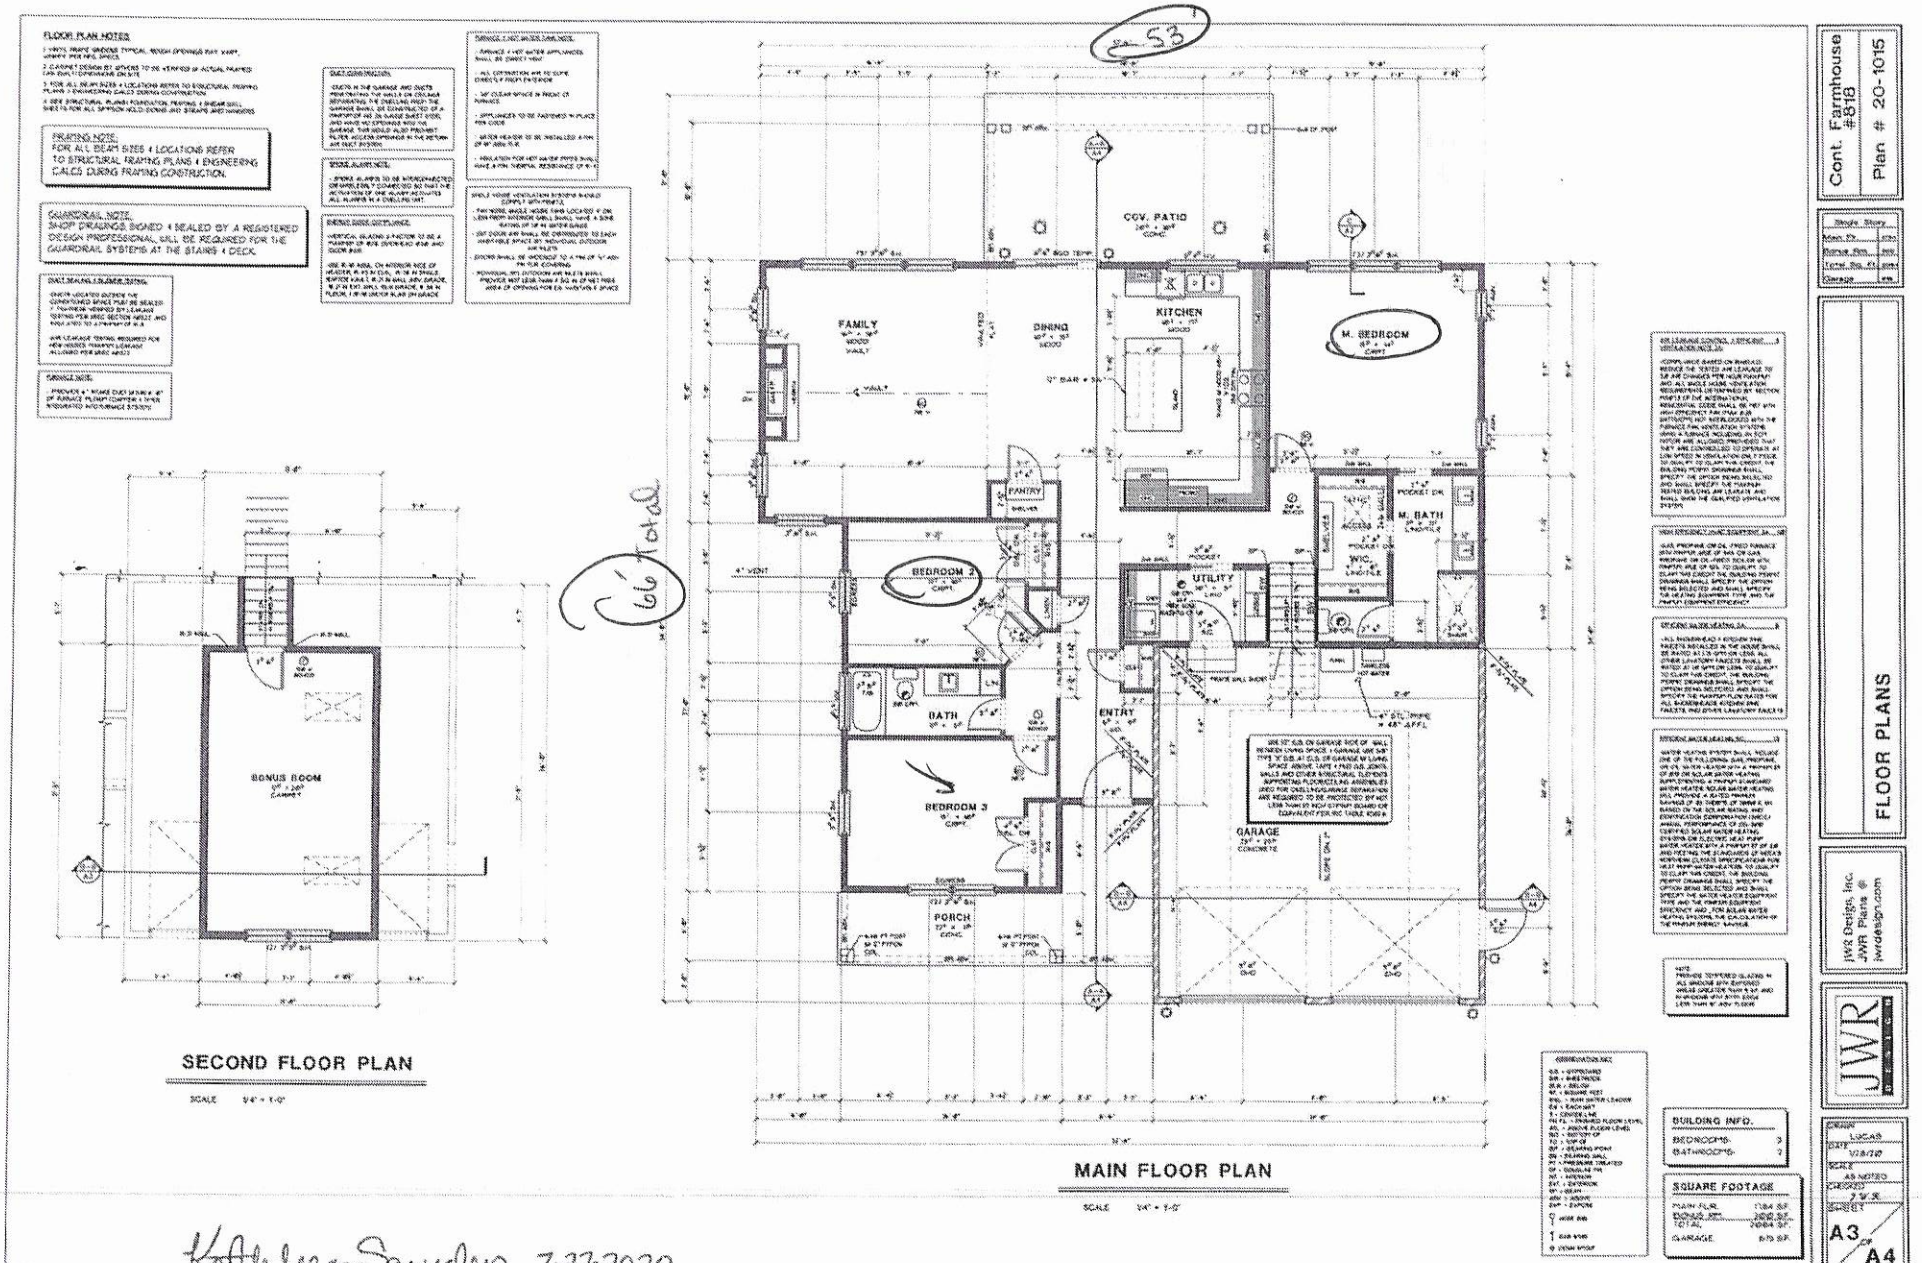

Kathleen Saunders 7-27-2020

Bijan A Bur 8-7-2020

Cont. Farmhouse #818

Plan # 20-1015

FLOOR PLANS

JWR Design, Inc.
JWR Plans @
jwrdesign.com

JWR

DRAWN: LUCAS
DATE: 1/24/18
SCALE: AS NOTED
CHECKED: J.W.R.
SHEET: A3 OF A4

IREDELL COUNTY · NC

IREDELL COUNTY
PO Box 788
349 North Center St.
Statesville, NC 28677

APPLICATION NUMBER
309488 Issue Date:

Permit Type: ZONING

FILE COPY

Parcel Number	Street Address	Jurisdiction
4715842761.000	189 STAFFORDSHIRE DR	Iredell County

Owner Information	Applicant Information
Name: ST1 LLC	Name: THE OAKS GROUP
Address: PO BOX 3792	Address: 121 HOLT LN
MOORESVILLE, NC 28117	MOORESVILLE, NC 28117
Phone:	Phone: (704)578-4951

Use Requested	Zone Code
Single Family Dwelling	RA

Lot Acreage	F Setback	B Setback	L Setback	R Setback	Watershed	Flood Zone
0.6	35	35	15	15		NO

Remarks
SFD

The applicant certifies that there are no deed restrictions, contractual agreements or governmental regulations of any kind that interfere with or prohibit the use of the property or the use for which this permit is requested. The applicant further acknowledges that enforcement of deed restrictions, plat conditions and other contractual agreements will not be undertaken by Iredell County and is the sole responsibility of the affected parties.

SEE ATTACHED

Signature of Owner/Contractor


PAID Credit 7-28-20 pk

Date: 07/28/2020

Permit Number	309488	TOTAL FEES:	$77.25

309488
Scanned ✓

ZONING DISCLAIMER

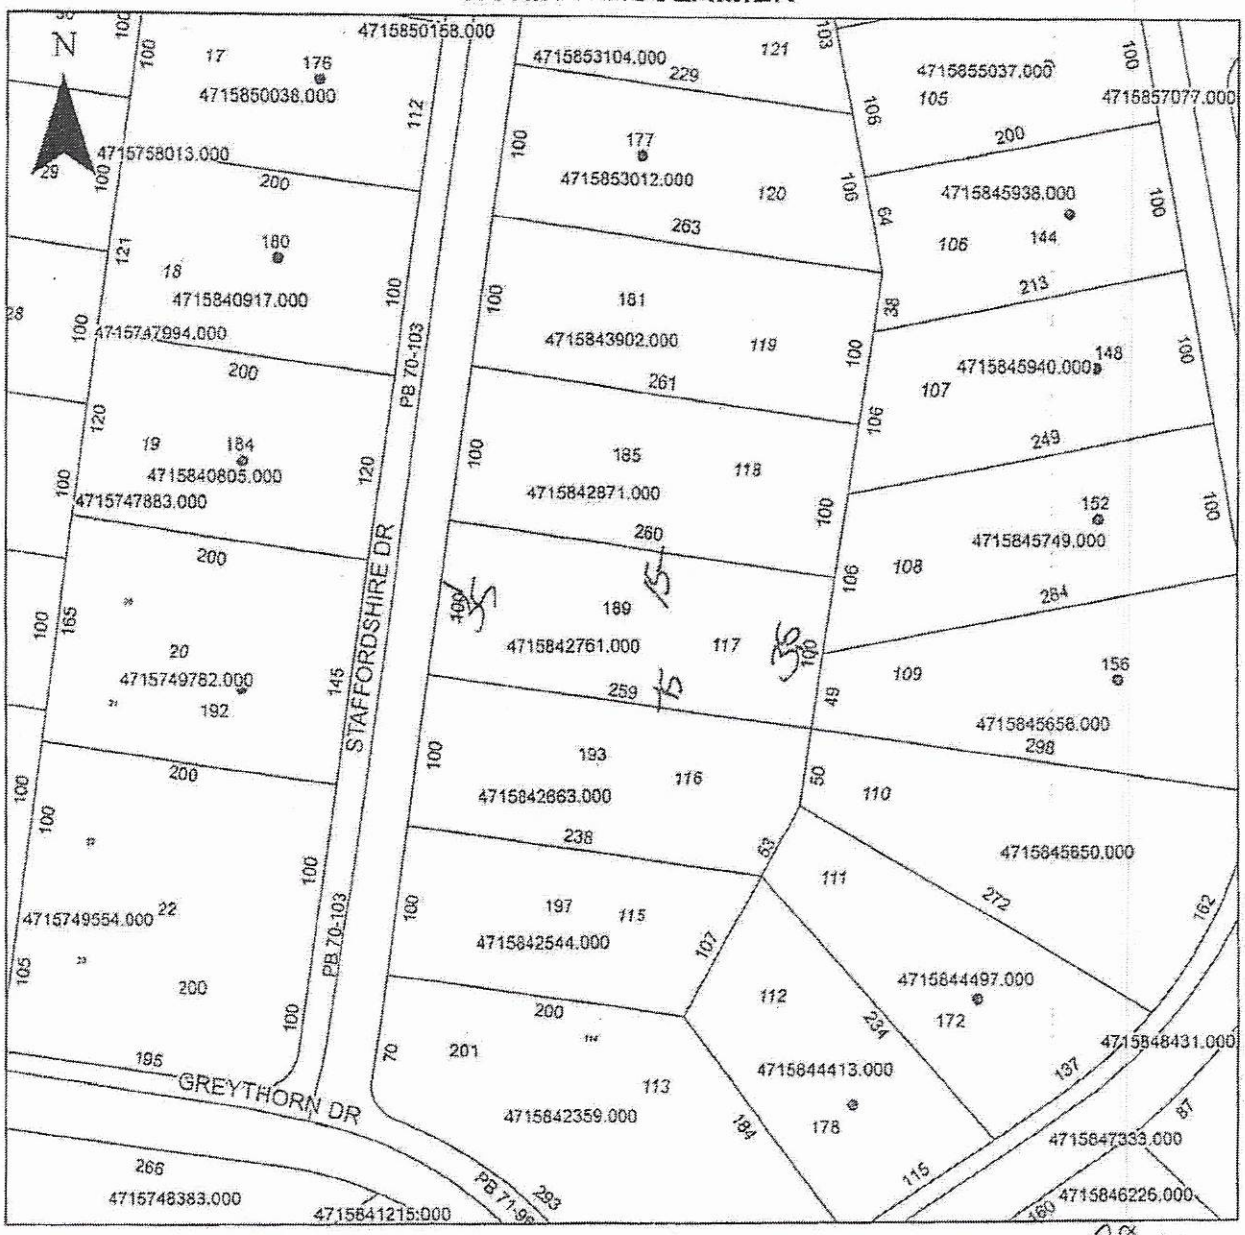

Property Address 189 Staffordshire Dr.

R-D.6
NB

The applicant certifies that there are no deed restrictions, contractual agreements or governmental regulations of any kind that interfere with or prohibit the use of the property or the use for which this permit is requested. Applicant further acknowledges that the enforcement of deed restrictions, plat conditions, and other contractual agreements will not be undertaken by Iredell County and is the sole responsibility of the affected parties.

Kathleen Saunders
Applicant

7-29-2020
Date