ICHD - ENVIRONMENTAL HEALTH DIVISION

Statesville Office (704) 878-5305 Mooresville Office (704) 660-3625 PERMIT # 307449

SEPTIC: IMPROVEMENT PERMIT / AUTHORIZATION TO CONSTRUCT / OPERATION PERMIT / EXISTING SYSTEM

PIN # 4715843028.000

APPLICANT/OWNER: Castlegate LLC APPLICANT ADDRESS: 7271 Long Island Rd Catawba NC

SITE ADDRESS: 191 Castle Pines Ln Statesville NC 28625 PHONE: — ALT. PHONE 704-578-4951 (LSS)

SITE DIRECTIONS: RT 64, Rt 90, Absher Farm Loop, Staffordshire SAP CONTROLLED: ☐ YES ☒ NO

SUBDIVISION: Castlegate SECTION: — LOT # 70 LOT AREA: 165 x 200 DESIGN FLOW: 360 L.T.A.R.: 30

Septic Tank 1000 (gal) STB Date

Pump Tank (gal) PT Date

Pump Make Model Serial #

Nitrification Fields 1 # Lines 3 Linear Ft: 300

Trench Width 36 Trench Bottom Depth(Low side) 30 Gravel Depth —

☒ New System ☐ Repair ☐ Expansion System Type: I II ☒ III IV V VI

System Description: Gravity - 25% Reduction.

Repair System Description: LP-PPBPS

Maintenance Agreement Required: ☐ YES ☒ NO

☒ GRAVITY ☐ PRESSURE

☒ Residence No. Bedrooms 3

☐ Business No. Persons 6

☐ Other No. Employees

☐ Slab ☒ Crawl Space

☐ Basement w/plumbing ☐ Basement w/o plumbing

Water Supply: ☐ Private ☒ Public ☐ Community

Comments / Conditions:

INITIAL SITE SKETCH

This permit is issued pursuant to Section 11 . (C) of S.L. 2018-114 using the signed and sealed LSS Evaluation by:

The Oaks Group PA

LSS # 1313

AS BUILT SKETCH

FOR SEPTIC INSPECTION CALL: 704-664-3703 between 8am-9am the day the inspection is needed. Be sure to speak with an inspector to confirm your time.

Installed as Permitted

Permit can be suspended or revoked if any false information is supplied toward securing the permit / any unauthorized changes are made to the site / any unauthorized changes are made in the installation of the system. **CONTACT A LOCATOR SERVICE PRIOR TO ANY EXCAVATION**

☐ **IMPROVEMENT PERMIT** *with plat valid without expiration.* ☒ **IMPROVEMENT PERMIT** *with site plan valid for 60 mos.* ☒ **AUTHORIZATION TO CONSTRUCT** *valid for period equal to IMPROVEMENT PERMIT--not to exceed 60 mo.*

Owner / Applicant Signature: Acceptance of Permit Form Rec'd Date: 5-28-20 Installed by: Rowan Septic

IMPROVEMENT PERMIT by: Benjamin A. Botkins Date: 5-19-2020 OPERATION PERMIT by: Benjamin Botkins Date: 9-3-2020

AUTHORIZATION TO CONSTRUCT by: Benjamin A. Botkins Date: 5-19-2020 Existing System Inspected by: Date:

FOR SEPTIC FINAL INSPECTION: CALL 704-664-3703 between 8am-9am the day the inspection is needed.

Notes:

1) This property may be subject to any Easements, Rights-of-way, and/or Restrictive Covenants.

2) Boundary information based on Map Book: 54 at Page: 98 as recorded in the Iredell County Register of Deeds.


3) No N.C.G.S. or U.S.G.S. Monuments could be located within 2000'.

4) Area by coordinate method.

5) These lot will need to be recombined.


Legend

R/W = Right-of-way
I.P.S. = #4 Rebar Set
B.C.C. = Back of Curb
—∿— = Not to scale
⊡ = Telephone Pedestal
= Utility Pole
◉ = Cable Pedestal
● = Calculated Point

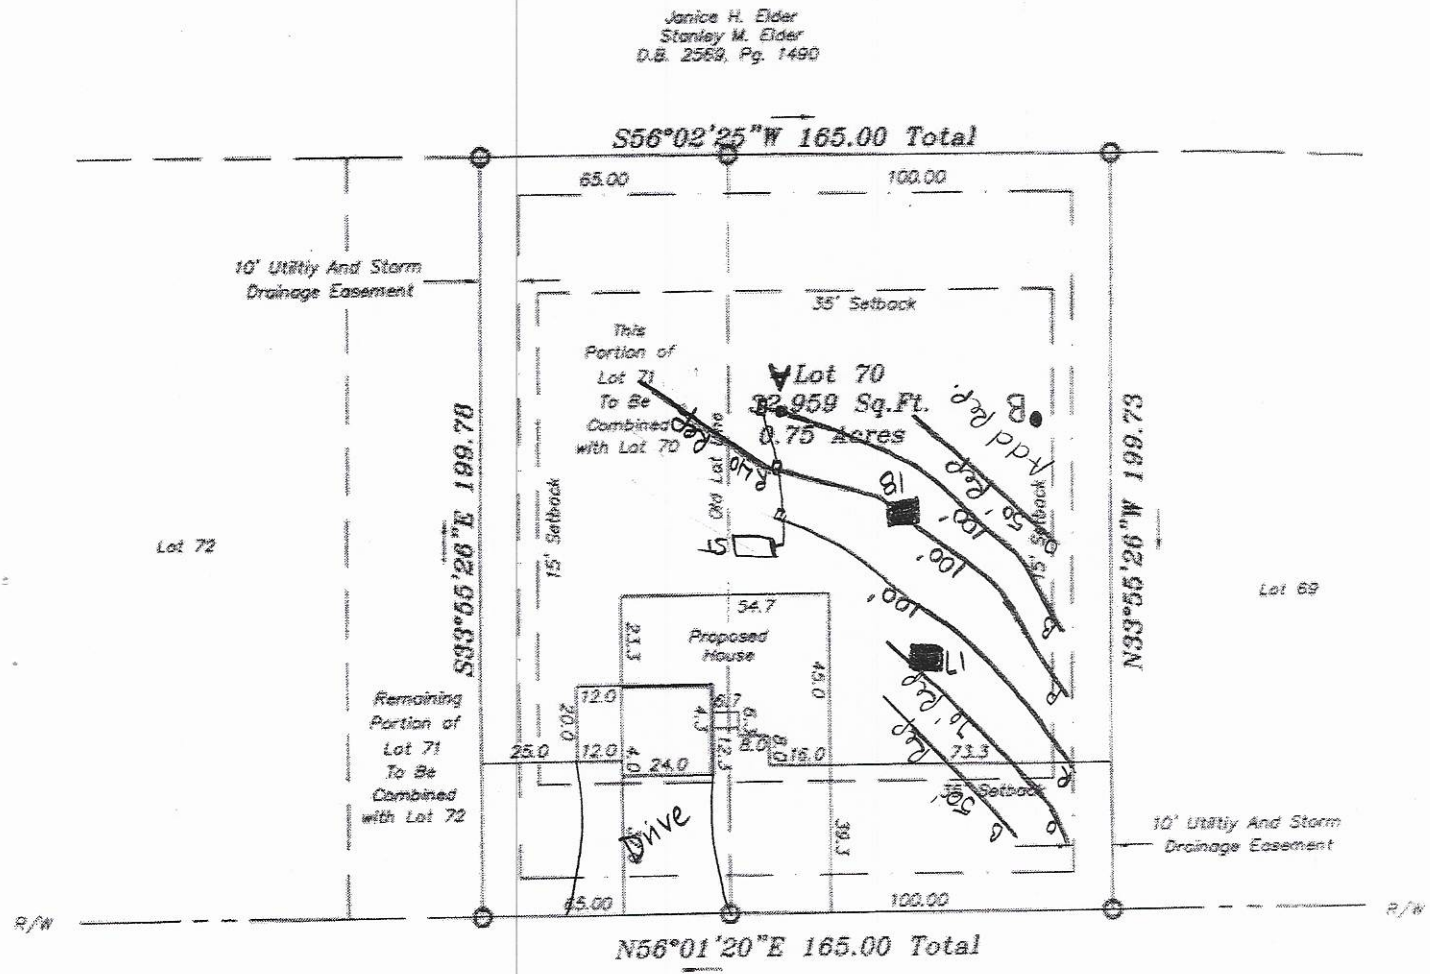

Castle Pines Ln.

50' Public R/W

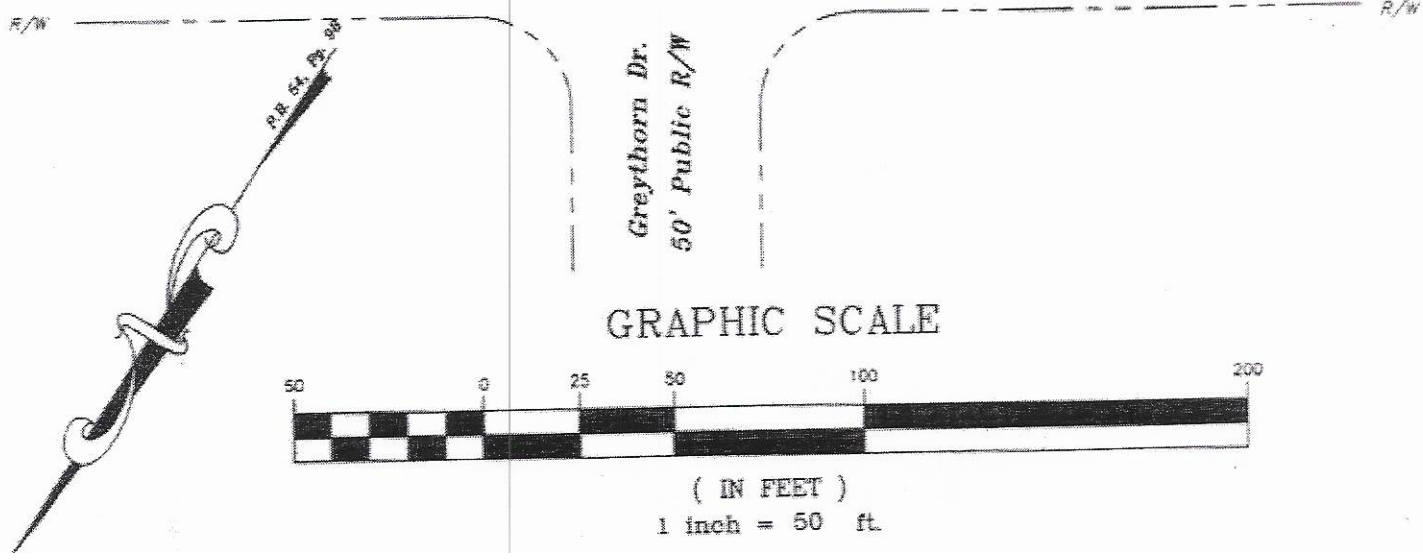

GRAPHIC SCALE

50 0 25 50 100 200

(IN FEET)

1 inch = 50 ft.

Castlegate Lot 70 - The Oaks Group, PA

Number of Bedrooms	**3**
Basement or Crawl	**Crawl Space**
Design Flow (gpd)	**360**
Primary System LTAR (gpd/ft2)	**0.3**
Primary System Type	**25% Reduction**
No. Lines	3 (See Table)
Total Linear Feet	300
Trench Width	3' min.
Trench Spacing	9' min.
Distribution Device	Drop Boxes or Other
Tank Size	1000 gallon tank
Max Trench Bottom Depth (Low Side)	30"
Maintenance Agreement Required	No
Repair System	**LP PPBPS**
Total Linear Feet	210
Repair Loading Rate	0.3
Repair trench depth	30"

Table: Summary of Primary and Repair Nitrification Line Specifications

Line No.	Use	Line Color	System Type	Line Length (Ft.)
1	Repair	Blue	LP PPBPS	50
2	Repair	Orange	LP PPBPS	70
3	System	Red	25% Reduction	100 endfed
4	System	Pink	25% Reduction	100 endfed
5	Repair	Pink	25% Reduction	40
6	System	Blue	25% Reduction	100 endfed
7	Repair	Orange	25% Reduction	50
				Total System: 300'
				Total Repair: 210'

Note: Keep necessary setbacks to foundation drains if used
Tank locations and distribution devices can be altered at ICHD's discretion

The LSS evaluation attached is being submitted pursuant to and meets the requirements of SL 2018-114 Section 11.(c).

Sheet ____ of ____
PROPERTY ID #: ____
COUNTY: Iredell

SOIL/SITE EVALUATION
for **ON-SITE WASTEWATER SYSTEM**
(Complete all fields in full)

OWNER: Castlegate LLC
ADDRESS: 7271 Long Island Rd
PROPOSED FACILITY: SFR
PROPOSED DESIGN FLOW (.1949): 360
LOCATION OF SITE: Castlegate 70
APPLICATION DATE ____
DATE EVALUATED: 12/2019
PROPERTY SIZE: 0.75
PROPERTY RECORDED: yes

WATER SUPPLY: ☐ Private ☒ Public ☐ Well ☐ Spring ☐ Other ____
EVALUATION METHOD: ☒ Auger Boring ☒ Pit ☐ Cut
TYPE OF WASTEWATER: ☒ Sewage ☐ Industrial Process ☐ Mixed

PROFILE #	.1940 LANDSCAPE POSITION/ SLOPE %	HORIZON DEPTH (IN.)	SOIL MORPHOLOGY (.1941) .1941 STRUCTURE/ TEXTURE	.1941 CONSISTENCE/ MINERALOGY	OTHER PROFILE FACTORS .1942 SOIL WETNESS/ COLOR	.1943 SOIL DEPTH	.1956 SAPRO CLASS	.1944 RESTR HORIZ	PROFILE CLASS & LTAR
17 Pit	L 3-5%	0-33	Mo SBK C	FR SS/SP	R	60+	N/A	N/A	0.3
		33-60	WK SBK CL	↓	R; C sap				
18 Pit	L 3-5%	0-10	Compaction		R	48+	N/A	N/A	0.3
		10-48	Mo SBK C	FR SS/SP					
A AB	L 3-5%	0-8	Compaction		R	48+	N/A	N/A	0.3
		8-32	Mo SBK C	FR SS/SP	R; C sap				
		32-48	WK SBK CL	↓					
B AB	L 3-5%	0-48	Mo SBK C	FR SS/SP	R; F sap	48+	N/A	N/A	0.3

DESCRIPTION	INITIAL SYSTEM	REPAIR SYSTEM
Available Space (.1945)	PS	PS
System Type(s)	III g	IV
Site LTAR	0.3	0.3

OTHER FACTORS (.1946): 30" TR
SITE CLASSIFICATION (.1948): ____
EVALUATED BY: ____
OTHER(S) PRESENT: ____

LICENSED SOIL SCIENTIST
KATHLEEN M. SAUNDERS
THE GREAT SEAL OF THE STATE OF NORTH CAROLINA
1313
STATE OF NORTH CAROLINA

COMMENTS: ____

Updated February 2014

THE OAKS GROUP, PA

To: Iredell County Environmental Health Department (ICHD)

From: Kathleen Saunders, LSS

RE: 191 Castle Pines Dr


Date: May 11, 2020

Attached is the septic specification information required to permit 191 Castle Pines Dr for an Improvement Permit and/or Construction Authorization Permit in Iredell County via the Session Law 14 permitting process.

The attached information is not an Improvement Permit or an Authorization to Construct, and is only to assist the Iredell with permitting. The ICHD has to approve each lot and only the ICHD can issue these permits. The system should be installed according to the ICHD permits, policies, and NC Rules, which these specifications are in accordance with. If the ICHD wishes to change tank locations, distribution devices, etc they may do so at their discretion.

All information and specifications have been prepared in conjunction with ICHD permitting guidelines for the current lot owners to acquire an Improvement Permit and/or Authorization to Construct on this lot. It is ultimately the ICHD's responsibility to verify all specifications, **excluding** soil descriptions, before permitting and/or septic system installation. The site contains highly variable soils; there may be soil features present that were not encountered during the evaluation.

The LSS Evaluation attached to this application is to be used to produce design and construction features for permitting in accordance with SL 2018-114 Section 11.(c). The LSS Evaluation is being submitted pursuant to and meets the requirements of SL 2018-114 11.(c). The LSS Evaluation contains sufficient information to produce design and construction features for an IP/CA, and the LSS contains the proper insurance with the proper coverage.

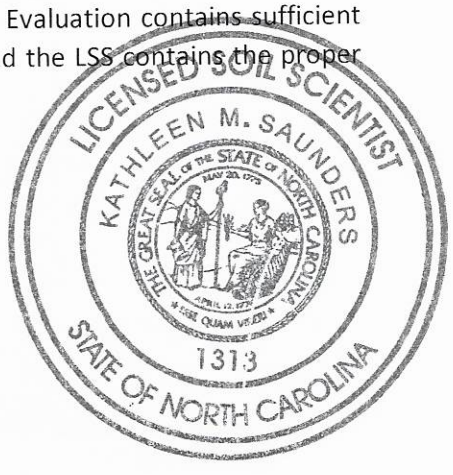

RECEIVED MAY 1 3 2020

Session Law #577:25

IREDELL COUNTY DEPARTMENT of ENVIRONMENTAL HEALTH

APPLICATION FORM

Paid $500.00

Application For:
(X) Septic Improvement Permit ( ) New Well Permit (X) Authorization to Construct ( ) Well Repair Permit ( ) Existing System Inspection ( ) Well Abandonment ( ) Septic System Repair

THE ABOVE PERMIT DOCUMENTS WILL BECOME INVALID IF INFORMATION PROVIDED ON THIS APPLICATION IS FALSIFIED OR CHANGED, OR IF THE SITE IS ALTERED. THE IMPROVEMENT PERMIT IS VALID FOR EITHER 60 MONTHS OR WITHOUT EXPIRATION DEPENDING UPON DOCUMENTATION SUBMITTED. APPLICATION WITH SITE PLAN 60 MONTHS, APPLICATION WITH COMPLETE, SCALED PLAT WITHOUT EXPIRATION. SEE 15A NCAC 18A .1937(f) FOR DETAILS.

AP 307449

Page 2: *Site Plan Worksheet* form MUST accompany this application

The following optional attachments may also be submitted: ( ) Survey Plat, scaled no more than 1 inch = 60 feet ( ) Custom Site Plan, scaled no more than 1 inch = 60 feet

Place an (X) beside whichever is submitted if applicable

Applicant Information: (PRINT CLEARLY)

Applicant Name: Castlegate LLC Address: 7271 Long Island Rd Catawba Zip: NC

Applicant Email: _____ Phone: _____ Alt. Phone: _____

Owner Name: Same Address: _____ Zip: _____

Owner Email: _____ Phone: _____ Alt. Phone: 704-578-4951 (LSS)

Property Information:

Street Address: 191 Castle Pines Dr Statesville

Subdivision Name: Castlegate Section/Phase: _____ Lot Number: 70

Driving Directions: Rt 64, Rt 90, Absher Farm Loop, Staffordshire

Site Development Information: *(check or complete ALL that apply*

CHECK FOUNDATION TYPE

(X) New Single Family Residence
( ) New Multi-Family Residence
( ) Accessory Building
( ) Bedroom(s) Addition
( ) Repair to failing septic system ___ Tank ___ Drain lines Describe Problem: _____

Maximum Number of Bedrooms: 3
Maximum Number of Occupants: 6
( ) Swimming Pool
( ) Other Addition/Structure: _____

(X) Crawl Space Foundation
( ) Concrete Slab Foundation
( ) Basement with Plumbing
( ) Basement without Plumbing

Non-Residential Site Development: Type of Business: _____
Square Footage of Building: _____ Max. Number of Employees: _____ Max. Number of Seats/Beds/Other: _____

Water Supply: ( ) Replacement Well – Reason: _____
( ) Multi-connection Well Number of Houses: _____ Number of Persons: _____

( ) New Well ( ) Existing Well ( ) Community Well (X) City Water ( ) Other Public Water

Desired Septic System Type: *(you may rank in order of preference)* Year existing system installed: _____
( ) No Preference ( ) Alternative ( ) Conventional ( ) Innovative ( ) Modified Conventional ( ) Other: _____

Please answer the following to the best of your ability:

( ) Yes (X) No Does the site contain any jurisdictional wetlands?
( ) Yes (X) No Is any non-domestic sewage (i.e. industrial) to be generated?
( ) Yes (X) No Is the site subject to approval by any other public agency?

I have read this application and certify that the information provided herein is true, complete, and correct. Authorized county and state officials are granted right of entry to conduct necessary inspections to determine compliance with applicable laws and rules. I understand that I am solely responsible for the proper identification and labeling of all property lines and corners and making the site accessible so that a complete site evaluation can be performed.

Signature: Kathleen Saunders 5-11-2020
Property owner or owner's legal representative signature (SIGNATURE REQUIRED) DATE


IREDELL COUNTY DEPARTMENT of ENVIRONMENTAL HEALTH

SITE PLAN WORKSHEET

SEE THE "SAMPLE SITE PLAN" BELOW. ***INCOMPLETE SITE PLANS WILL BE RETURNED TO YOU FOR COMPLETION AND MAY RESULT IN A DELAY IN THE ISSUANCE OF YOUR SEPTIC SYSTEM OR WELL PERMIT!!!***

Place an (X) beside each item as you complete the site plan:

- (✓) Property Line measurements are clearly identified
- (✓) All proposed structures are indicated
- (✓) Front and side setbacks from property line
- (✓) Preferred driveway location
- ( ) Preferred well location
- ( ) Preferred septic system location
- (✓) North arrow, or other sufficient indicator of direction

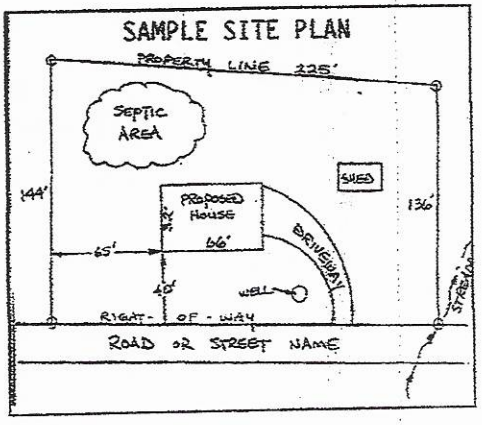

Circle N/A on the following if appropriate:

- Location of septic systems and wells within 100' of your property (N/A)
- Location of easements and rights of ways on your property (N/A)
- Location of any designated wetlands on the property (N/A)

USE THIS SPACE TO DRAW YOUR SITE PLAN

Show: proposed house or business footprint, wells, water lines, patios, pools and decks, and any other item that will occupy space on the site

Please see Attached

Signature: Kathleen Saunders
Property owner or owner's legal representative signature (SIGNATURE REQUIRED)

5-11-2020
DATE

Notes:

1) This property may be subject to any Easements, Rights-of-way, and/or Restrictive Covenants.

2) Boundary information based on Map Book: 54 at Page: 98 as recorded in the Iredell County Register of Deeds.


3) No N.C.G.S. or U.S.G.S. Monuments could be located within 2000'.

4) Area by coordinate method.

5) These lot will need to be recombined.


Legend

R/W = Right-of-way
I.P.S. = #4 Rebar Set
B.C.C. = Back of Curb
= Not to scale
= Telephone Pedestal
= Utility Pole
= Cable Pedestal
= Calculated Point

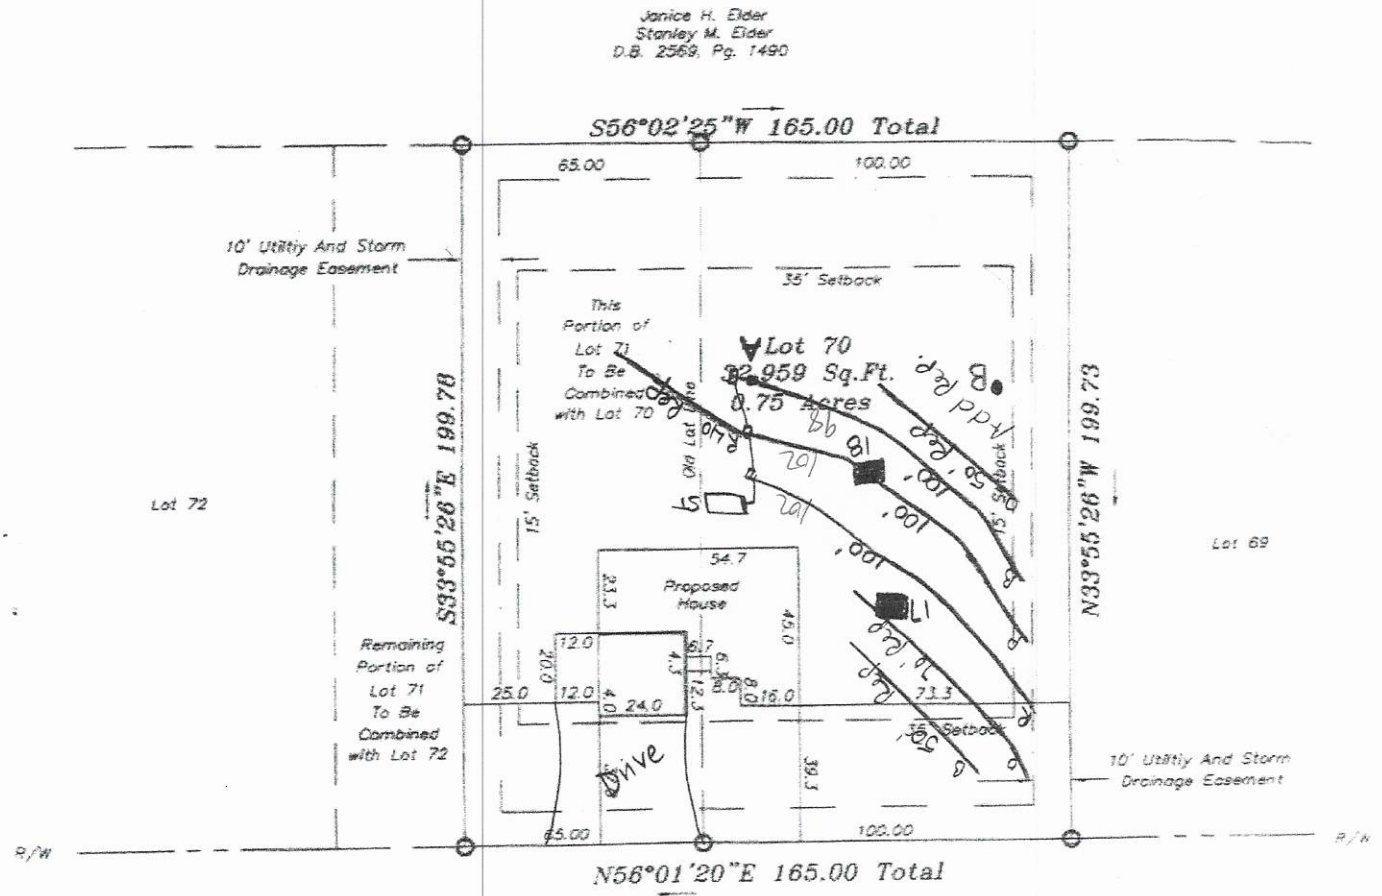

Castle Pines Ln.

50' Public R/W

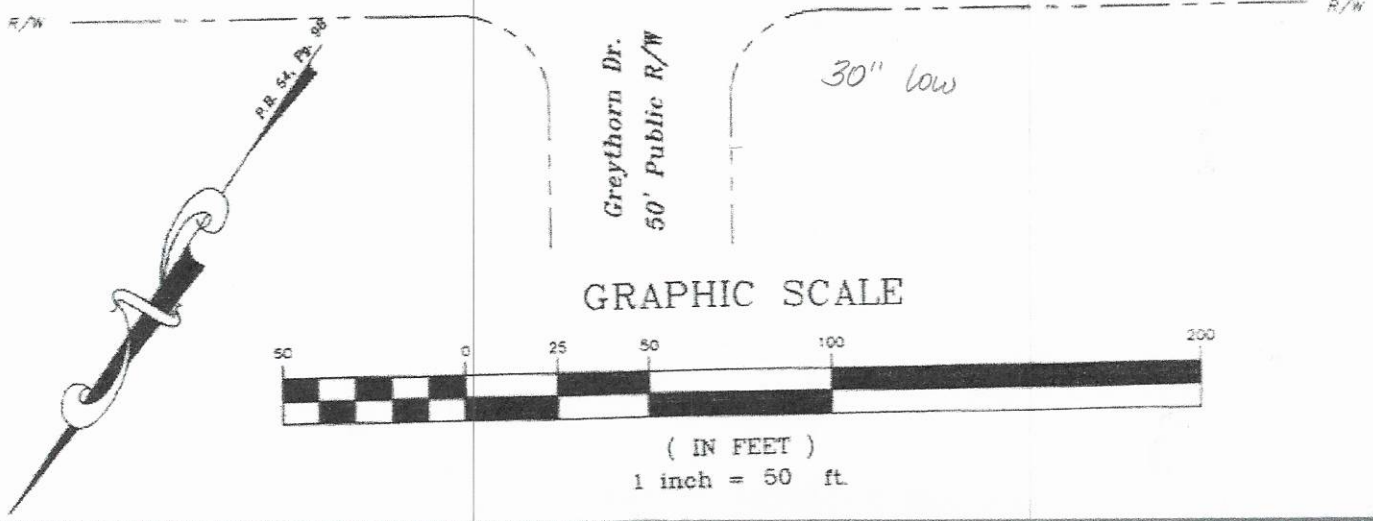

GRAPHIC SCALE

50 0 25 50 100 200

(IN FEET)

1 inch = 50 ft.

AUTHORIZATION TO ACT AS AGENT FOR OWNER

Any application/document/permit requiring a signature must be signed by the property owner or their authorized agent. This form shall be provided by the owner to allow specified individuals to act as agents for the owner. This form allows the specified individuals to sign or receive any application/document/permit on behalf of the owner. This form allows the authorized agent to make decisions on behalf of the owner pertaining to modifications of permits in the field. It is the responsibility of the owner to assure that any/all permit conditions specified on permits issued by this Division are followed.

I, Ray Short, am the legal owner of the property located at 191 Castle Pines Dr Statesville, identified as PIN(Parcel Identification Number)_____, located in Iredell County, North Carolina.


I do hereby authorize (print authorized agent/company name) The Oaks Group, _____, _____, _____, _____, to act as an agent on my behalf in applying for/signing/obtaining any of the documents described below.

1. Improvement Permit (IP)/ Authorization to Construct (AC).
2. Application for soil-site evaluation (new/repair).
3. Application/permit for water well/well abandonment.
4. Application for existing system.
5. Application for Improvement Permit (IP)/ Authorization to Construct (AC).

I agree to abide by any and all decisions and/or conditions between the agent acting on my behalf and the Iredell County Department of Public Health, Environmental Health Division. This form must be fully executed before the individual's specified above will be recognized as the authorized agent.

Signature of Owner — Date: 5-11-2020

Signature of Witness — Date

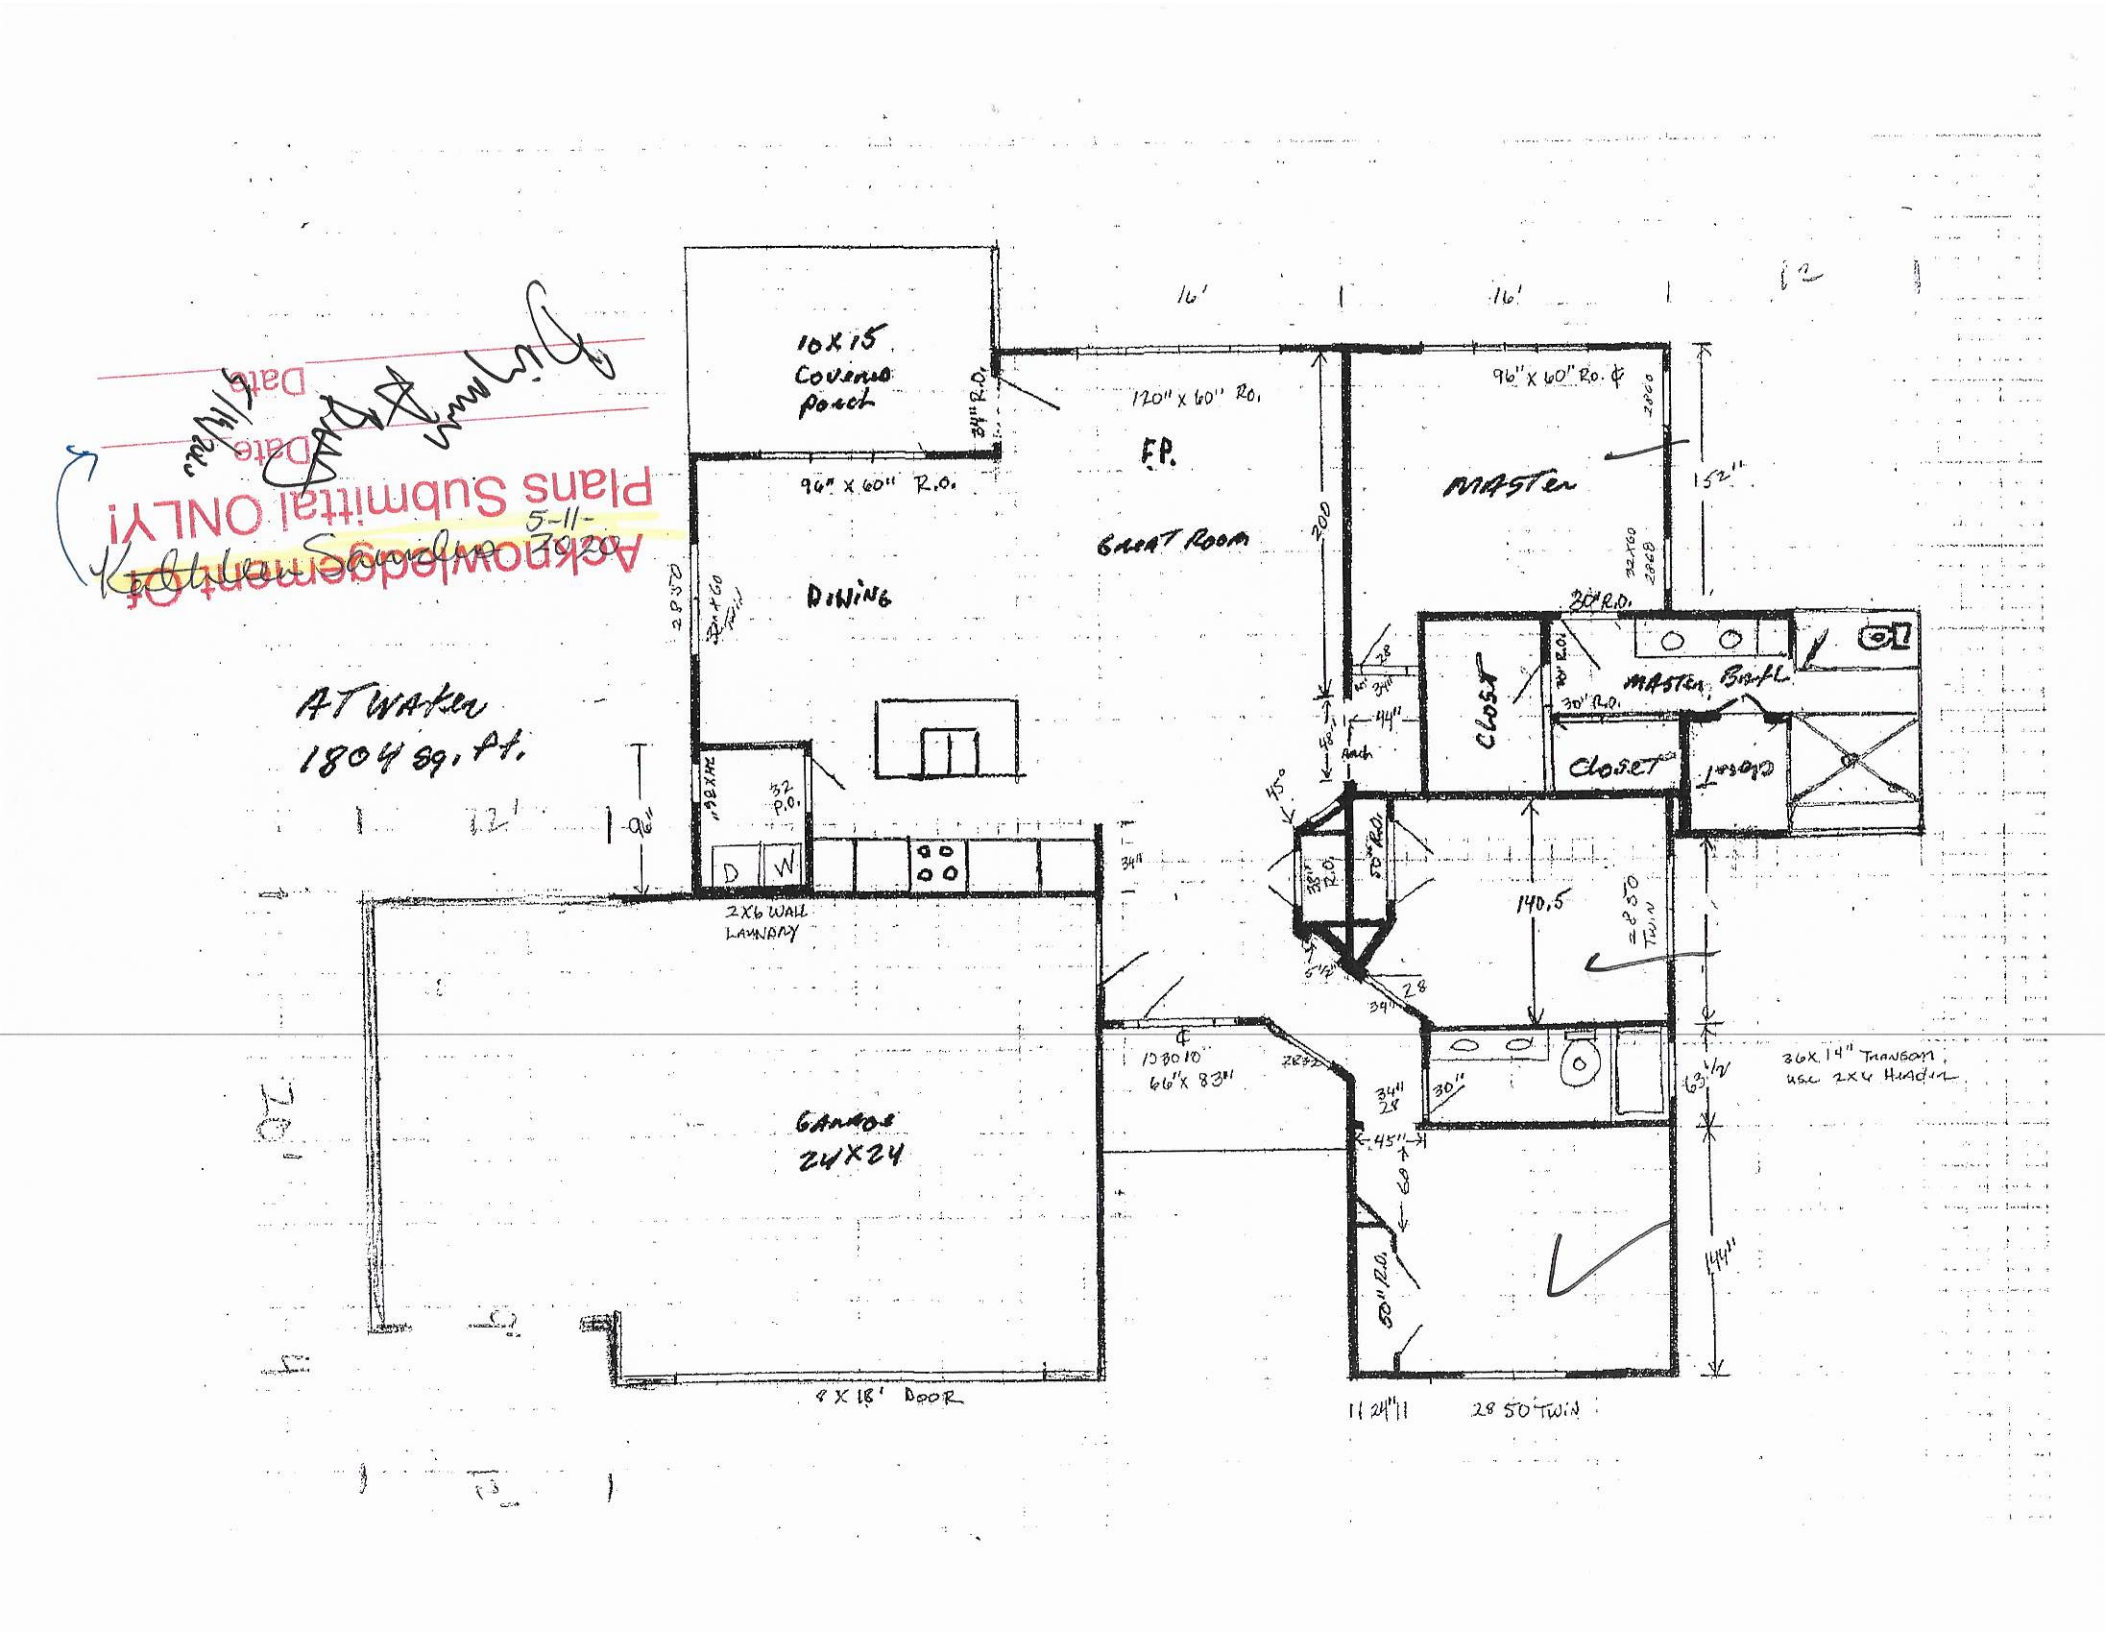

Acknowledgement of Plans Submittal ONLY!
Date 5/11/20
Date 5-11-2020

IREDELL COUNTY · NC

IREDELL COUNTY
PO Box 788
349 North Center St.
Statesville, NC 28677

APPLICATION NUMBER
307449 Issue Date: 05/13/2020

Permit Type: ZONING

Parcel Number	Street Address	Jurisdiction
4715843028.000	191 CASTLE PINES LN	Iredell County

Owner Information	Applicant Information
Name: ST1 LLC	Name: THE OAKS GROUP
Address: PO BOX 3792	Address: 121 HOLT LN
MOORESVILLE, NC 28117	MOORESVILLE, NC 28117
Phone:	Phone: (704)578-4951

Use Requested	Zone Code
Single Family Dwelling	RA

Lot Acreage	F Setback	B Setback	L Setback	R Setback	Watershed	Flood Zone
0.75	35	35	15	15	N/A	NO

Remarks
SFD - NEEDS ZD


The applicant certifies that there are no deed restrictions, contractual agreements or governmental regulations of any kind that interfere with or prohibit the use of the property or the use for which this permit is requested. The applicant further acknowledges that enforcement of deed restrictions, plat conditions and other contractual agreements will not be undertaken by Iredell County and is the sole responsibility of the affected parties.

Signature of Owner/Contractor

Date: 05/13/2020

Permit Number	307449	TOTAL FEES:	$77.25

ZONING DISCLAIMER

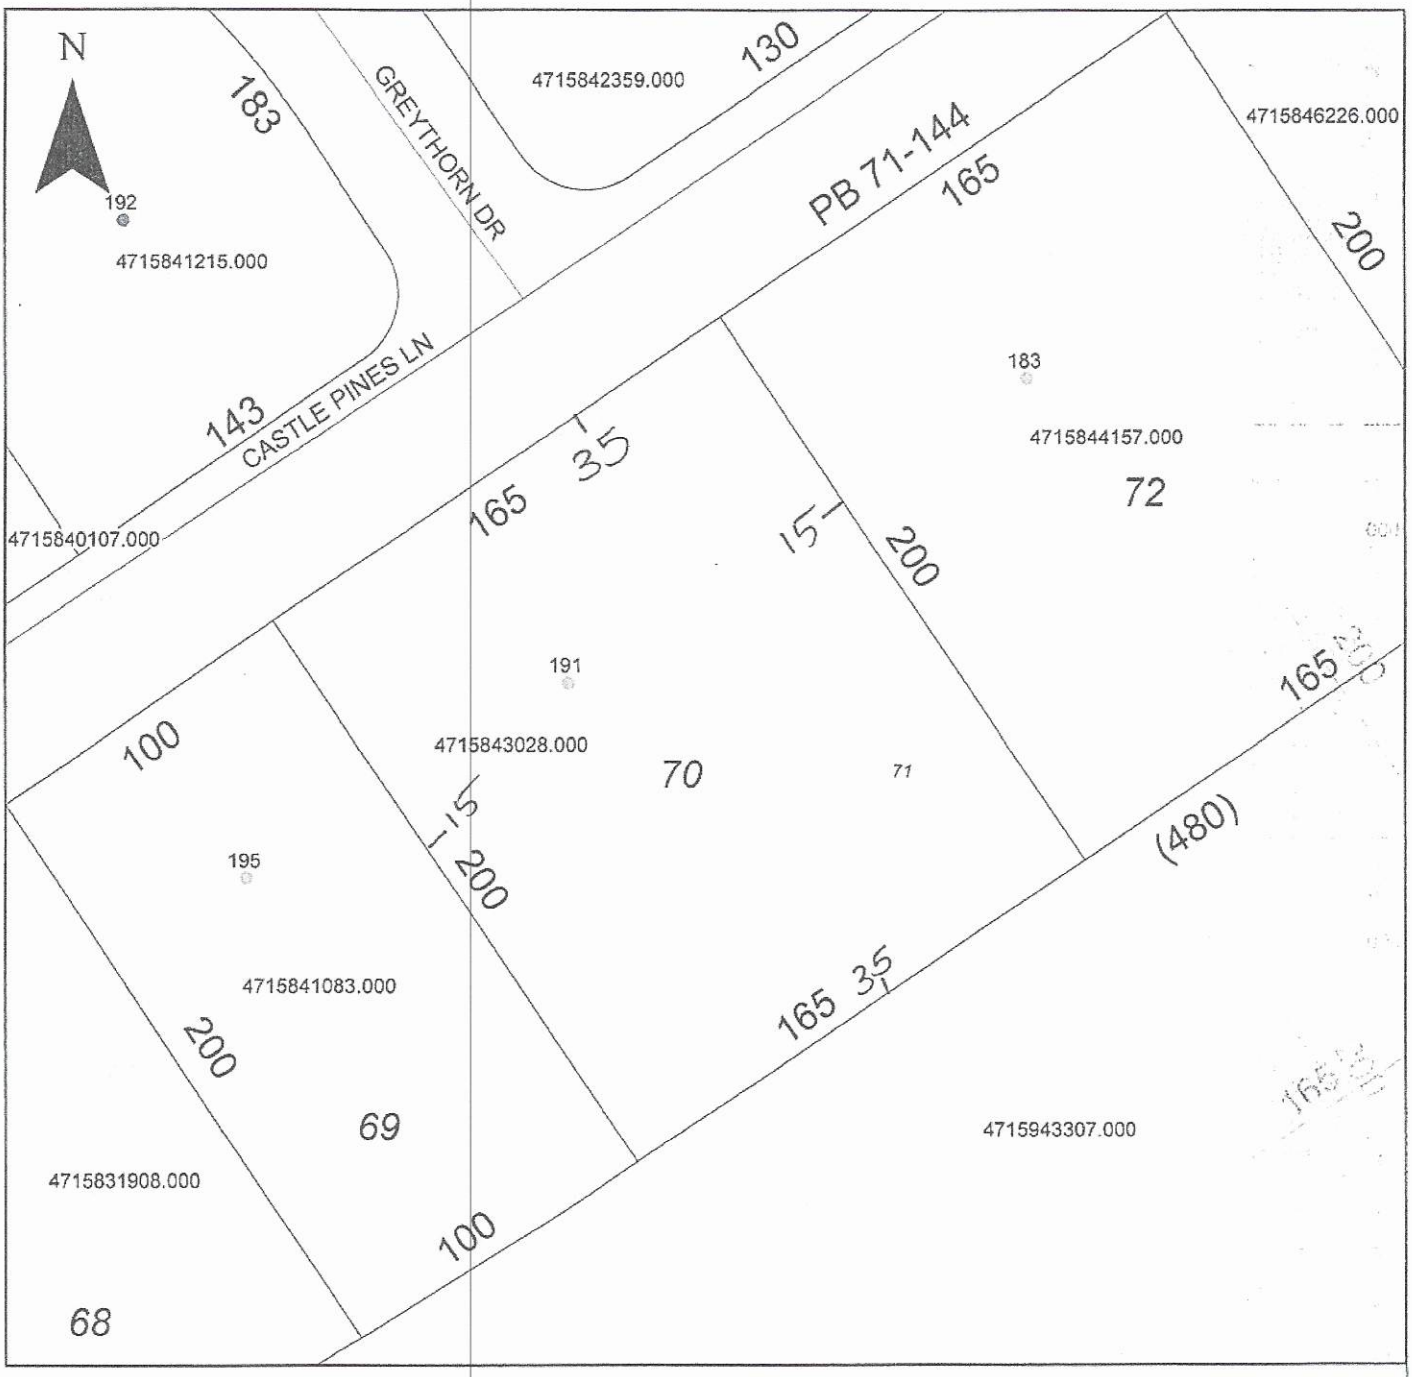

Property Address 191 Castle Pines

The applicant certifies that there are no deed restrictions, contractual agreements or governmental regulations of any kind that interfere with or prohibit the use of the property or the use for which this permit is requested. Applicant further acknowledges that the enforcement of deed restrictions, plat conditions, and other contractual agreements will not be undertaken by Iredell County and is the sole responsibility of the affected parties.

Applicant

Date