IREDELL COUNTY HEALTH DEPARTMENT

Statesville Office (704) 878-5305 Mooresville Office (704) 660-3625 PERMIT # 226497

IMPROVEMENT PERMIT / AUTHORIZATION TO CONSTRUCT / OPERATION PERMIT / EXISTING SYSTEM

PIN # 4715-84-8725 ✓

APPLICANT: Lake Luxury Homes / Castlegate LLC. APPLICANT ADDRESS: 282 Scotts Creek Rd. Statesville, NC 28625

SITE ADDRESS: ✓155 Castle Pines Lane, Statesville, NC PHONE: 704-578-4951 ALT. PHONE:

SITE DIRECTIONS: Rt 64 W from Statesville → R on Taylorsville Highway → L on Absher Farm Rd → L on Staffordshire → L on Castle Pines Lane → Lot on left

SUBDIVISION: Castlegate SECTION: — LOT # 79 LOT AREA: 0.46 acres DESIGN FLOW: 360 GPD L.T.A.R.: 0.30

Septic Tank	1000	(gal)	STB	825	Date	2/26/17	☒ New System	☐ Repair	☐ Expansion
Pump Tank	—	(gal)	PT	—	Date		System Type: I II (III) IV V VI		
Pump Make	—	Model	—	Serial #	—		System Description:	25% Reduction (serial distribution)	
# Nitrification Fields	1	# Lines	4	Linear Ft:	300'		Repair System Description:	50% Reduction (LPP-PPBPS)	
Trench Width	36"	Trench Bottom Depth	36" [high side]	Gravel Depth	—		Maintenance Agreement Required:	☐ YES	☒ NO
								☒ GRAVITY	☐ PRESSURE

☒ Residence	No. Bedrooms	3	Water Supply
☐ Business	No. Persons	6	☐ Private
☐ Other	No. Employees		☒ Public
☒ Slab	☐ Crawl Space		☐ Community
☐ Basement w/plumbing			☐ Basement w/o plumbing

Comments / Conditions: Recommend pumping septic tanks every 3-5 years.


INITIAL SITE SKETCH

See attached plans from The Oaks Group, PA.

Dated 4/25/17

Kathleen Saunders LSS# 1313

AS BUILT SKETCH

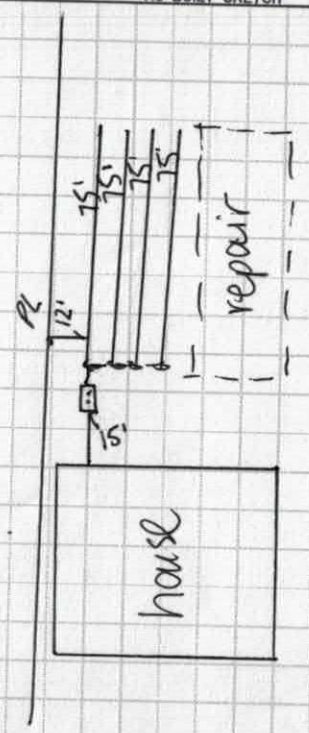

Permit can be suspended or revoked if any false information is supplied toward securing the permit / any unauthorized changes are made to the site / any unauthorized changes are made in the installation of the system. CONTACT A LOCATOR SERVICE PRIOR TO ANY EXCAVATION

☒ IMPROVEMENT PERMIT *with plat* valid without expiration. ☐ IMPROVEMENT PERMIT *with site plan* valid for 60 mos. ☒ AUTHORIZATION TO CONSTRUCT valid for period equal to IMPROVEMENT PERMIT--not to exceed 60 mo.

Owner / Applicant Signature: Emma Holt Date: 5/10/17 Installed by: Raven Sloop

IMPROVEMENT PERMIT by: Tom Shuck Date: 5/10/2017 OPERATION PERMIT by: Carla C. Cave Date: 4/17/18

AUTHORIZATION TO CONSTRUCT by: Benjamin D. Bolton Date: 11/9/2017 Existing System Inspected by: Date:

Health Dept. Copy - WHITE Applicant (Final Approval) - YELLOW Applicant (Site) - PINK

Notes:

1) This property may be subject to any Easements, Rights-of-way, and/or Restrictive Covenants.

2) Boundary information based on Map Book: 54 at Page: 98 as recorded in the Iredell County Register of Deeds.


3) No N.C.G.S. or U.S.G.S. Monuments could be located within 2000'.

4) Area by coordinate method.

5) This survey is of an existing

Legend

R/W = Right-of-way
I.P.S. = #4 Rebar Set
B.O.C. = Back of Curb
~\/~ = Not to scale
= Telephone Pedestal
= Utility Pole
= Cable Pedestal

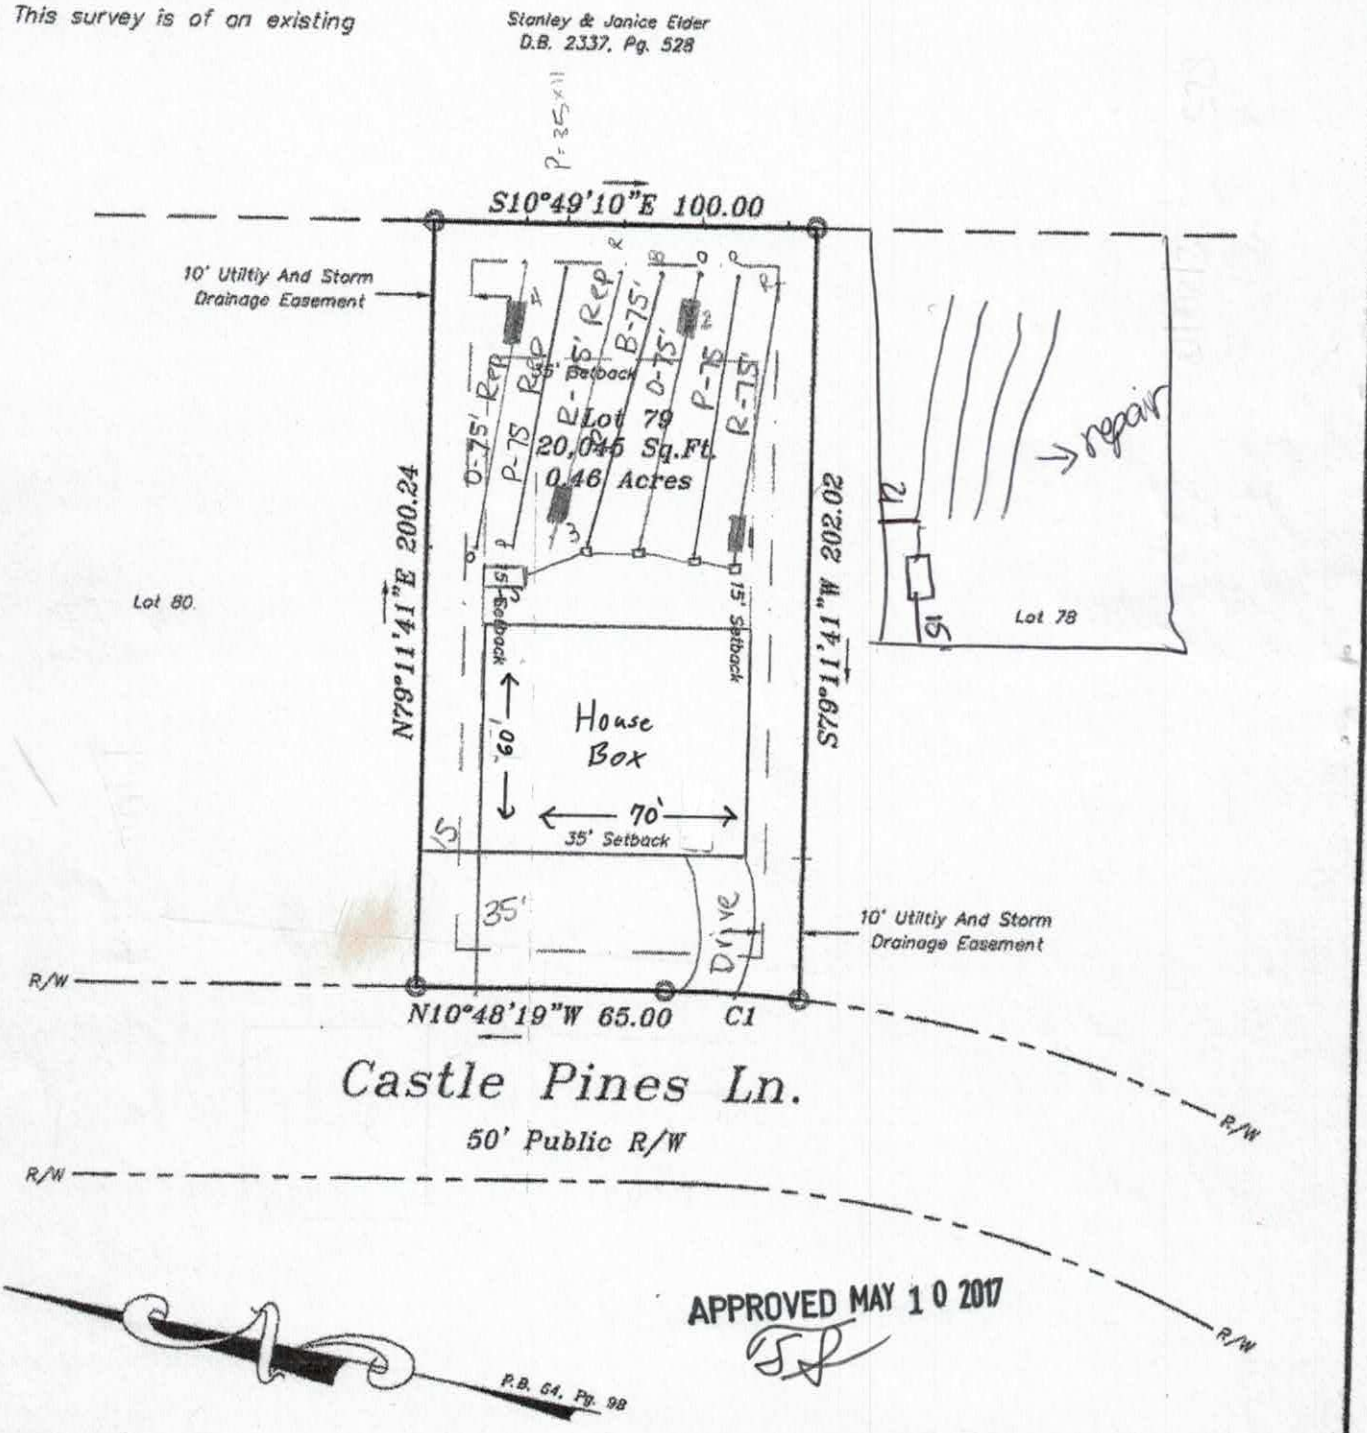

APPROVED MAY 10 2017

CURVE TABLE				
CURVE	LENGTH	RADIUS	BEARING	CHORD
C1	35.06	350.00	N07°56'08"W	35.04

GRAPHIC SCALE

50 0 25 50 100

(IN FEET)
1 inch = 50 ft.

THE OAKS GROUP, PA

To: Iredell County Environmental Health Department (ICHD)

From: Kathleen Saunders, LSS

RE: 155 Castle Pines Lane

Date: April 25, 2017

Attached is the septic specification information required to permit the 155 Castle Pines Lane for an Improvement Permit and/or Construction Authorization Permit in Iredell County via the Expedited Review Process.

The attached information is not an Improvement Permit or an Authorization to Construct, and is only to assist the ICHD with permitting. The ICHD has to approve each lot and only the ICHD can issue these permits. The system should be installed according to the ICHD permits, policies, and NC Rules, which these specifications are in accordance with. If the ICHD wishes to change tank locations, distribution devices, etc they may do so at their discretion.

All information and specifications have been prepared in conjunction with ICHD permitting guidelines for the current lot owners to acquire an Improvement Permit and/or Authorization to Construct on this lot. It is ultimately the ICHD's responsibility to verify all specifications, including soil descriptions, before permitting and/or septic system installation.

LICENSED SOIL SCIENTIST
KATHLEEN M. SAUNDERS
1313
STATE OF NORTH CAROLINA

Kathleen Saunders

Lot 79 Castlegate Fast Track - The Oaks Group, PA

Number of Bedrooms	**3**
Basement or Crawl	**Concrete Slab/Crawl Space**
Design Flow (gpd)	**360**
Primary System LTAR (gpd/ft2)	**0.3**
Primary System Type	**25% Reduction**
No. Lines	4 (See Table)
Total Linear Feet	300
Trench Width	3' min.
Trench Spacing	9' min.
Distribution Device	Drop Boxes or Other
Tank Size	1000 gallon tank
Max Trench Bottom Depth (High Side)	36"
Maintenance Agreement Required	No
Repair System	**LP PPBPS**
Total Linear Feet	225
Repair Loading Rate	0.3

Table: Summary of Primary and Repair Nitrification Line Specifications

Line No.	Use	Line Color	System Type	Line Length (Ft.)
1	Repair	Orange	LP PPBPS	75
2	Repair	Pink	LP PPBPS	75
3	Repair	Red	LP PPBPS	75
4	System	Blue	25% Reduction	75 endfed
5	System	Orange	25% Reduction	75 endfed
6	System	Pink	25% Reduction	75 endfed
7	System	Red	25% Reduction	75 endfed
				Total System: 300'
				Total Repair: 225'

Note: Keep necessary setbacks to foundation drains if used
Tank locations and distribution devices can be altered at ICHD's discretion

APPROVED MAY 10 2017

DEPARTMENT OF HEALTH AND HUMAN SERVICES
DIVISION OF PUBLIC HEALTH, ENVIRONMENTAL HEALTH SECTION
ON-SITE WATER PROTECTION BRANCH

Sheet 1 of 1
PROPERTY ID #: 4715848785
COUNTY: Iredell

SOIL/SITE EVALUATION
for **ON-SITE WASTEWATER SYSTEM**
(Complete all fields in full)

OWNER: Castlegate
ADDRESS: 282 Scotts Creek Rd Statesville
PROPOSED FACILITY: SFR
PROPOSED DESIGN FLOW (.1949): 360
LOCATION OF SITE: Castlegate 79
APPLICATION DATE: 4/25/17
DATE EVALUATED: 4-12-17
PROPERTY SIZE: 0.46
PROPERTY RECORDED: yes

WATER SUPPLY: ☐ Private ☒ Public ☐ Well ☐ Spring ☐ Other
EVALUATION METHOD: ☐ Auger Boring ☒ Pit ☐ Cut
TYPE OF WASTEWATER: ☒ Sewage ☐ Industrial Process ☐ Mixed

PROFILE #	.1940 LANDSCAPE POSITION/ SLOPE %	HORIZON DEPTH (IN.)	SOIL MORPHOLOGY (.1941) .1941 STRUCTURE/ TEXTURE	.1941 CONSISTENCE/ MINERALOGY	OTHER PROFILE FACTORS .1942 SOIL WETNESS/ COLOR	.1943 SOIL DEPTH	.1956 SAPRO CLASS	.1944 RESTR HORIZ	PROFILE CLASS & LTAR
1	L ~8%	0-31	Mo SBK C	FR SS/SP	R	48"	PS	N/A	0.3
		31-48	WK SBK CL	↓	yel R; C Sap				
		48-60	MA L Sap	↓	yel Br				
2	L ~8%	0-29	Mo ABK C	FR SS/SP	R	54"	PS	N/A	0.3
		29-54	WK SBK CL	↓	R yel; C Sap				
		54-65	MA L Sap	↓	yel R				
3	L ~8%	0-18	Mo SBK C	FR SS/SP	R	45"	PS	N/A	0.3
		18-45	WK SBK CL	↓	R yel; C/M Sap				
		45-70	MA L Sap	↓	yel Br				
4	L 8%	0-24	Mo SBK C	FR SS/SP	R	44"	PS	44"	0.3
		24-44	WK SBK CL	↓	R yel; C Sap				
		44-54	Quartz						
		54-67	MA L Sap	FR SS/SP	yel R				

DESCRIPTION	INITIAL SYSTEM	REPAIR SYSTEM
Available Space (.1945)	yes	yes
System Type(s)	IIIg	IV
Site LTAR	0.3	0.3

OTHER FACTORS (.1946): N/A
SITE CLASSIFICATION (.1948): RS
EVALUATED BY: LMS
OTHER(S) PRESENT: Tom Shuck (5/8/17) Pits 3+2

COMMENTS:

APPROVED MAY 10 2017

Updated February 2014

Non expiring

IREDELL COUNTY HEALTH DEPARTMENT

ENVIRONMENTAL HEALTH DIVISION

PAGE 1: *APPLICATION FORM*

Application For: ( ) New Well Permit ( ) Well Repair Permit ( ) Well Abandonme
Septic Improvement Permit (X) *Authorization to Construct* ( ) *Existing System Inspection* ( ) *Septic System Re*

THE ABOVE PERMIT DOCUMENTS WILL BECOME INVALID IF INFORMATION PROVIDED ON THIS APPLICATION IS FALSIFIED OR CHANGED, OR IF THE S IS ALTERED. THE IMPROVEMENT PERMIT IS VALID FOR EITHER 60 MONTHS OR WITHOUT EXPIRATION DEPENDING UPON DOCUMENTATION SUBMIT APPLICATION WITH SITE PLAN 60 MONTHS, APPLICATION WITH COMPLETE, SCALED PLAT WITHOUT EXPIRATION. SEE 15A NCAC 18A .1937(f) FOR DETA

Page 2: *Site Plan Worksheet* form MUST accompany this application

The following optional attachments may also be submitted: (X) Survey Plat, scaled no more than 1 inch = 60 feet
Place an (X) beside whichever is submitted if applicable ( ) Custom Site Plan, scaled no more than 1 inch = 60 f

Applicant Information: Contact Kathleen Saunders (704) 578-4951

Applicant Name: Lake Luxury Homes Castlegate LLC Address: 282 Scotts Creek Rd Statesville 28625 Phone: _____

Owner Name: Same Address: _____ Phone: _____

Property Information:

Street Address: 155 Castle Pines Ln Statesville

Subdivision Name: Castlegate Section/Phase: _____ Lot Number: 79

Driving Directions: Interstate 40, exit on to Hwy 64, Right on Taylorsville Hwy, L on Absher Farm Loop, L on Staffordshire, L on Castle Pines lot on left

Site Development Information: *(check or complete ALL that apply)*

(X) New Single Family Residence
( ) New Multi-Family Residence
( ) Accessory Building
( ) Bedroom(s) Addition

Maximum Number of Bedrooms: 3
Maximum Number of Occupants: 6 max
( ) Swimming Pool
( ) Other Addition/Structure: _____

( ) Crawl Space Foundation
(X) Concrete Slab Foundati
( ) Basement with Plumbin
( ) Basement without Plumi

Non-Residential Site Development:

Type of Business: _____
Square Footage of Building: _____
Maximum Number of Employee: _____
Maximum Number of Seats/Beds/Other: _____

Water Supply:

( ) New Well ( ) Existing Well ( ) Community Well ( ) City Water (X) Other Public Water

Desired Septic System Type: *(you may rank in order of preference)* Year existing system installed: _____
( ) No Preference ( ) Alternative ( ) Conventional ( ) Innovative ( ) Modified Conventional ( ) Other: _____

Please answer the following to the best of your ability:

( ) Yes (X) No Does the site contain any jurisdictional wetlands?
( ) Yes (X) No Is any non-domestic sewage (i.e. industrial) to be generated?
( ) Yes (X) No Is the site subject to approval by any other public agency?

I have read this application and certify that the information provided herein is true, complete, and correct. Authorized county and state officials are gran right of entry to conduct necessary inspections to determine compliance with applicable laws and rules. I understand that I am solely responsible for proper identification and labeling of all property lines and corners and making the site accessible so that a complete site evaluation can be performed.

Signature: Emma Kelly Kathleen Saunders 11/8/17
Property owner or owner's legal representative signature (SIGNATURE REQUIRED) DATE

AUTHORIZATION TO ACT AS AGENT FOR OWNER

Any application/document/permit requiring a signature must be signed by the property owner or their authorized agent. This form shall be provided by the owner to allow specified individuals to act as agents for the owner. This form allows the specified individuals to sign or receive any application/document/permit on behalf of the owner. This form allows the authorized agent to make decisions on behalf of the owner pertaining to modifications of permits in the field. It is the responsibility of the owner to assure that any/all permit conditions specified on permits issued by this Division are followed.

I, Ray Short, am the legal owner of the property located at 155 Castle Pines Dr, identified as PIN(Parcel Identification Number) 4715 84 8725, located in Iredell County, North Carolina.

I do hereby authorize (print authorized agent/company name) The Oaks Group, PA, _____, _____, _____, to act as an agent on my behalf in applying for/signing/obtaining any of the documents described below.

1. Improvement Permit (IP)/ Authorization to Construct (AC).
2. Application for soil-site evaluation (new/repair).
3. Application/permit for water well/well abandonment.
4. Application for existing system.
5. Application for Improvement Permit (IP)/ Authorization to Construct (AC).

I agree to abide by any and all decisions and/or conditions between the agent acting on my behalf and the Iredell County Department of Public Health, Environmental Health Division. This form must be fully executed before the individual's specified above will be recognized as the authorized agent.

_____ 11-8-17
Signature of Owner Date

_____ _____
Signature of Witness Date

KEDELL COUNTY HEALTH DEPARTMENT ENVIRONMENTAL HEALTH DIVISION:

SITE PLAN WORKSHEET

SEE THE "SAMPLE SITE PLAN" BELOW. *INCOMPLETE SITE PLANS WILL BE RETURNED TO YOU FOR COMPLETION AND MAY RESULT IN A DELAY IN THE ISSUANCE OF YOUR SEPTIC SYSTEM PERMIT!!!*

Place an (X) beside each item as you complete the site plan:


- X Property Line measurements are clearly identified...
- X All proposed structures are indicated...

SHOW: proposed house or business footprint, wells, water lines, patios, pools and decks, and any other item that will occupy space on the site

- X Front and side setbacks from property line...
- X Area you prefer your septic system to be placed...
- X Preferred driveway location and configuration, preferred well location...
- X North arrow, or other sufficient indicator of direction...

Circle N/A on the following if appropriate:

- ___ Location of septic systems and wells within 100' of your property... (N/A)
- ___ Location of easements and rights of ways on your property... (N/A)
- ___ Location of any designated wetlands on the property... (N/A)

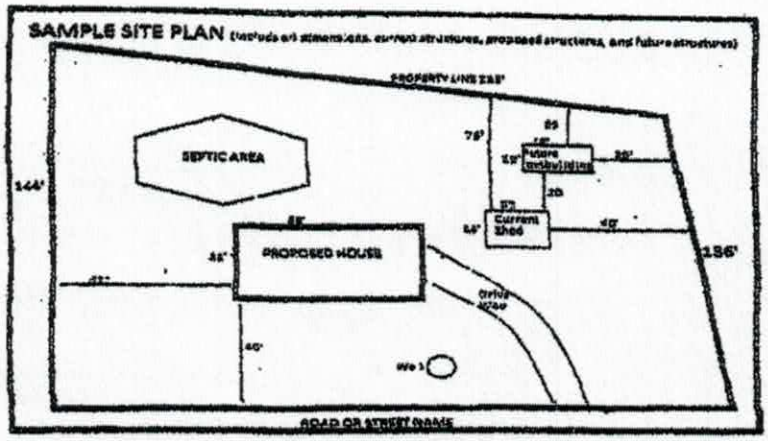

USE THIS SPACE TO DRAW YOUR SITE PLAN

Please see attached site plan

Signature: Emma Hall / Kathleen Saunders
REQUIRED property owner or owner's legal representative signature.

11/8/17
DATE

1) This property may be subject to any Easements, Rights-of-way, and/or Restrictive Covenants.

2) Boundary information based on Map Book: 54 at Page: 98 as recorded in the Iredell County Register of Deeds.


3) No N.C.G.S. or U.S.G.S. Monuments could be located within 2000'.

4) Area by coordinate method.

5) This survey is of an existing property.

Legend

R/W = Right-of-way
I.P.S. = #4 Rebar Set
B.O.C. = Back of Curb
~ = Not to scale
= Telephone Pedestal
= Utility Pole
= Cable Pedestal

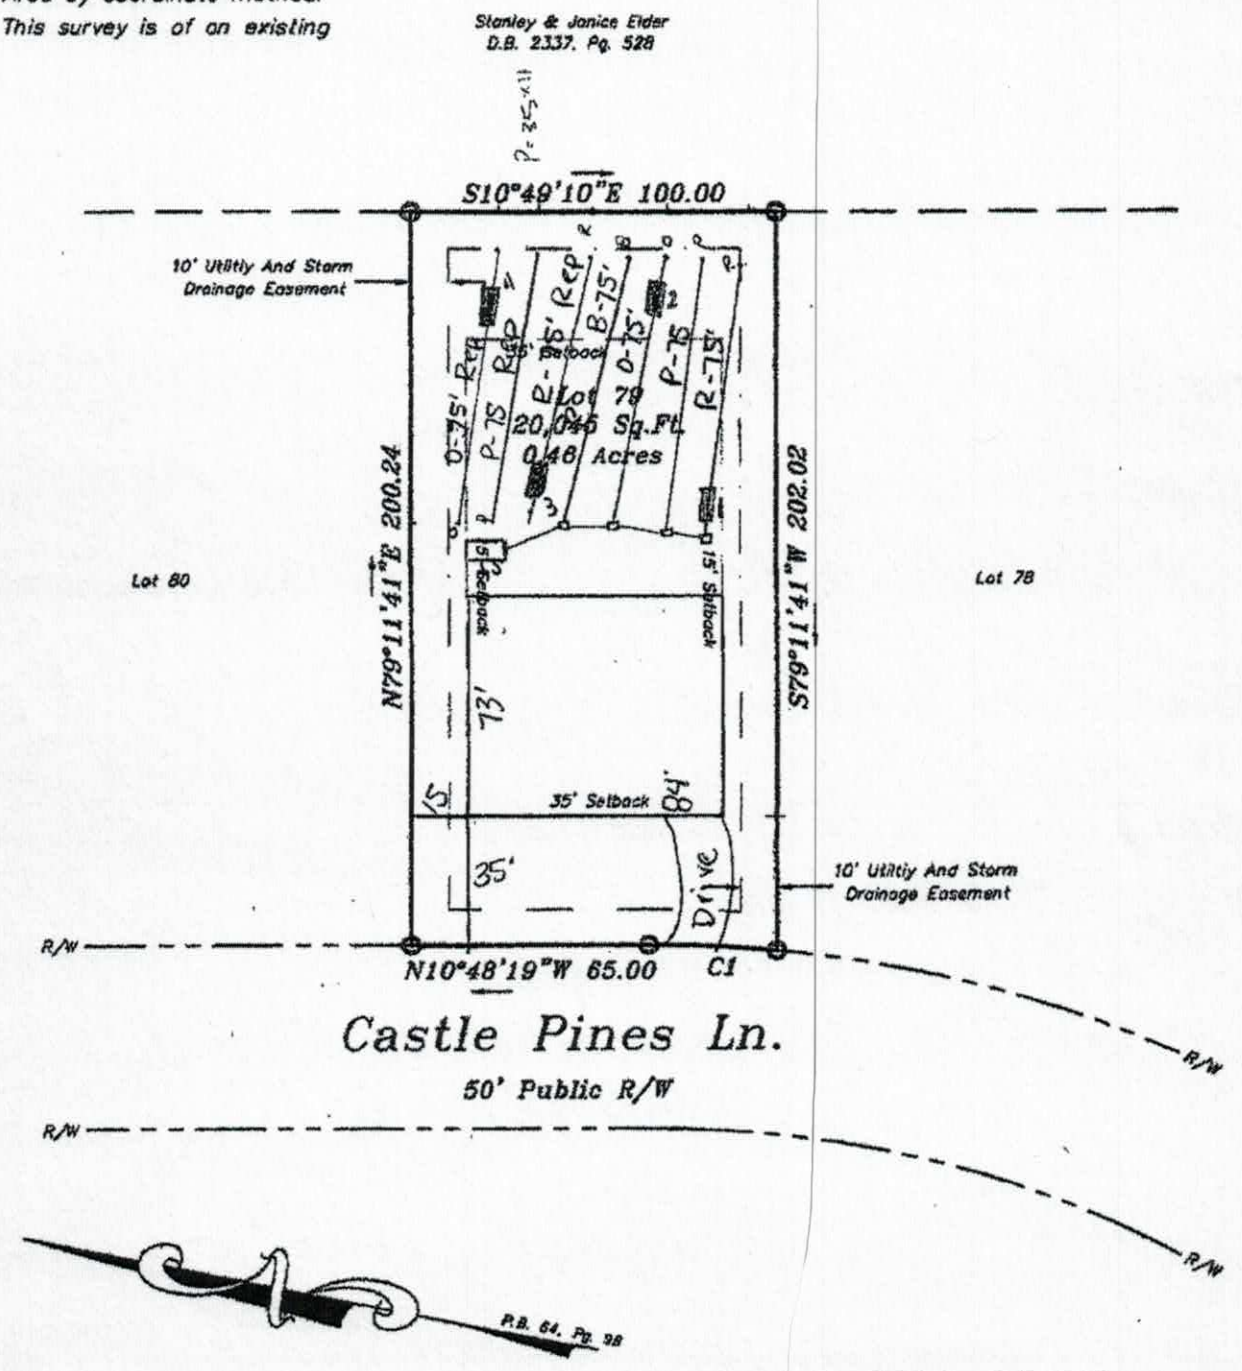


CURVE TABLE				
CURVE	LENGTH	RADIUS	BEARING	CHORD
C1	35.06	350.00	N07°56'08"W	35.04

GRAPHIC SCALE

50 0 25 50 100

(IN FEET)

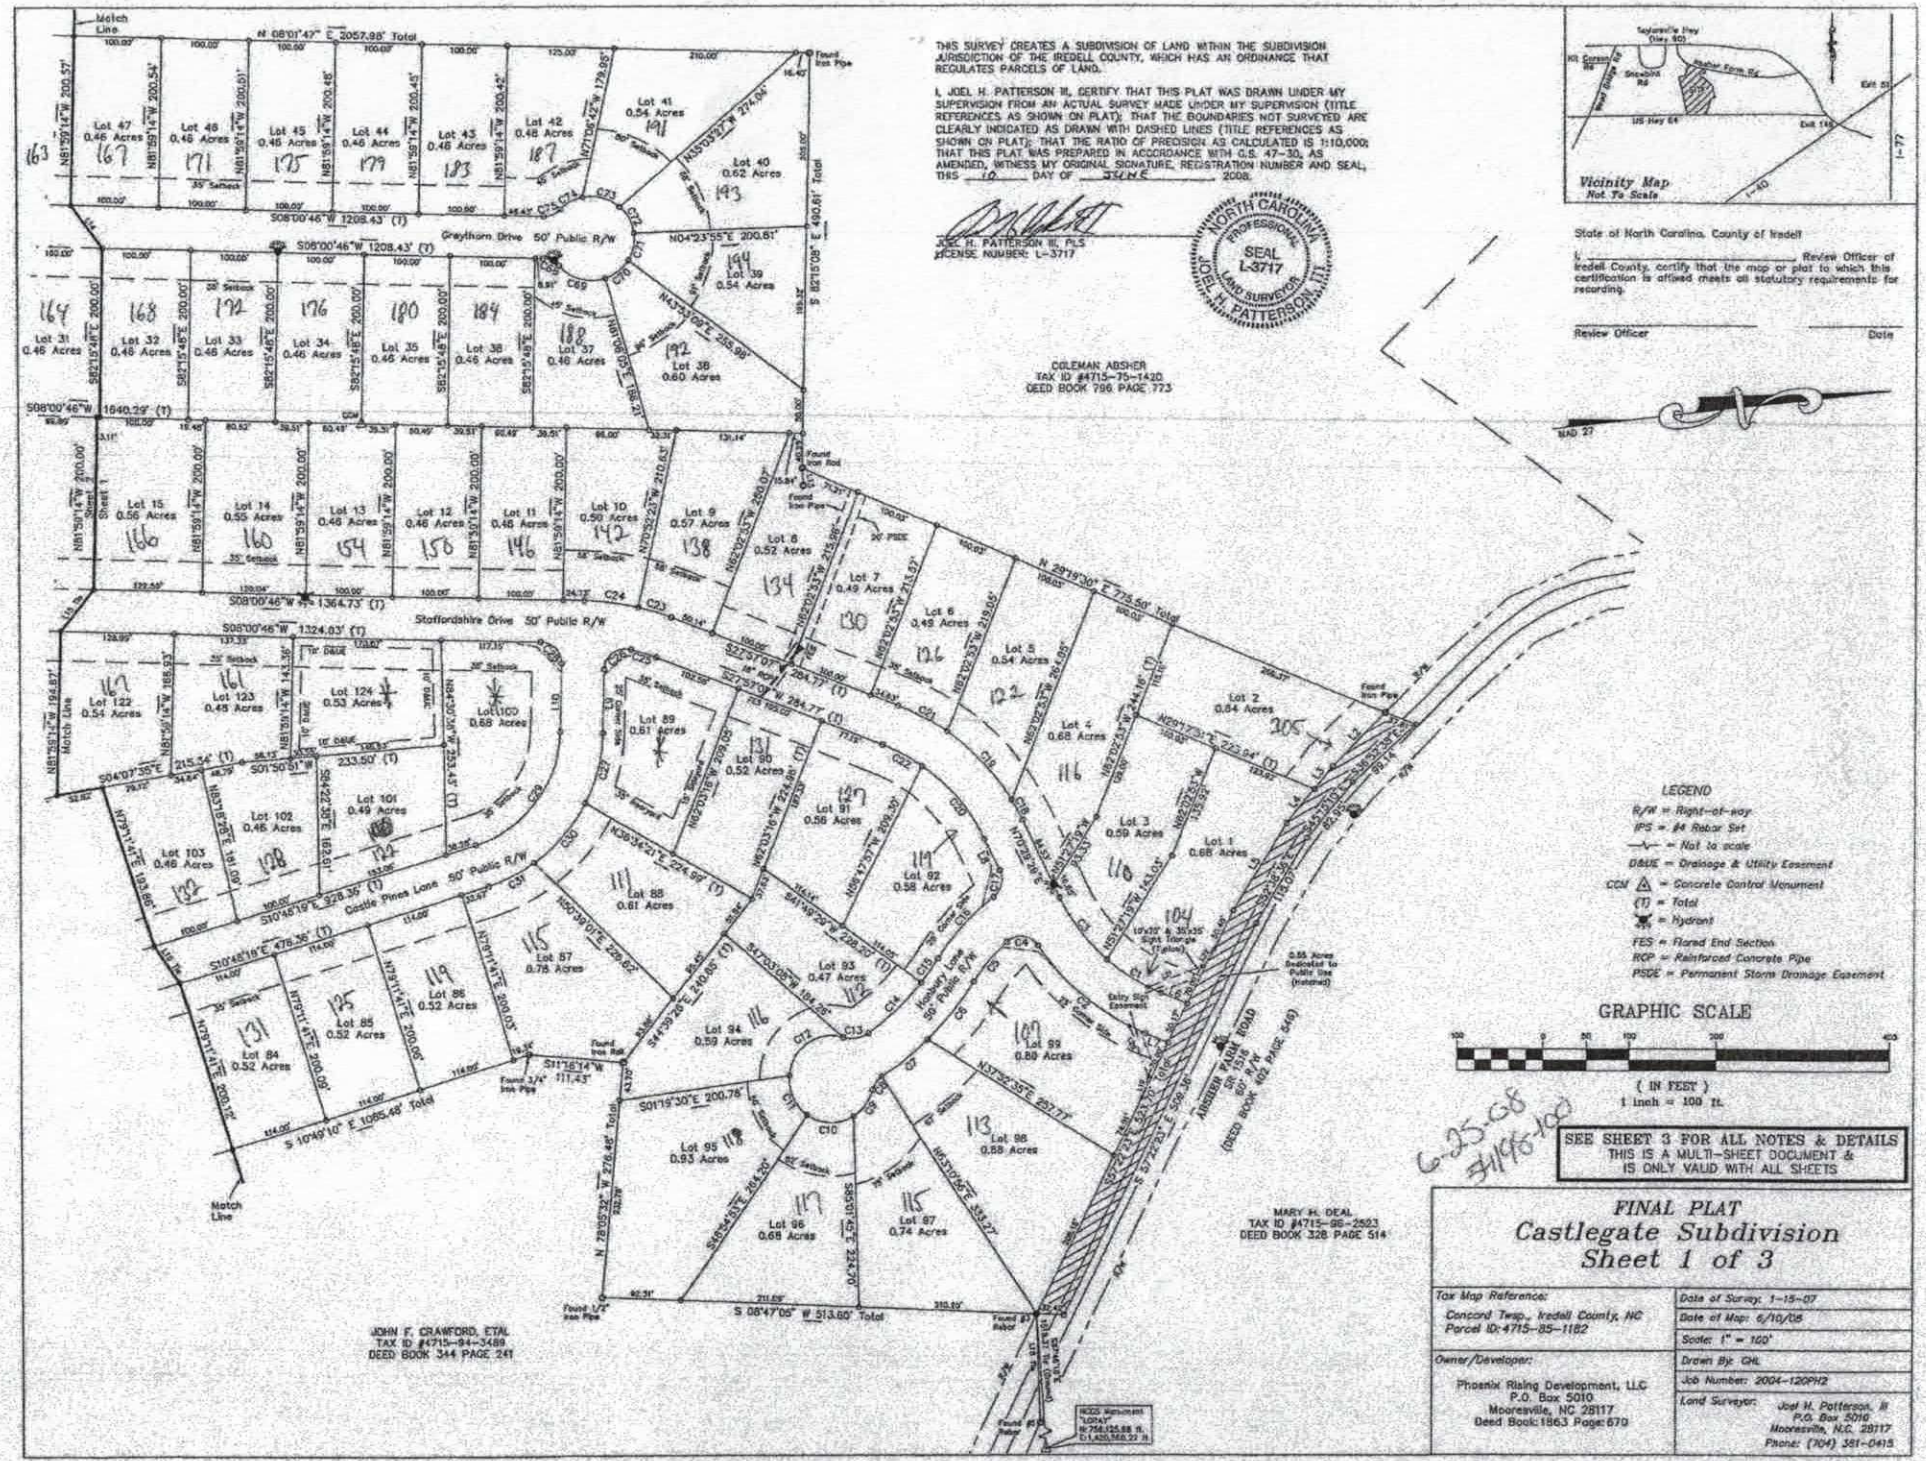

THIS SURVEY CREATES A SUBDIVISION OF LAND WITHIN THE SUBDIVISION JURISDICTION OF THE IREDELL COUNTY, WHICH HAS AN ORDINANCE THAT REGULATES PARCELS OF LAND.

I, JOEL H. PATTERSON III, CERTIFY THAT THIS PLAT WAS DRAWN UNDER MY SUPERVISION FROM AN ACTUAL SURVEY MADE UNDER MY SUPERVISION (TITLE REFERENCES AS SHOWN ON PLAT); THAT THE BOUNDARIES NOT SURVEYED ARE CLEARLY INDICATED AS DRAWN WITH DASHED LINES (TITLE REFERENCES AS SHOWN ON PLAT); 

JOEL H. PATTERSON III, PLS
LICENSE NUMBER: L-3717

NORTH CAROLINA PROFESSIONAL SEAL L-3717 LAND SURVEYOR JOEL H. PATTERSON, III

Vicinity Map
Not To Scale

State of North Carolina, County of Iredell

I, _____, Review Officer of Iredell County, certify that the map or plat to which this certification is affixed meets all statutory requirements for recording.

Review Officer _____ Date _____

LEGEND
R/W = Right-of-way
IPS = #4 Rebar Set
~ = Not to scale
D&UE = Drainage & Utility Easement
CCM = Concrete Control Monument
(T) = Total
= Hydrant
FES = Flared End Section
RCP = Reinforced Concrete Pipe
PSDE = Permanent Storm Drainage Easement

GRAPHIC SCALE
(IN FEET)
1 inch = 100 ft.

6-25-08
3/196-100

SEE SHEET 3 FOR ALL NOTES & DETAILS
THIS IS A MULTI-SHEET DOCUMENT & IS ONLY VALID WITH ALL SHEETS

FINAL PLAT
Castlegate Subdivision
Sheet 1 of 3

Tax Map Reference: Concord Twp., Iredell County, NC Parcel ID: 4715-85-1182	Date of Survey: 1-15-07
	Date of Map: 6/10/08
	Scale: 1" = 100'
Owner/Developer: Phoenix Rising Development, LLC P.O. Box 5010 Mooresville, NC 28117 Deed Book: 1963 Page: 679	Drawn By: GHL
	Job Number: 2004-120PH2
	Land Surveyor: Joel H. Patterson, III P.O. Box 5010 Mooresville, N.C. 28117 Phone: (704) 381-0415

Lot 79 Castlegate

Acknowledgement of Plans Submittal ONLY!

Kathleen Saunders Date 11/8/17

Benjamin Bethune Date 11/9/2017


FRANK BETZ ASSOCIATES, INC. ASSUMES NO LIABILITY FOR ANY CHANGES OR MODIFICATIONS MADE TO RISER PLANS BY OTHERS

FLOOR PLAN

SCALE: 1/4"=1'-0"

SQUARE FOOTAGE	
FLOOR PLAN	SQ FT

Finish - 2474 SF

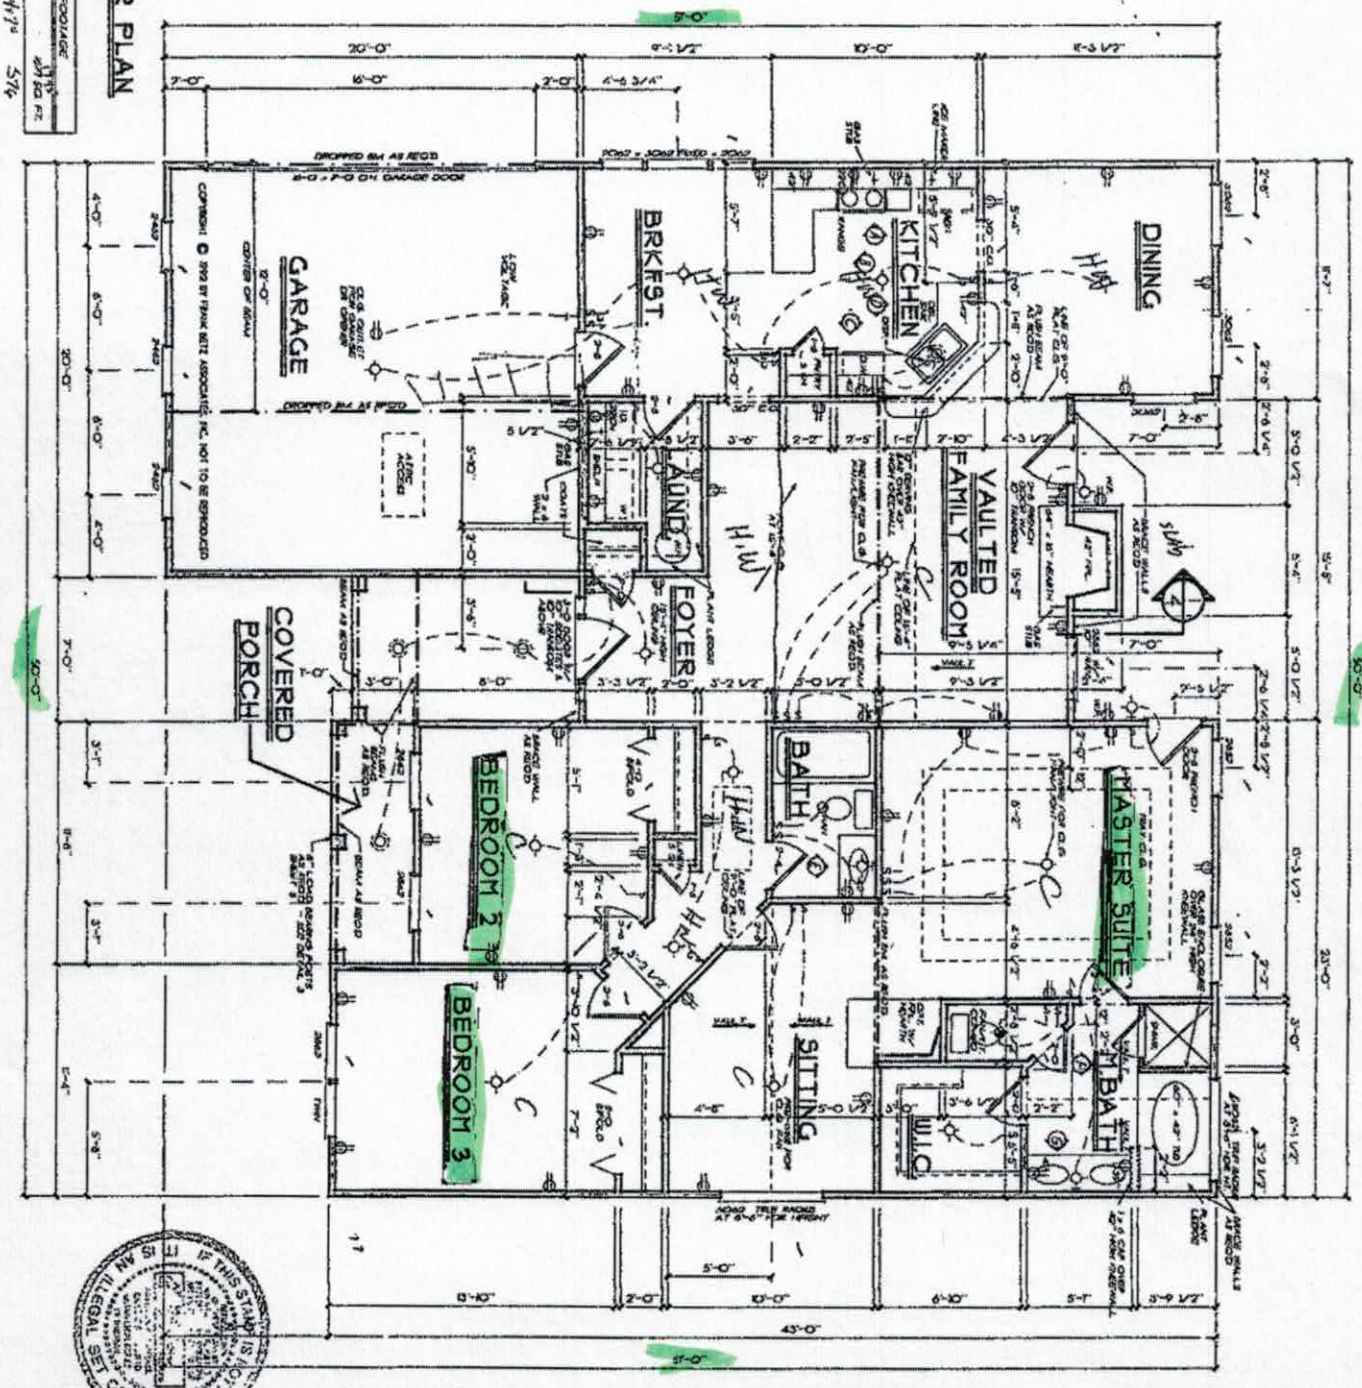

IF THIS STAMP IS NOT ON THE PLANS, THEY ARE AN ILLEGAL SET OF PLANS

SHEET	DATE	SCALE
3 of 5	7-10-97	1/4" = 1'-0"

FBA

FRANK BETZ ASSOCIATES, INC.

1600 LAKE PARK DRIVE/SUITE 101
SMYRNA, GEORGIA 30080
770/438-0858

FLOOR PLAN

THE MARSHALL

HOMEPLANS

DATE	REV	DATE	REV
2-27-98	CLAY M-12		
4-20-98	CLAY M-13		

THESE PLANS ARE THE PROPERTY OF FRANK BETZ ASSOCIATES, INC. AND ARE NOT TO BE REPRODUCED, MODIFIED OR USED IN ANY WAY WITHOUT THE WRITTEN PERMISSION OF FRANK BETZ ASSOCIATES, INC.

IREDELL COUNTY

PO Box 788
349 North Center St.
Statesville, NC 28677

APPLICATION NUMBER
226497
Issue Date: 04/21/2017

ZONING PERMIT

Open Space

Parcel Number	Street Address	Jurisdiction
4715848725.000	155 CASTLE PINES LANE, STATESVILLE, NC	IREDELL COUNTY

Owner Information	Applicant Information
Owner: CASTLEGATE LLC	Applicant: KATHLEEN SAUNDERS
Address: 282 SCOTTS CREEK RD STATESVILLE, NC 28625	Address: 121 HOLT LANE MOORESVILLE, NC 28117
Phone:	Phone: 704-578-4951

Use Requested	Zone Code
SFD	RA

Lot Acreage	F Setback	B Setback	L Setback	R Setback	Watershed	Flood Zone
.460	35.00	35.00	15.00	15.00	NOT	X


Remarks:

The applicant certifies that there are no deed restrictions, contractual agreements or governmental regulations of any kind that interfere with or prohibit the use of the property or the use for which this permit is requested. The applicant further acknowledges that enforcement of deed restrictions, plat conditions and other contractual agreements will not be undertaken by Iredell County and is the sole responsibility of the affected parties.

Applicant: _____ Date: _____

Permit Number	100337	TOTAL FEES:	$ 77.25

ZONING DISCLAIMER

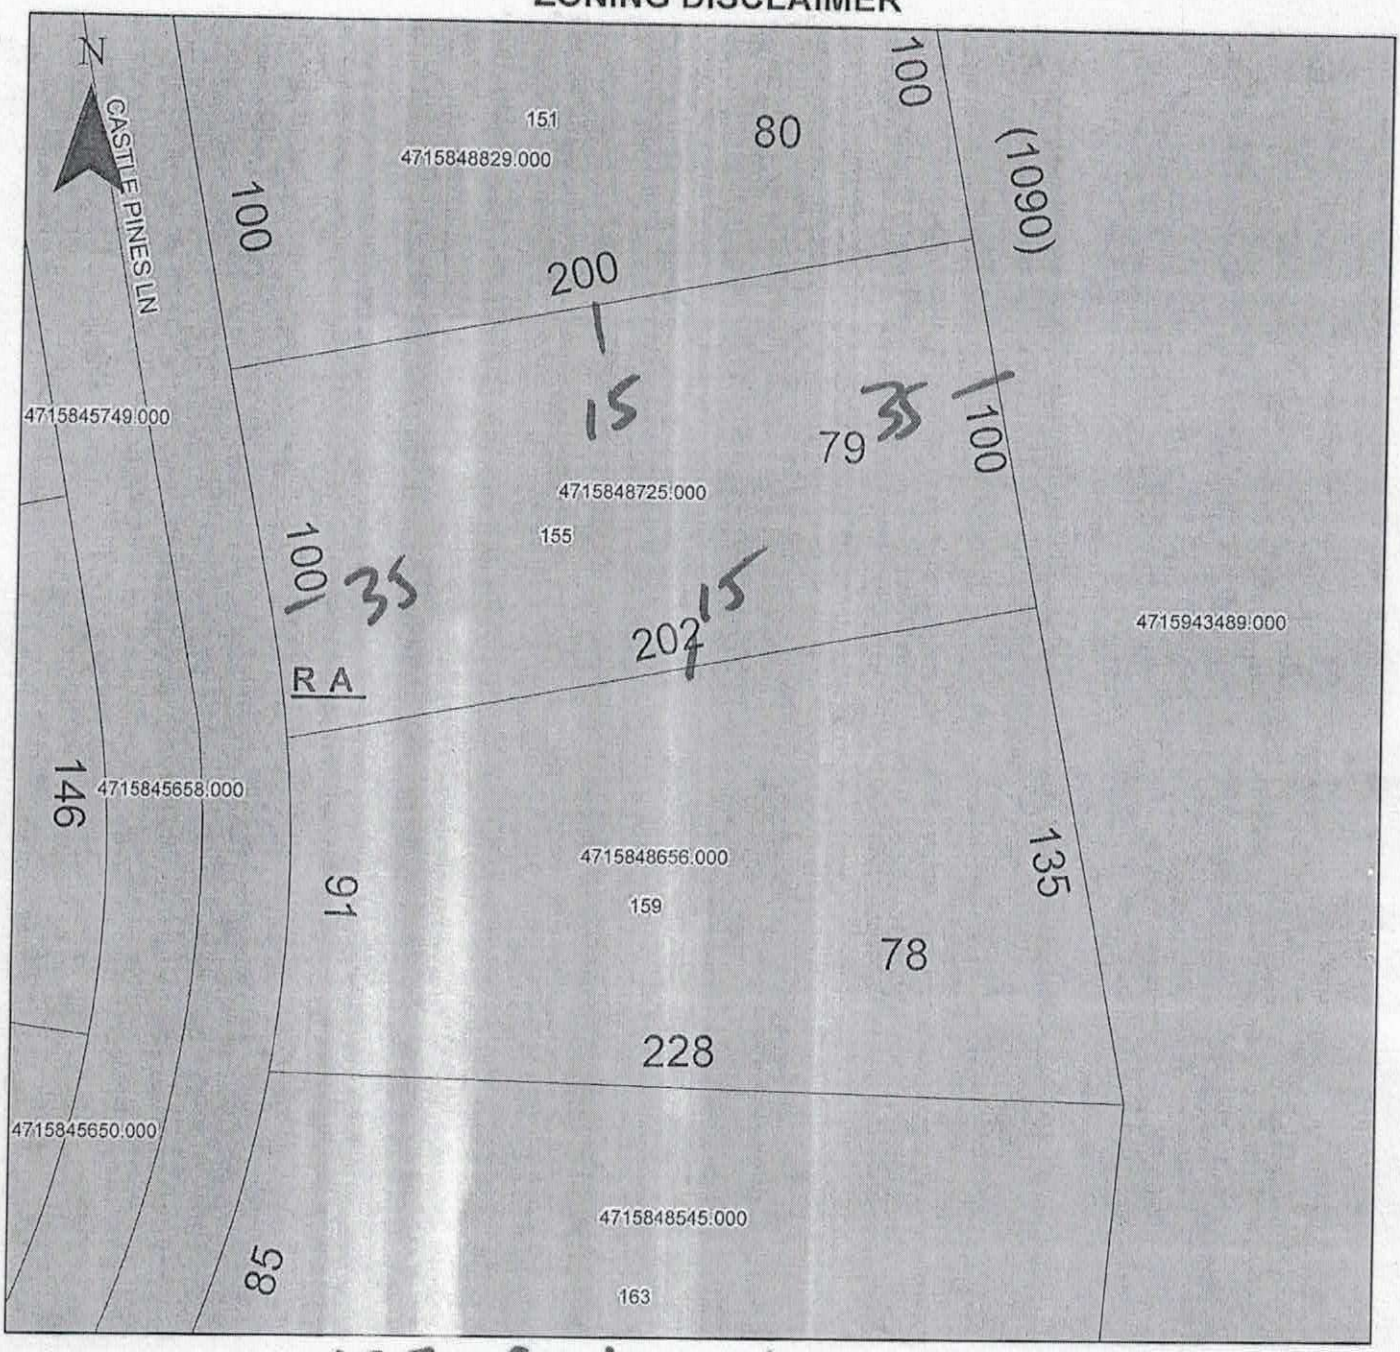

Property Address 155 Castle Pines

The applicant certifies that there are no deed restrictions, contractual agreements or governmental regulations of any kind that interfere with or prohibit the use of the property or the use for which this permit is requested. Applicant further acknowledges that the enforcement of deed restrictions, plat conditions, and other contractual agreements will not be undertaken by Iredell County and is the sole responsibility of the affected parties.

Kathleen Saunders
Applicant

4-21-17
Date