IREDELL COUNTY HEALTH DEPARTMENT

STATESVILLE 704-878-5305 MOORESVILLE 704-664-5281

IMPROVEMENT PERMIT / AUTHORIZATION TO CONSTRUCT / OPERATION PERMIT / EXISTING SYSTEM INSPECTION

PERMIT # 158443 PIN # 4715-85-1704 DATE 12 October 09

OWNER or APPLICANT Phoenix Rising Dev. PHONE: Business (704) 202-1366 Home:

OWNER or APPLICANT ADDRESS 146 Staffordshire Drive Statesville, NC.

LOCATION / DIRECTIONS Hwy 90 TL Absher Farm Loop TL Staffordshire - Lot on Rt.

SUBDIVISION Castlegate BLOCK / SECTION LOT # 11 LOT AREA 1.46 ac. DESIGN FLOW 360 gpd. L.T.A.R. 0.3 g/ft²/d.

Septic Tank 1000 Gallons: STB 1012 Date 6-2-08
Pump Tank Gallons: P.T. Date
Pump Make Model Serial #
Nitrification Field No Fields 1 No Lines 4 Linear Feet 300
Trench Width 36" Max. Trench Bottom Depth 36" Gravel Depth NA

☐ New System ☐ Repair ☐ Expansion System Type I II (III) IV V VI
System Description: 25% Reduction System
Repair System Description: 50% Reduction System
Maintenance Agreement Required ☐ YES ☑ NO
☐ GRAVITY ☐ PRESSURE


☑ Residence No. Bedrooms 3
☐ Business No. Persons
☐ Other No. Employees
☐ Slab ☑ Crawl Space
☐ Basement w/plumbing ☐ Basement w/o plumbing

Water Supply: ☐ Private ☑ Public ☐ Community


Comments / Conditions * If plumbing stub-out does not allow for proper gravity distribution then pump system will be required.

Comments / Conditions
Red Top Tile

INITIAL SITE SKETCH

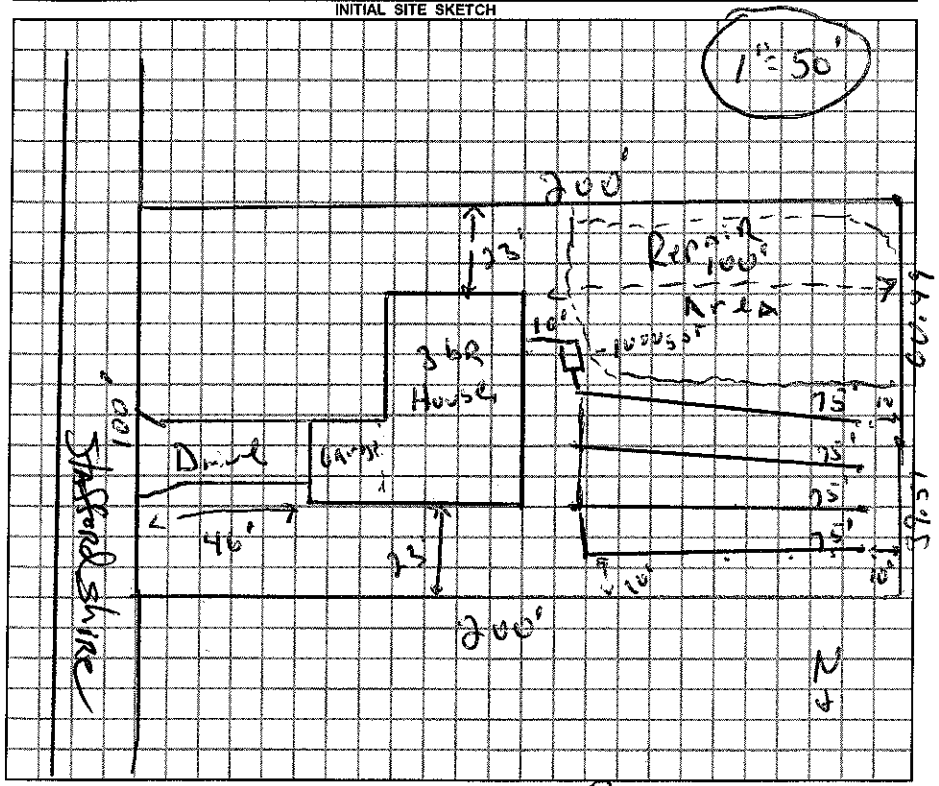

AS BUILT SKETCH

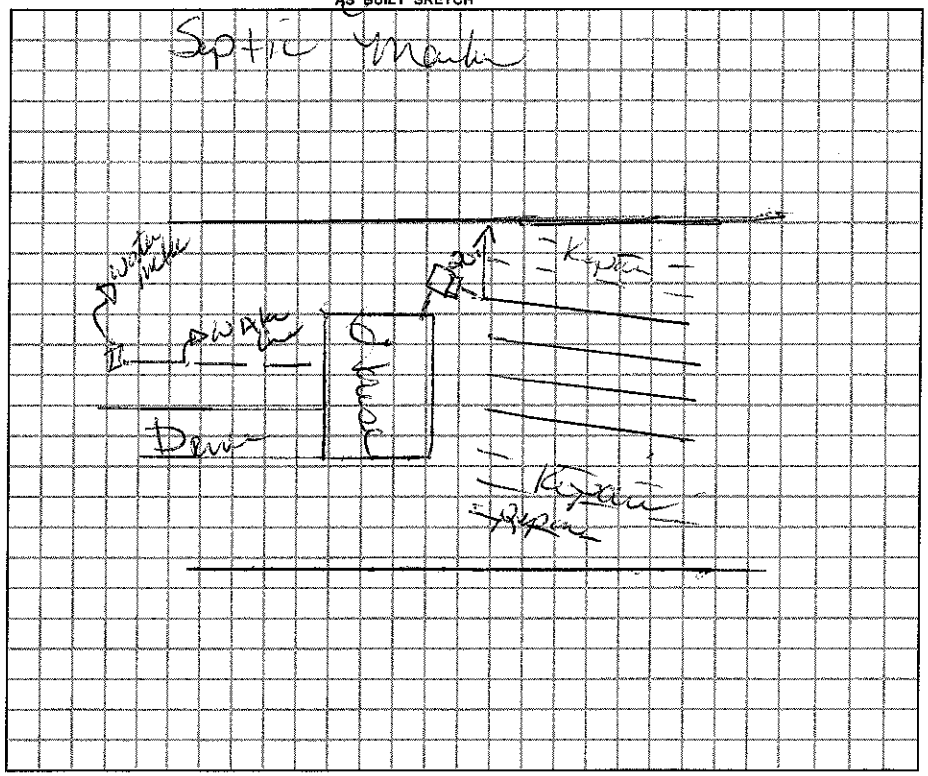

Permit can be suspended or revoked if any false information is supplied toward securing the permit / any unauthorized changes are made to the site / any unauthorized changes are made in the installation of the system.

☐ *IMPROVEMENT PERMIT w / plat valid without expiration.* ☐ *IMPROVEMENT PERMIT w / site plan valid for 60 mos.* ☑ *AUTHORIZATION TO CONSTRUCT valid for period equal to IMPROVEMENT PERMIT-not to exceed 60 mo.*

Owner / Applicant Signature: Date 10-12-09 Installed by: Gentry Grading

Improvement Permit by: R.S. Date 12 Oct. 09 Operation Permit by: Date: 12-29-09

Authorization to Construct by: R.S. Date 12 Oct. 09 Existing System Inspected by: Date:

YOU SHOULD CONTACT A LOCATOR SERVICE PRIOR TO ANY EXCAVATION.

WHITE COPY Environmental Health YELLOW COPY (Final) Owner / Applicant PINK COPY (Initial) Owner / Applicant