IREDELL COUNTY HEALTH DEPARTMENT

Statesville Office (704) 878-5305 Mooresville Office (704) 660-3625 PERMIT # 220560

RA

IMPROVEMENT PERMIT / AUTHORIZATION TO CONSTRUCT / OPERATION PERMIT / EXISTING SYSTEM

PIN # 4715853203

APPLICANT: Lake Luxury Homes APPLICANT ADDRESS: P.O. Box 3792 Mooresville, NC

SITE ADDRESS: 1107 Staffordshire Statesville, NC PHONE: ALT. PHONE: 704 576-2344

SITE DIRECTIONS: Hwy 90 W TL Absher Farm Rd TL Staffordshire on left

SUBDIVISION: Castlegate SECTION: 1 LOT # 122 LOT AREA: .540 Ac DESIGN FLOW: 360gpd L.T.A.R.: .3


Septic Tank	1000 (gal)	STB		Date		[X] New System	[ ] Repair	[ ] Expansion	System Type: I II (III) IV V VI	[X] Residence	No. Bedrooms 3
Pump Tank	(gal)	PT		Date		System Description: Gravity- 25% Reduction				[ ] Business	No. Persons 6
Pump Make		Model		Serial #		Repair System Description: 25% Reduction				[ ] Other	No. Employees
# Nitrification Fields	1	# Lines	4	Linear Ft:	300'	Maintenance Agreement Required:	[ ] YES	[X] NO		[ ] Slab	[X] Crawl Space
Trench Width	36"	Max. Trench Bottom Depth	29"	Gravel Depth	N/A		[X] GRAVITY	[ ] PRESSURE		[ ] Basement w/plumbing	[ ] Basement w/o plumbing

Water Supply: [ ] Private [X] Public [ ] Community

Comments / Conditions: *. Position ST high on lot to accommodate gravity repair area

INITIAL SITE SKETCH

Scale 1:50'

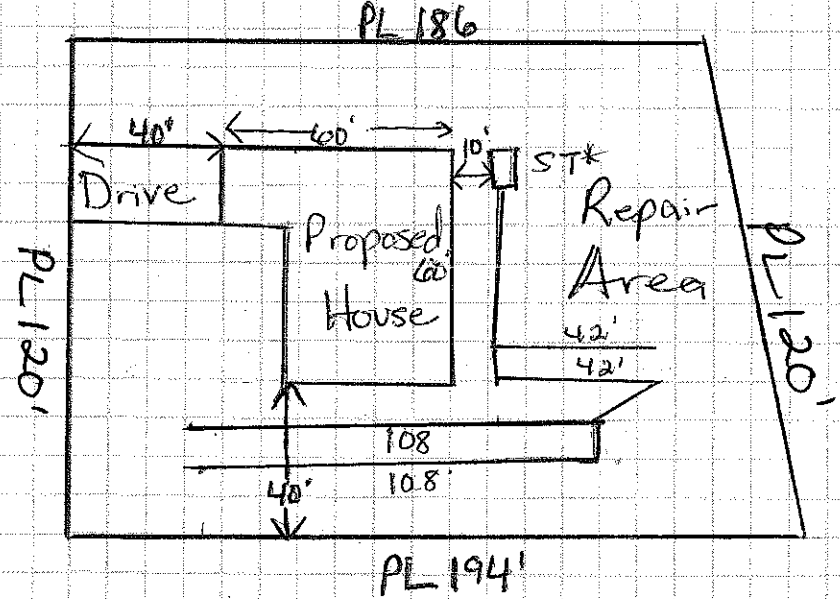

AS BUILT SKETCH

Permit can be suspended or revoked if any false information is supplied toward securing the permit / any unauthorized changes are made to the site / any unauthorized changes are made in the installation of the system. **CONTACT A LOCATOR SERVICE PRIOR TO ANY EXCAVATION**

[ ] **IMPROVEMENT PERMIT** *with plat valid without expiration.* [X] **IMPROVEMENT PERMIT** *with site plan valid for 60 mos.* [X] **AUTHORIZATION TO CONSTRUCT** *valid for period equal to IMPROVEMENT PERMIT--not to exceed 60 mo.*

Owner / Applicant Signature: Date: 10/25/16 Installed by: Rowan Septic

IMPROVEMENT PERMIT by: Maina Dotson RS Date: 10/21/16 OPERATION PERMIT by: RA Date: 3-17-17

AUTHORIZATION TO CONSTRUCT by: Maina Dotson RS Date: 10/21/16 Existing System Inspected by: Date:

Health Dept. Copy - WHITE Applicant (Final Approval) - YELLOW Applicant (Conditional Approval) - PINK