IREDELL COUNTY HEALTH DEPARTMENT

STATESVILLE 704-878-5305 (@) MOORESVILLE 704-664-5281

IMPROVEMENT PERMIT / AUTHORIZATION TO CONSTRUCT / OPERATION PERMIT / EXISTING SYSTEM INSPECTION

Planning Zoning

DHH

PERMIT # 160748 PIN # 4715-85-3319 DATE 13 May 10

OWNER or APPLICANT Danny Lippard Constr. PHONE: ~~Business~~ Cell (704) 902-4918 Home:

OWNER or APPLICANT ADDRESS PO Box 629 Statesville

LOCATION / DIRECTIONS Taylorsville Hwy TL Absher Farm Rd. TL into Castlegate - lot on left,

SUBDIVISION Castlegate BLOCK / SECTION LOT # 123 LOT AREA 0.3 ac DESIGN FLOW 360 gpd L.T.A.R. 0.3 g/Ft²/d

Septic Tank 1000 Gallons: STB 1012 Date 4-20-10

Pump Tank Gallons: P T Date

Pump Make Model Serial #

Nitrification Field No Fields 1 No Lines 5 Linear Feet 300

Trench Width 36" Max. Trench Bottom Depth 36" Gravel Depth NA

☑ New System ☐ Repair ☐ Expansion System Type I II (III) IV V VI

System Description: 25% Reduction

Repair System Description: 50% Reduction - LPP

Maintenance Agreement Required ☐ YES ☑ NO

☑ GRAVITY ☐ PRESSURE

☑ Residence No. Bedrooms 3

☐ Business No. Persons

☐ Other No. Employees

☐ Slab ☑ Crawl Space


☐ Basement w/plumbing ☐ Basement w/o plumbing

Water Supply: ☐ Private ☑ Public ☐ Community

Comments / Conditions: Follow Contour / Honor setbacks

Comments / Conditions

INITIAL SITE SKETCH

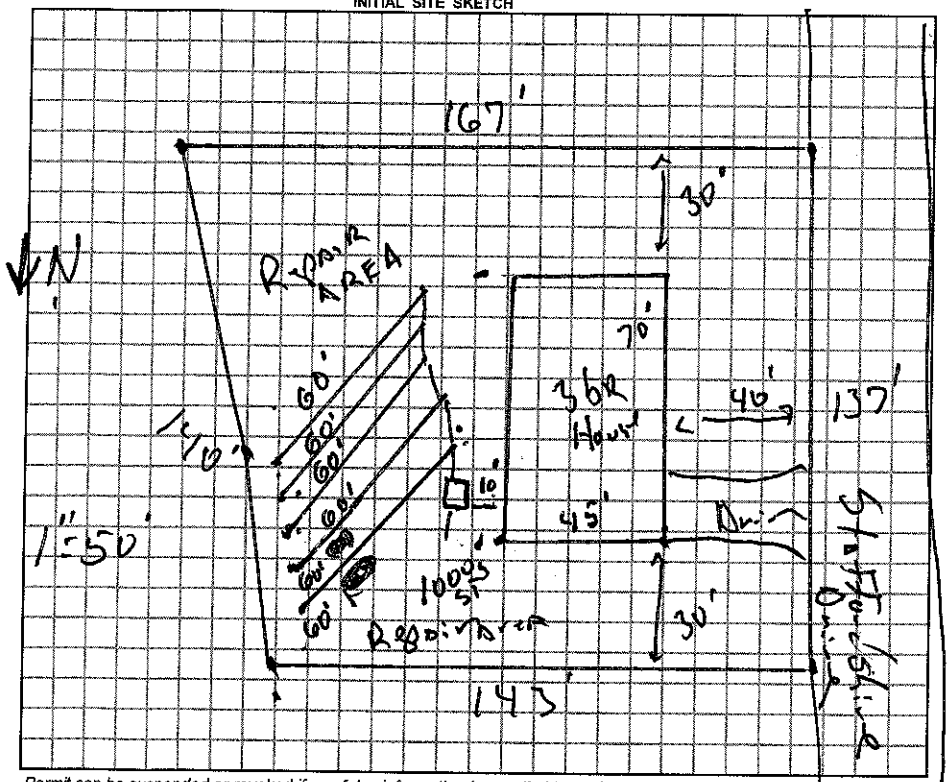

AS BUILT SKETCH

Permit can be suspended or revoked if any false information is supplied toward securing the permit / any unauthorized changes are made to the site / any unauthorized changes are made in the installation of the system.

☐ *IMPROVEMENT PERMIT w / plat valid without expiration.* ☑ *IMPROVEMENT PERMIT w / site plan valid for 60 mos.* ☑ *AUTHORIZATION TO CONSTRUCT valid for period equal to IMPROVEMENT PERMIT-not to exceed 60 mo.*

Owner / Applicant Signature: Danny Lippard Date 5-25-10

Improvement Permit by: Jim Hoggard R.S. Date 13 May 10

Authorzation to Construct by: Jim Hoggard R.S. Date 13 May 10

Installed by: Young Grading

Operation Permit by: Date: 10-21-10

Existing System Inspected by: Date:

YOU SHOULD CONTACT A LOCATOR SERVICE PRIOR TO ANY EXCAVATION.

WHITE COPY Environmental Health YELLOW COPY (Final) Owner / Applicant PINK COPY (Initial) Owner / Applicant