Owner: Phoenix Rising

IREDELL COUNTY HEALTH DEPARTMENT

STATESVILLE 704-878-5305 @ MOORESVILLE 704-664-5281

IMPROVEMENT PERMIT / AUTHORIZATION TO CONSTRUCT / OPERATION PERMIT / EXISTING SYSTEM INSPECTION

PERMIT # 160747 PIN # 4715-85-3675 DATE 12 May 10

OWNER or APPLICANT (Danny Lippard Constr.) PHONE: ~~Business~~ cell (704) 902-4918 Home:

OWNER or APPLICANT ADDRESS P.O. Box 629 Statesville

LOCATION / DIRECTIONS Taylorsville Hwy. TL Absher Farm Rd. TL into Castlegate - Corner of Staffordshire + Castle Pines.

SUBDIVISION Castlegate BLOCK / SECTION LOT # 100 LOT AREA 0.5 DESIGN FLOW 360 gpd L.T.A.R. 0-3/4"/20

Septic Tank 1000 Gallons: STB 1012 Date 11-10-09

Pump Tank Gallons: P T Date

Pump Make Model Serial #

Nitrification Field No Fields 1 No Lines 4 Linear Feet 300

Trench Width 36" Max. Trench Bottom Depth 36" Gravel Depth NA

☑ New System ☐ Repair ☐ Expansion System Type I II (III) IV V VI

System Description: 25% Reduction

Repair System Description: 25% Reduction

Maintenance Agreement Required ☐ YES ☒ NO

☑ GRAVITY ☐ PRESSURE

☑ Residence No. Bedrooms 3

☐ Business No. Persons

☐ Other No. Employees

☐ Slab ☑ Crawl Space


☐ Basement w/plumbing ☐ Basement w/o plumbing

Water Supply: ☐ Private ☑ Public ☐ Community

Comments / Conditions: Follow contour / Keep setbacks honored.

Comments / Conditions

INITIAL SITE SKETCH

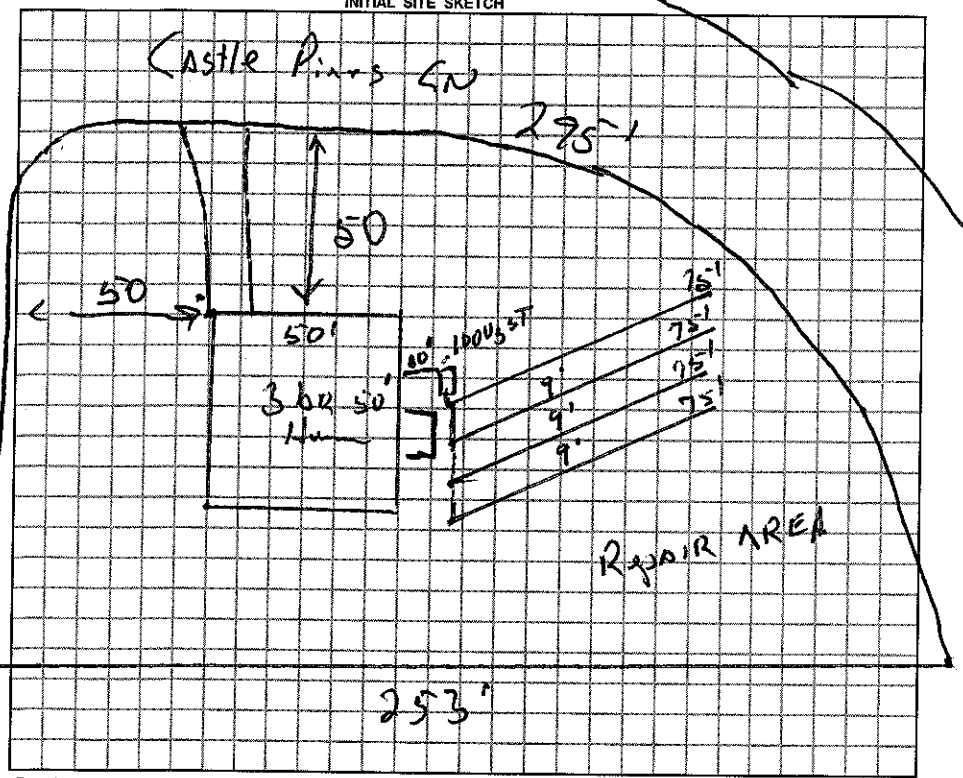

AS BUILT SKETCH

Staffordshire Dr.

156

Permit can be suspended or revoked if any false information is supplied toward securing the permit / any unauthorized changes are made to the site / any unauthorized changes are made in the installation of the system.

☐ *IMPROVEMENT PERMIT w / plat valid without expiration.* ☑ *IMPROVEMENT PERMIT w / site plan valid for 60 mos.* ☑ *AUTHORIZATION TO CONSTRUCT valid for period equal to IMPROVEMENT PERMIT-not to exceed 60 mo.*

Owner / Applicant Signature: Danny Lippard Date 5-25-10

Improvement Permit by: Dan Haggas, RS Date 13 May 10

Authorization to Construct by: Dan Haggas, R.S. Date 13 May 10

Installed by: Voorhees Brothers

Operation Permit by: Date: 8-23-10

Existing System Inspected by: Date:

YOU SHOULD CONTACT A LOCATOR SERVICE PRIOR TO ANY EXCAVATION.

WHITE COPY Environmental Health YELLOW COPY (Final) Owner / Applicant PINK COPY (Initial) Owner / Applicant