Phoenix Rising

IREDELL COUNTY HEALTH DEPARTMENT

STATESVILLE 704-878-5305 (a) MOORESVILLE 704-664-5281

IMPROVEMENT PERMIT / AUTHORIZATION TO CONSTRUCT / OPERATION PERMIT / EXISTING SYSTEM INSPECTION

PERMIT # 160746 PIN # 4715-85-7077 DATE 12 May 10

OWNER or APPLICANT Danny Lippard Const. PHONE: ~~Business~~ cell (704) 902-4918 Home:

OWNER or APPLICANT ADDRESS P.O. Box 629 Statesville

LOCATION / DIRECTIONS Taylorsville Hwy. TL Absher Farm Rd. TL into Castlegate - TL Castle Pines - Lot on left.

SUBDIVISION Castlegate BLOCK / SECTION LOT # 82 LOT AREA 0.5Ac. DESIGN FLOW 360g/d L.T.A.R. 0.3g/ft²/d

Septic Tank 1000 Gallons: STB 1042 Date 5-13-09

Pump Tank Gallons: P T Date

Pump Make Model Serial #

Nitrification Field No Fields 1 No Lines 4 Linear Feet 300

Trench Width 36" Max. Trench Bottom Depth 36" Gravel Depth NA

☑ New System ☐ Repair ☐ Expansion System Type I II (III) IV V VI

System Description: 25% Reduction system.

Repair System Description: 25% Reduction System

Maintenance Agreement Required ☐ YES ☑ NO

☑ GRAVITY ☐ PRESSURE

☑ Residence No. Bedrooms 3

☐ Business No. Persons

☐ Other No. Employees

☐ Slab ☑ Crawl Space


☐ Basement w/plumbing ☐ Basement w/o plumbing

Water Supply: ☐ Private ☑ Public ☐ Community


Comments / Conditions: Follow contour / Honor setback requirements.

Comments / Conditions: Polylock Fittings.

INITIAL SITE SKETCH

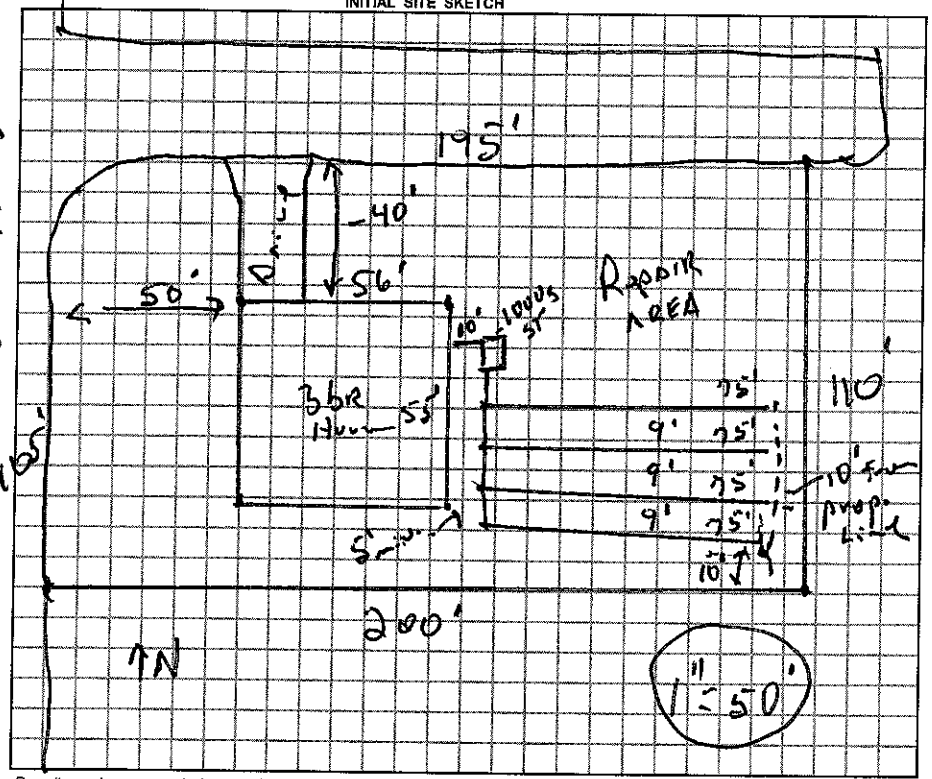

AS BUILT SKETCH

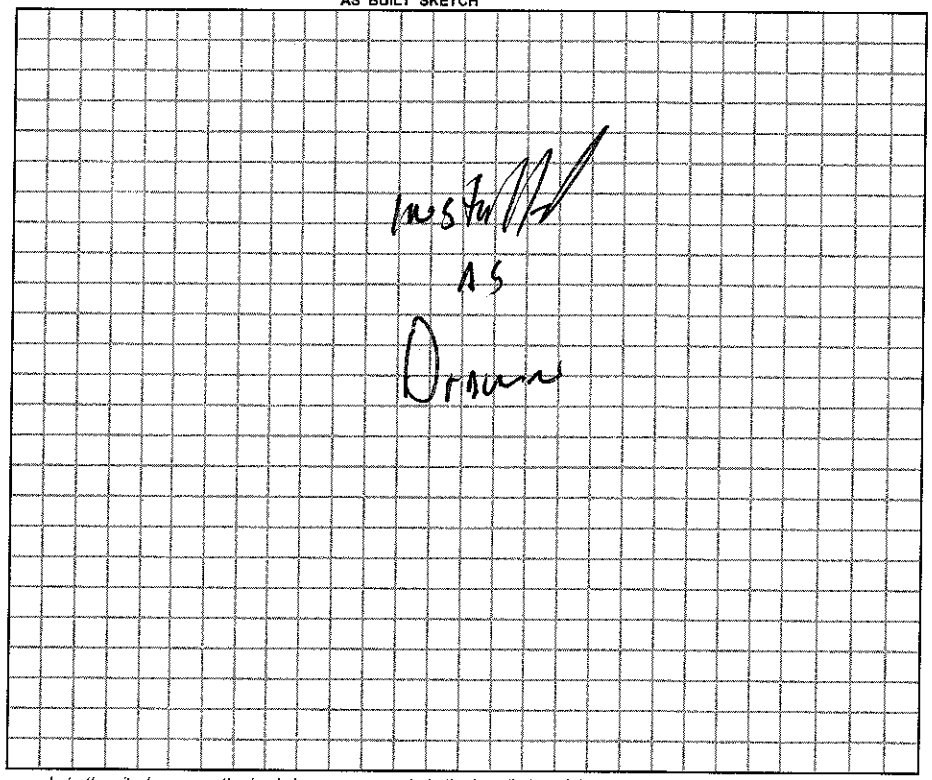

Permit can be suspended or revoked if any false information is supplied toward securing the permit / any unauthorized changes are made to the site / any unauthorized changes are made in the installation of the system.

☐ *IMPROVEMENT PERMIT w / plat valid without expiration.* ☑ *IMPROVEMENT PERMIT w / site plan valid for 60 mos.* ☑ *AUTHORIZATION TO CONSTRUCT valid for period equal to IMPROVEMENT PERMIT-not to exceed 60 mo.*

Owner / Applicant Signature: Danny Lippard Date 5-25-10

Improvement Permit by: Date 13 May 10

Authorization to Construct by: Date 13 May 10

Installed by: David Woontz

Operation Permit by: , R.S. Date: 26 Aug. 10

Existing System Inspected by: Date:

YOU SHOULD CONTACT A LOCATOR SERVICE PRIOR TO ANY EXCAVATION.

WHITE COPY Environmental Health YELLOW COPY (Final) Owner / Applicant PINK COPY (Initial) Owner / Applicant