IREDELL COUNTY HEALTH DEPARTMENT - *ENVIRONMENTAL HEALTH* ☐ STATESVILLE OFFICE 704-878-5305 ☐ MOORESVILLE OFFICE 704-664-5281

IMPROVEMENT PERMIT (1) / AUTHORIZATION TO CONSTRUCT (2) / OPERATION PERMIT (3) / EXISTING SYSTEM INSPECTION

PERMIT # 168574 PIN # 4715-85-7848 DATE 3 October 2011

OWNER Castlegate LLC APPLICANT: America's Home Place PHONE: Home/Cell # (704)872-4383 Business #

SITE ADDRESS 116 Hanbury Ln. Statesville OWNER / APPLICANT ADDRESS

SITE DIRECTIONS Nw/ 90 Turn Absher Farm Lp. Turn ~~Rt~~ Straffordshire TL Hanbury Ln. on Rt.

SUBDIVISION Castle Gate BLOCK / SECTION LOT # 94 LOT AREA 0.59AC. DESIGN FLOW 360 gpd L.T.A.R. 0.3 gpd/ft²

Septic Tank 1000 Gallons: STB 1012 Date 7-11-11
Pump Tank Gallons: P T Date
Pump Make Model Serial #
No. Nitrification Fields: 1 No. Lines 5 Linear Feet 300
Trench Width 36" Max. Trench Bottom Depth 36" Gravel Depth NA

☑ New System ☐ Repair ☐ Expansion System Type I II (III) IV V VI
System Description: 25% Reduction System
Repair System Description: 25% Reduction System
Maintenance Agreement Required ☐ YES ☑ NO
☑ GRAVITY ☐ PRESSURE


☑ Residence No. Bedrooms 3
☐ Business No. Persons
☐ Other No. Employees
☐ Slab ☑ Crawl Space
☐ Basement w/plumbing ☐ Basement w/o plumbing

Water Supply: ☐ Private ☑ Public ☐ Community

Comments / Conditions
Follow contours

ST NAS MARKER
polyfloic filter

INITIAL SITE SKETCH

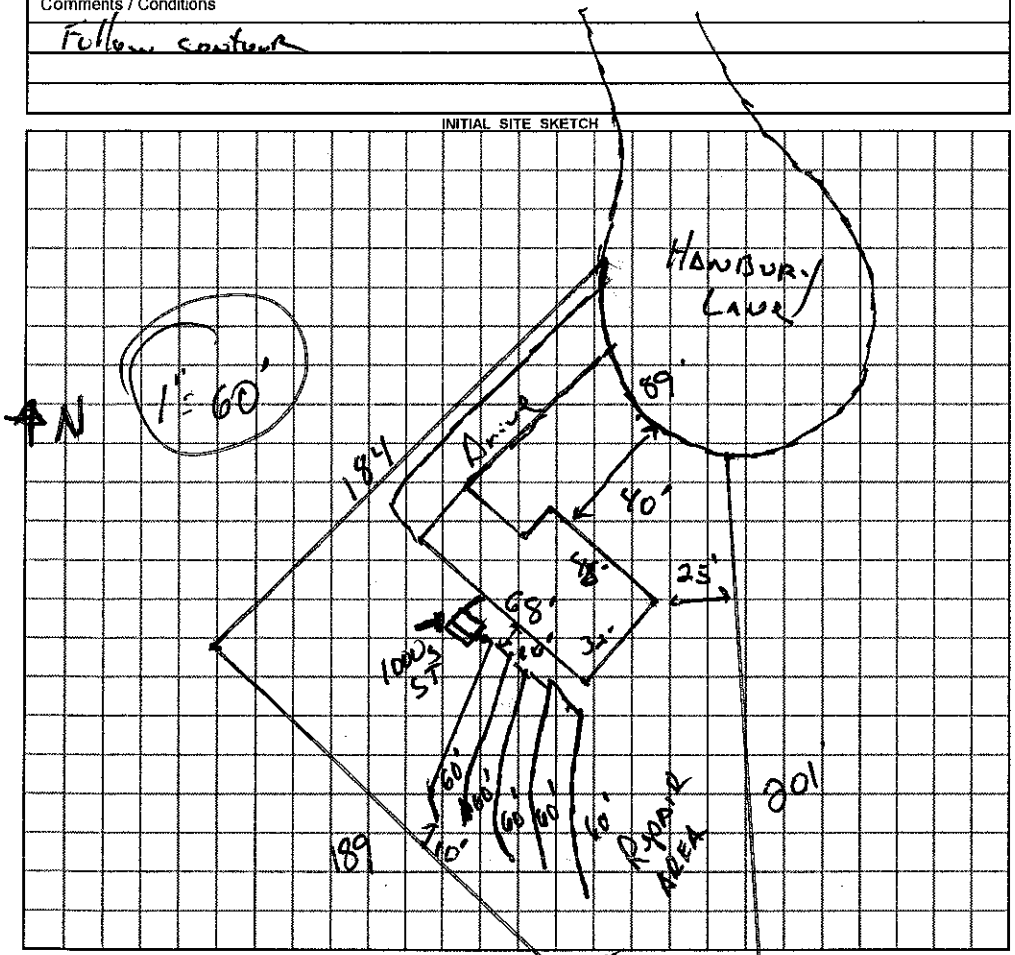

AS BUILT SKETCH

Installed as Drawn

Permit can be suspended or revoked if any false information is supplied toward securing the permit / any unauthorized changes are made to the site / any unauthorized changes are made in the installation of the system.

☐ *IMPROVEMENT PERMIT* with plat valid without expiration. ☑ *IMPROVEMENT PERMIT* with ~~plat valid without expiration~~ site plan valid 60 mo. ☑ *AUTHORIZATION TO CONSTRUCT* valid for period equal to IMPROVEMENT PERMIT--not to exceed 60 mo.

Owner / Applicant Signature: Amy LEONARD Date Oct. 26, 11 Installed by: Ground Breakers

IMPROVEMENT PERMIT by: REHS Date 30 Oct. 11 OPERATION PERMIT by: REHS Date 3 Feb. 2012

AUTHORIZATION TO CONSTRUCT by: REHS Date 10-27-11 Existing System Inspected by: REHS Date

YOU SHOULD CONTACT A LOCATOR SERVICE PRIOR TO ANY EXCAVATION

White Copy – Environmental Health YELLOW COPY (Final) Owner / Applicant PINK COPY (Initial) Owner / Applicant