IREDELL COUNTY HEALTH DEPARTMENT

STATESVILLE 704-878-5305 MOORESVILLE 704-664-5281

IMPROVEMENT PERMIT / AUTHORIZATION TO CONSTRUCT / OPERATION PERMIT / EXISTING SYSTEM INSPECTION

PERMIT # Repair PIN # 4715962523 DATE 8-24-09

OWNER or APPLICANT HELEN DEAL PHONE: Business Home: 704-873-7577

OWNER or APPLICANT ADDRESS 3699 TAYLORSVILLE Hwy Statesville NC 28677

LOCATION / DIRECTIONS 40 WEST (R) Hwy 90 (L) AT BOX # 3699 Across from B's WATER TOWER

SUBDIVISION BLOCK / SECTION LOT # LOT AREA 1.74 DESIGN FLOW 480 L.T.A.R. .3

Septic Tank 1000 Gallons: STB 1017 Date 7-2108
Pump Tank Gallons: P T Date
Pump Make Model Serial #
Nitrification Field No Fields 1 No Lines 4 Linear Feet 400'
Trench Width 36" Max. Trench Bottom Depth 36" Gravel Depth N/A

☐ New System ☒ Repair ☐ Expansion System Type I II (III) IV V VI
System Description:
Repair System Description: 600 BTU 25% REDUCTION
Maintenance Agreement Required ☐ YES ☒ NO
☒ GRAVITY ☐ PRESSURE


☒ Residence No. Bedrooms 4
☐ Business No. Persons 6
☐ Other No. Employees
☐ Slab ☐ Crawl Space
☐ Basement w/plumbing ☒ Basement w/o plumbing

Water Supply: ☐ Private ☐ Public ☐ Community


Comments / Conditions (1) WELL MUST BE ABANDONED B4 AC IS SIGNED. (2) Keep TANK & System 15' from BASEMENT & 10' from P/L. (3) Keep supply line 5' from p/L & 10' from BASEMENT (4) PUMP crush & fill old tank (5) Installer needs to mark LOCATORS

Comments / Conditions to review system and plumbers new stubout position. When plumber says stubout will be it will have 12" FALL in 60' to drainfield. (6) TANK WILL BE OUT OF GROUND AND BACKFILL WILL BE ADDED & WINDOWS FOR BASEMENT COVERS WILL

INITIAL SITE SKETCH

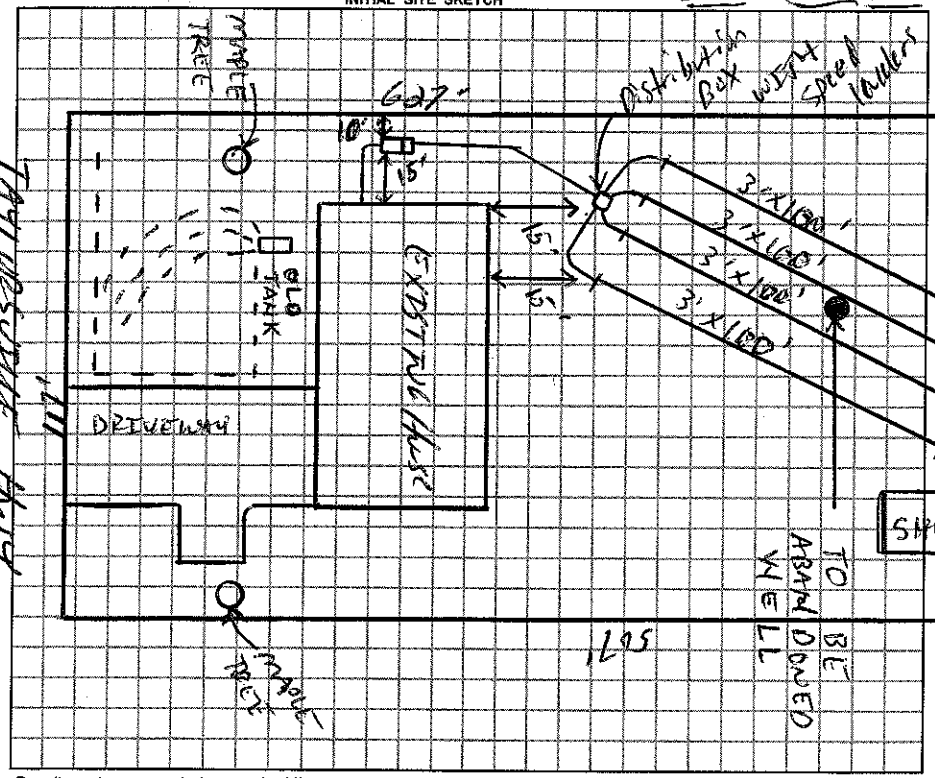

AS BUILT SKETCH

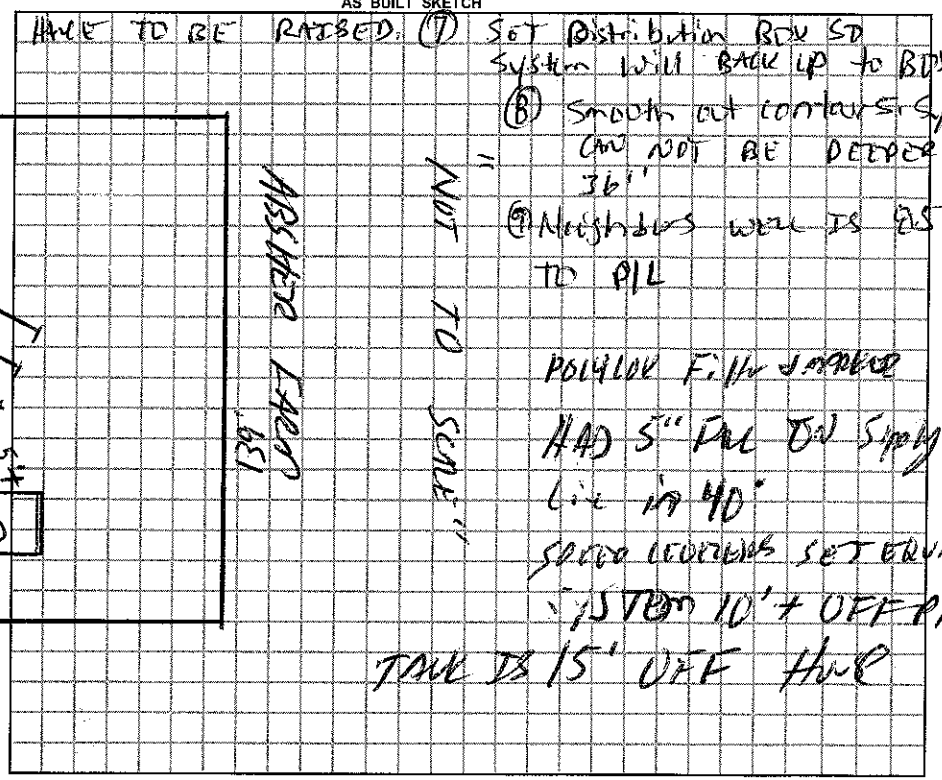

Permit can be suspended or revoked if any false information is supplied toward securing the permit / any unauthorized changes are made to the site / any unauthorized changes are made in the installation of the system.

☐ *IMPROVEMENT PERMIT w / plat valid without expiration.* ☒ *IMPROVEMENT PERMIT w / site plan valid for 60 mos.* ☐ *AUTHORIZATION TO CONSTRUCT valid for period equal to IMPROVEMENT PERMIT-not to exceed 60 mo.*

Owner / Applicant Signature: Helen C Deal Date 8-25-09 Installed by: Steve Jones Piedmont Backhoe

Improvement Permit by: Date 8-24-09

Authorzation to Construct by: Date 9-17-09

Operation Permit by: Date: 9-17-09

Existing System Inspected by: Date:

YOU SHOULD CONTACT A LOCATOR SERVICE PRIOR TO ANY EXCAVATION.

WHITE COPY Environmental Health YELLOW COPY (Final) Owner / Applicant PINK COPY (Initial) Owner / Applicant