IREDELL COUNTY HEALTH DEPARTMENT

Statesville Phone TR 3-7271 Mooresville Phone NO 3-1271

PERMIT TO INSTALL SEPTIC TANK

Permit NO. _____ Permit Date 4-1-60 1960

Owner Wright Hoover Address Taylorsville R.F.

Installed By C Hoke Address R7.


Location of Property Across from Iron gas Plant on 90 W. at site of old stave Plant.

Tank		Capacity		Length of Lines		Fixtures	
Block	( )	800	( )	150'	( )	No. of Baths	(1½)
Precast	(✓)	900	( )	175'	( )	Dishwasher	( )
		1000	( )	200'	( )	Garbage Grdr.	( )
		1100	( )	225'	( )	Auto-Washer	(—)
		1200	( )	250'	(✓)	Other	
		Other 125		Other			

NOTIFY HEALTH DEPARTMENT AT LEAST EIGHT HOURS BEFORE TANK IS TO BE INSPECTED.

Final Inspection 4-1- 1960 Approved ( ) Disapproved ( )

Remarks Selfaze - well 100'

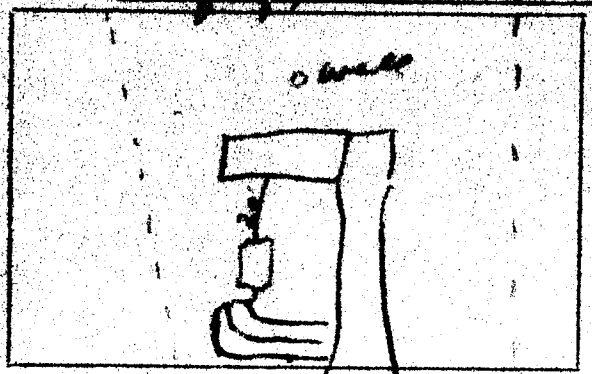

Sketch of Installation

R. G. L.

Sanitarian