IREDELL COUNTY HEALTH DEPARTMENT

THIS PERMIT VOIDS PREVIOUS ISSUED 6-29-05 (C1)

STATESVILLE 704-878-5305 MOORESVILLE 704-664-5281

IMPROVEMENT PERMIT / AUTHORIZATION TO CONSTRUCT / OPERATION PERMIT / EXISTING SYSTEM INSPECTION

PERMIT# 128266 PIN# 4716-03-5864 DATE 8-4-05

OWNER OR CONTRACTOR KENNETH A. WATT PHONE: Business 704-902-4495 Home

ADDRESS 129 BECKHAM RD STATESVILLE, NC 28625

LOCATION NC 115 N TL SCOTTS CREEK RD TL ROBERT DR AT END ON LEFT

SUBDIVISION LARKIN SLOAN BLOCK / SECTION LOT 40 LOT AREA 2.071 Ac+ SITE CLASS. 05 DESIGN FLOW 360 L.T.A.R. 0.30 GPD/SQ FT

Septic Tank: 1000 Gallons; STB 1012 Date 4-24-05

Pump Tank: Gallons; PT Date

Pump Make: Model Serial No. 300

Nitrification Field: No Fields 1 Square Feet 1200 Linear Feet 400

No Lines FOUR 3 Trench Width 36" Max Trench Bottom Depth 36" Gravel Depth 12"

☑ New System ☐ Repair System Type: I, II, III, IV, V, VI

System Description: ACCEPTED, CONVENTIONAL, GRAVITY

Repair System Description: CONVENTIONAL, GRAVITY

Maintenance Agreement Required: ☐ Yes ☑ No

☑ House/Mod. Home No. Bedrooms 3

☐ Mobile Home No. Bathrooms

☐ Business No. Employees

☐ Other


☐ Slab ☑ Crawl Space ☐ Basement w/plumbing ☐ Basement wo/plumbing

Water Supply: ☐ Individual ☑ Public ☐ Community

Comments:/Conditions: AN ACCEPTED SYSTEM MAY ALSO BE USED

Comments:/Conditions: SEPTIC TANK WITH MARKER INSTALLED USING "TUFTAPE" FILTER

INITIAL SITE SKETCH

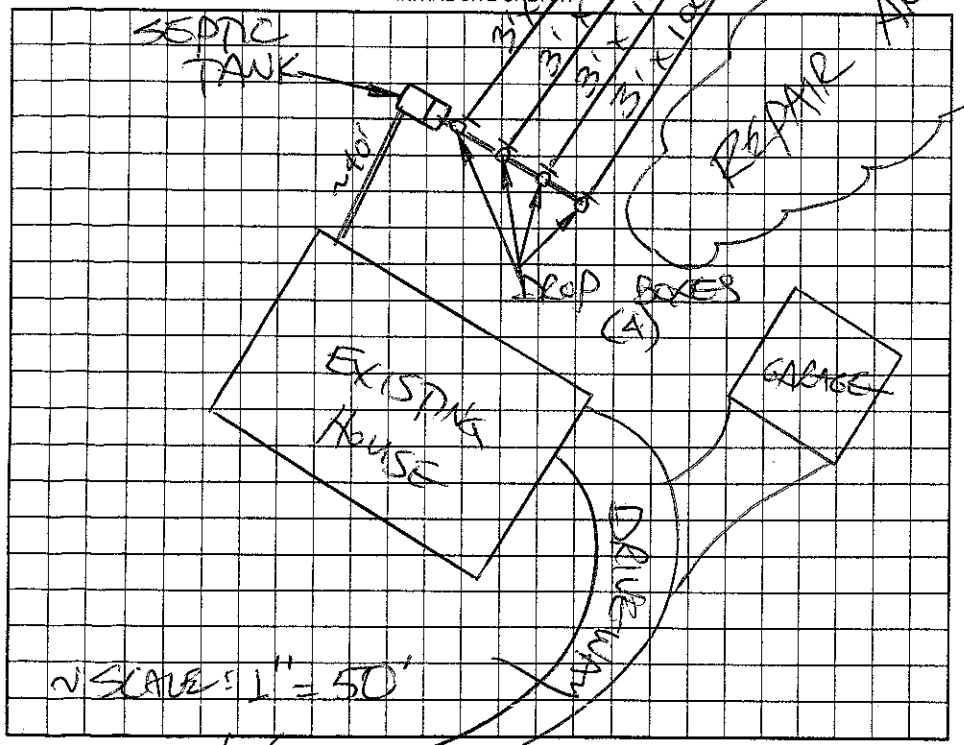

AS BUILT SKETCH

AN "ACCEPTED" SYSTEM WAS INSTALLED USING 75 "QUICK 4" INFILTRATOR CHAMBERS IN THREE LINES (100' EACH)

Permit can be suspended or revoked if any false information is supplied toward securing the permit/any unauthorized changes are made to the site/any unauthorized changes are made in the installation of the system. Improvement Permit with plat valid without expiration. Improvement Permit with site plan valid for sixty months. Authorization to Construct is valid for a period equal to that of Improvement Permit – not to exceed sixty months.

Signed: Kenneth A Watt 8-4-05 Installed by: DAVID YOUNTZ

Improvement Permit by: STEVE HEDRICK date 8-4-05 Operation Permit by: STEVE HEDRICK date 11-7-05

Authorization to Construct by: STEVE HEDRICK date 8-4-05 Existing System Inspection by: date

HEALTH DEPT. COPY: WHITE OWNER COPY (FINAL): YELLOW OWNER COPY (INITIAL): PINK