IREDELL COUNTY HEALTH DEPARTMENT

STATESVILLE 704-878-5305 MOORESVILLE 704-664-5281

IMPROVEMENT PERMIT / CERTIFICATE OF COMPLETION / OPERATION PERMIT / EXISTING SYSTEM INSPECTION

~~REF~~ F 9F-A-12 50630

PROPERTY DESCRIPTION NO. 18040 DATE 3/16/94 TAX MAP NO. 9F-A-12 (29) Watershed: ☐ Yes ☒ No

~~OWNER~~ OR CONTRACTOR HOPE BROTHERS PHONE: Business 872 4111 Home

ADDRESS 1120 BARKLEY ROAD STVL, NC 28677

LOCATION NC 90 W TR SCOTTS CREEK RD, TR ROBERT DRIVE, 3RD LOT ON (R)

SUBDIVISION LARKIN SLOAN BLOCK / SECTION LOT 29 LOT AREA 1.1 AC SITE CLASS. RS DESIGN FLOW 360 L.T.A.R. 0.35 GPD/FT²

Septic Tank: 1000 Gallons; STB 1012 Date 3/11/94

Pump Tank Gallons; PT Date

Pump Make: Model Serial No.

Nitrification Field: No Fields 1 Square Feet 1035 Linear Feet 345

No Lines 3 Trench Width 36" Max Trench Bottom Depth 18-36 Gravel Depth 12-

☒ New System ☐ Repair System Type: I, II, III, IV, V, VI

System Description: CONV. GRAVITY

Repair System Description: CONV. GRAVITY

Maintenance Agreement Required: ☐ Yes ☒ No

☒ House/Mod. Home No. Bedrooms 3

☐ Mobile Home No. Bathrooms 2

☐ Business No. Employees

☐ Other


☐ Slab ☒ Crawl Space ☐ Basement w/plumbing ☐ Basement wo/plumbing

Water Supply: ☐ Individual ☐ Community ☒ Public

Comments: ① KEEP SYSTEM MINIMUM 5' FROM HOUSE 10' FROM PROPERTY LINE, 10' FROM WATER LINE, ② INSTALL LINES ON CONTOUR, NO DEEPER THAN 36", 9' APART ON CENTER

Comments:

INITIAL SITE SKETCH

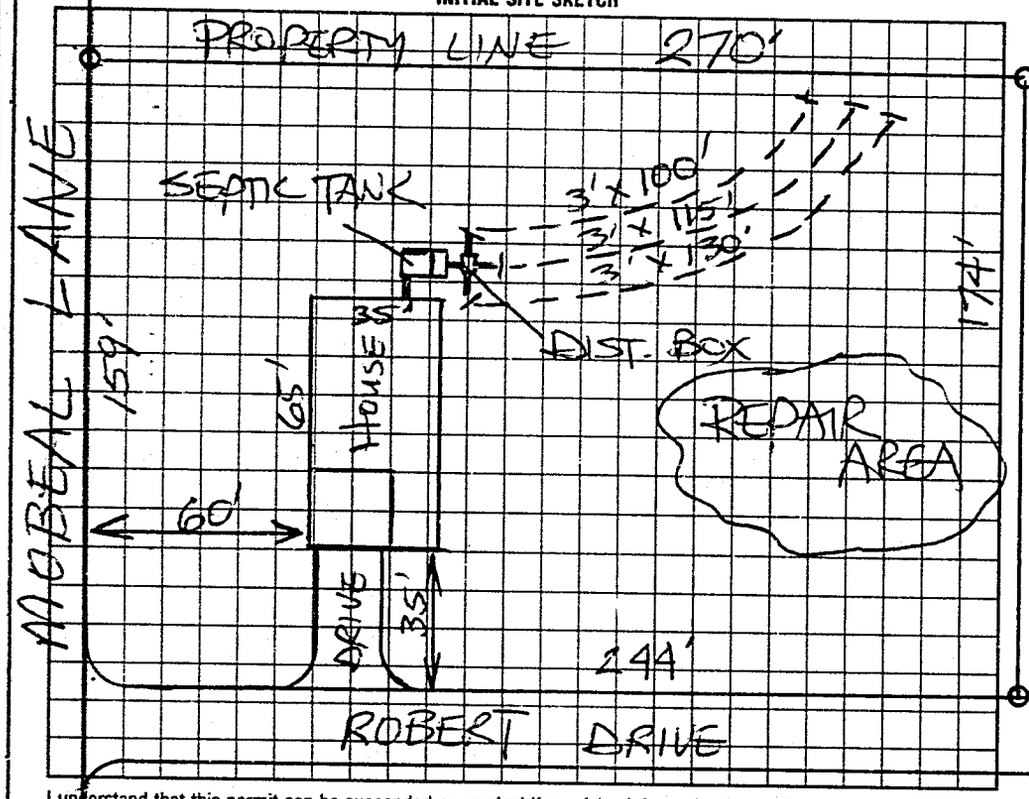

AS BUILT SKETCH

SYSTEM INSTALLED ACCORDING TO INITIAL SITE SKETCH

I understand that this permit can be suspended or revoked if any false information is supplied toward securing the permit/any unauthorized changes are made to the site/any unauthorized changes are made in the installation of the system. Improvement Permit is valid for 60 months from date of issuance.

Signed: X Steve Hedrick

Improvement Permit by: STEVE HEDRICK date 3/16/94

Existing System Inspection by: date

Installed by: ARNIE DUNCAN

Certificate of Completion by: STEVE HEDRICK date 5/20/94

Operation Permit by: date

HEALTH DEPT. COPY: WHITE INSPECTION COPY (FINAL): GREEN OWNER COPY (FINAL): YELLOW INSPECTION COPY (INITIAL): PINK OWNER COPY (INITIAL): GOLD