R-pair

IREDELL COUNTY HEALTH DEPARTMENT

STATESVILLE 704-878-5305 MOORESVILLE 704-664-5281

IMPROVEMENT PERMIT / AUTHORIZATION TO CONSTRUCT / OPERATION PERMIT / EXISTING SYSTEM INSPECTION

PERMIT # R-pair PIN # 4716-05-3717 DATE 17 Aug. 10

OWNER or APPLICANT Barbara Franklin PHONE: Business Home: (704) 873-5488

OWNER or APPLICANT ADDRESS 1316 Scotts Creek Rd. Statesville

LOCATION / DIRECTIONS Scotts Creek Rd. From 115 / ON Rt. before Emma Ln.

SUBDIVISION BLOCK / SECTION LOT # LOT AREA 1.8/ac DESIGN FLOW 360gpd L.T.A.R. 0.3/FAD

Septic Tank Exist. Gallons: STB Date

Pump Tank Gallons: P T Date

Pump Make Model Serial #

Nitrification Field No Fields 1 No Lines 3 Linear Feet 300

Trench Width 36" Max. Trench Bottom Depth 36" Gravel Depth NA

☐ New System ☑ Repair ☐ Expansion System Type I II III IV V VI

System Description:

Repair System Description: 25% Reduction

Maintenance Agreement Required ☐ YES ☑ NO

☑ GRAVITY ☐ PRESSURE

☑ Residence No. Bedrooms 3

☐ Business No. Persons

☐ Other No. Employees

☐ Slab ☐ Crawl Space


☑ Basement w/plumbing ☐ Basement w/o plumbing

Water Supply: ☐ Private ☑ Public ☐ Community


Comments / Conditions: Replace tee in tank /

Comments / Conditions

INITIAL SITE SKETCH

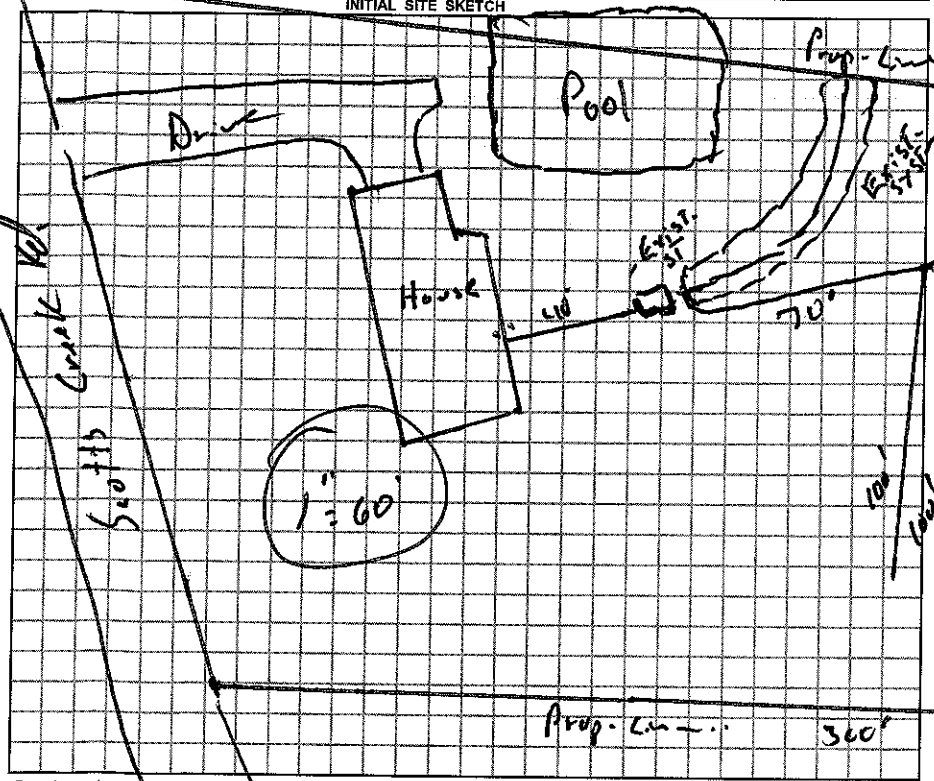

AS BUILT SKETCH

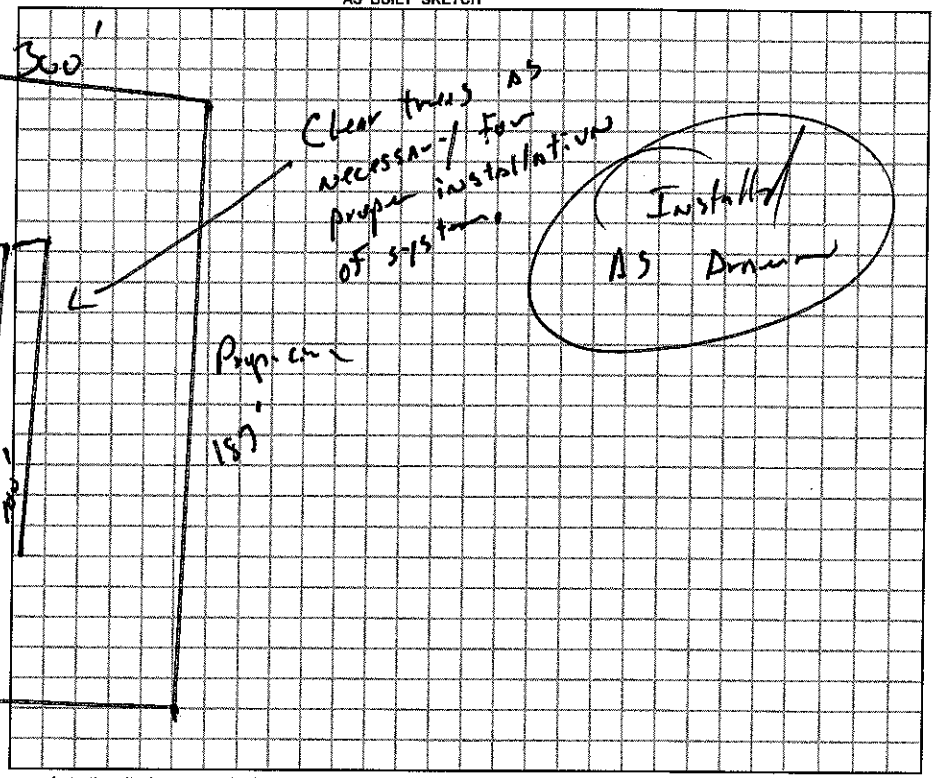

Permit can be suspended or revoked if any false information is supplied toward securing the permit / any unauthorized changes are made to the site / any unauthorized changes are made in the installation of the system.

☐ *IMPROVEMENT PERMIT w / plat valid without expiration.* ☑ *IMPROVEMENT PERMIT w / site plan valid for 60 mos.* ☑ *AUTHORIZATION TO CONSTRUCT valid for period equal to IMPROVEMENT PERMIT-not to exceed 60 mo.*

Owner / Applicant Signature: Dennis W Phan Date 8-18-2010

Improvement Permit by: R.S. Date 17 Aug.10

Authorization to Construct by: R.S. Date 17 Aug.10

YOU SHOULD CONTACT A LOCATOR SERVICE PRIOR TO ANY EXCAVATION.

Installed by: James Huddleston

Operation Permit by: R.S. Date: 6 Oct.10

Existing System Inspected by: Date:

WHITE COPY Environmental Health YELLOW COPY (Final) Owner / Applicant PINK COPY (Initial) Owner / Applicant