See attached permit #159114 for attached garage.

IREDELL COUNTY HEALTH DEPARTMENT

STATESVILLE 704-878-5305 (a) (a) MOORESVILLE 704-664-5281

IMPROVEMENT PERMIT / AUTHORIZATION TO CONSTRUCT / OPERATION PERMIT / EXISTING SYSTEM INSPECTION

PERMIT # 158117 PIN # 4716083775 DATE 9-15-09

OWNER or APPLICANT Jason Kelly Howard PHONE: Business Home: 704-892-4000

OWNER or APPLICANT ADDRESS 18220 Hawbin Light Drive Cowelus

LOCATION / DIRECTIONS 115 N (L) Scotts Creek (R) Emma At end Drive on right of Cul-de-sac

SUBDIVISION BLOCK / SECTION LOT # LOT AREA 151.4 AC DESIGN FLOW 600 L.T.A.R. .3

Septic Tank ~~1000~~ 1500 Gallons: STB 964 Date 2-1-10

Pump Tank Gallons: PT Date

Pump Make Model Serial #

Nitrification Field No Fields No Lines 5 Linear Feet 500

Trench Width 36" Max. Trench Bottom Depth 36" Gravel Depth 11"

☑ New System ☐ Repair ☐ Expansion System Type I II III IV V VI

System Description: 25% Braun

Repair System Description: 25% Braun

Maintenance Agreement Required ☐ YES ☐ NO

☑ GRAVITY ☐ PRESSURE

☑ Residence No. Bedrooms 5

☐ Business No. Persons

☐ Other No. Employees

☐ Slab ☐ Crawl Space

☐ Basement w/plumbing ☐ Basement w/o plumbing

Water Supply: ☐ Private ☑ Public ☐ Community

Comments / Conditions


Elevated on Carton
Maintain all setbacks

Comments / Conditions


5 @ 100' each
5 drop boxes

INITIAL SITE SKETCH

Not to scale

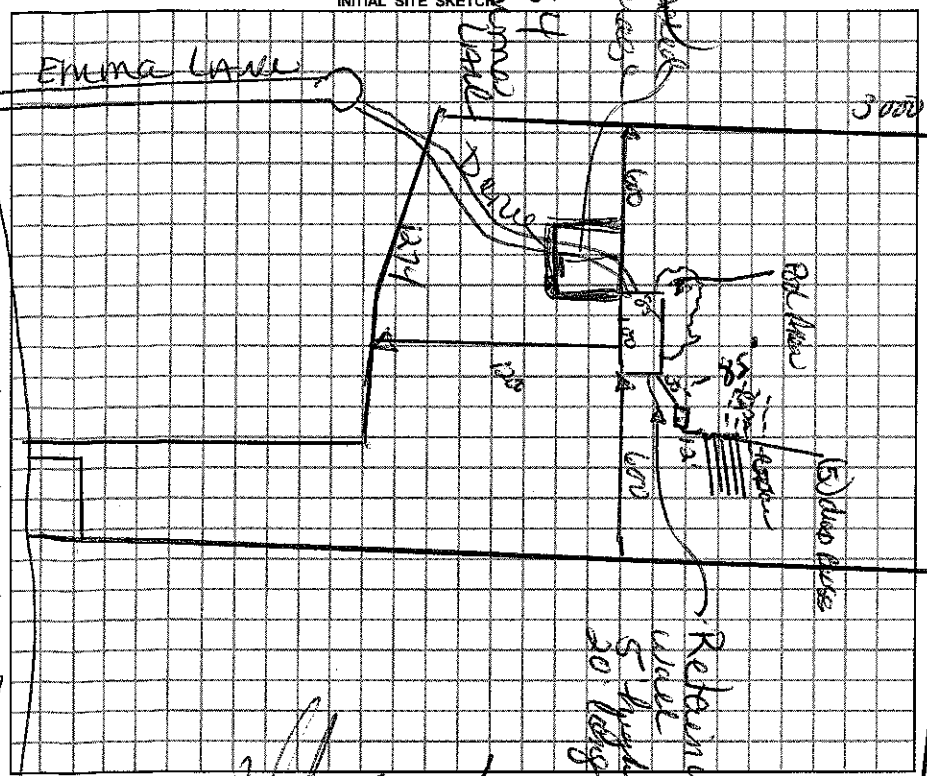

AS BUILT SKETCH

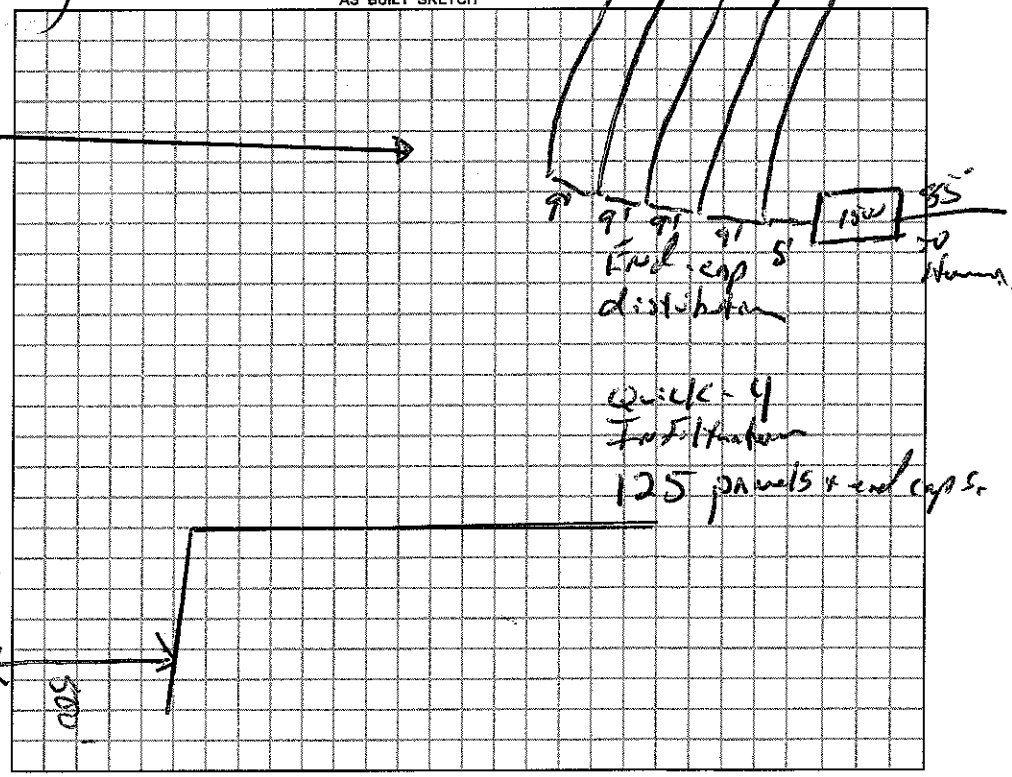

Permit can be suspended or revoked if any false information is supplied toward securing the permit / any unauthorized changes are made to the site / any unauthorized changes are made in the installation of the system.

☐ IMPROVEMENT PERMIT w / plan valid with no expiration ☐ IMPROVEMENT PERMIT w / site plan valid for 60 mos. ☑ AUTHORIZATION TO CONSTRUCT valid for period equal to IMPROVEMENT PERMIT-not to exceed 60 mo.

Owner / Applicant Signature: Date 11-2-09

Improvement Permit by: Date 9-15-09

Authorization to Construct by: Date 9-15-09

YOU SHOULD CONTACT A LOCATOR SERVICE PRIOR TO ANY EXCAVATION.

Installed by: A-1 Backhoe

Operation Permit by: R.S. Date: 9 March 10

Existing System Inspected by: Date:

WHITE COPY Environmental Health YELLOW COPY (Final) Owner / Applicant PINK COPY (Initial) Owner / Applicant