See attached permit #15914 for additional garage/pools — 206667

IREDELL COUNTY HEALTH DEPARTMENT

STATESVILLE 704-878-5305 — MOORESVILLE 704-664-5281

IMPROVEMENT PERMIT / AUTHORIZATION TO CONSTRUCT / OPERATION PERMIT / EXISTING SYSTEM INSPECTION

PERMIT # 158117 — PIN # 4716083775 — DATE 9-15-09

OWNER or APPLICANT: Jason Kelly Hayward — PHONE: Business — Home: 704-892-9000

OWNER or APPLICANT ADDRESS: 18220 Harbor Light Drive Cornelius

LOCATION / DIRECTIONS: 115 N (L) Scotts Creek (R) Emma. At end Drive on right of Cul-de-sac

SUBDIVISION — BLOCK / SECTION — LOT # — LOT AREA 151.4 AC — DESIGN FLOW 600 — L.T.A.R. .3

Septic Tank ~~1000~~ 1500 Gallons: STB 964 — Date 2-1-10
Pump Tank — Gallons: PT — Date
Pump Make — Model — Serial #
Nitrification Field No Fields — No Lines 5 — Linear Feet 500
Trench Width 36" — Max. Trench Bottom Depth 36" — Gravel Depth NA

☒ New System ☐ Repair ☐ Expansion System — Type I II (III) IV V VI
System Description: 25% Gravel
Repair System Description: 25% Gravel
Maintenance Agreement Required ☐ YES ☐ NO
☒ GRAVITY ☐ PRESSURE


☒ Residence — No. Bedrooms 5
☐ Business — No. Persons
☐ Other — No. Employees
☐ Slab ☐ Crawl Space
☐ Basement w/plumbing ☐ Basement w/o plumbing

Water Supply: ☐ Private ☒ Public ☐ Community


Comments / Conditions: Install on contour. Maintain all setbacks. (Not to scale)

Comments / Conditions: 5 @ 100' each — 5 drop boxes — (Polylok Filter)

INITIAL SITE SKETCH

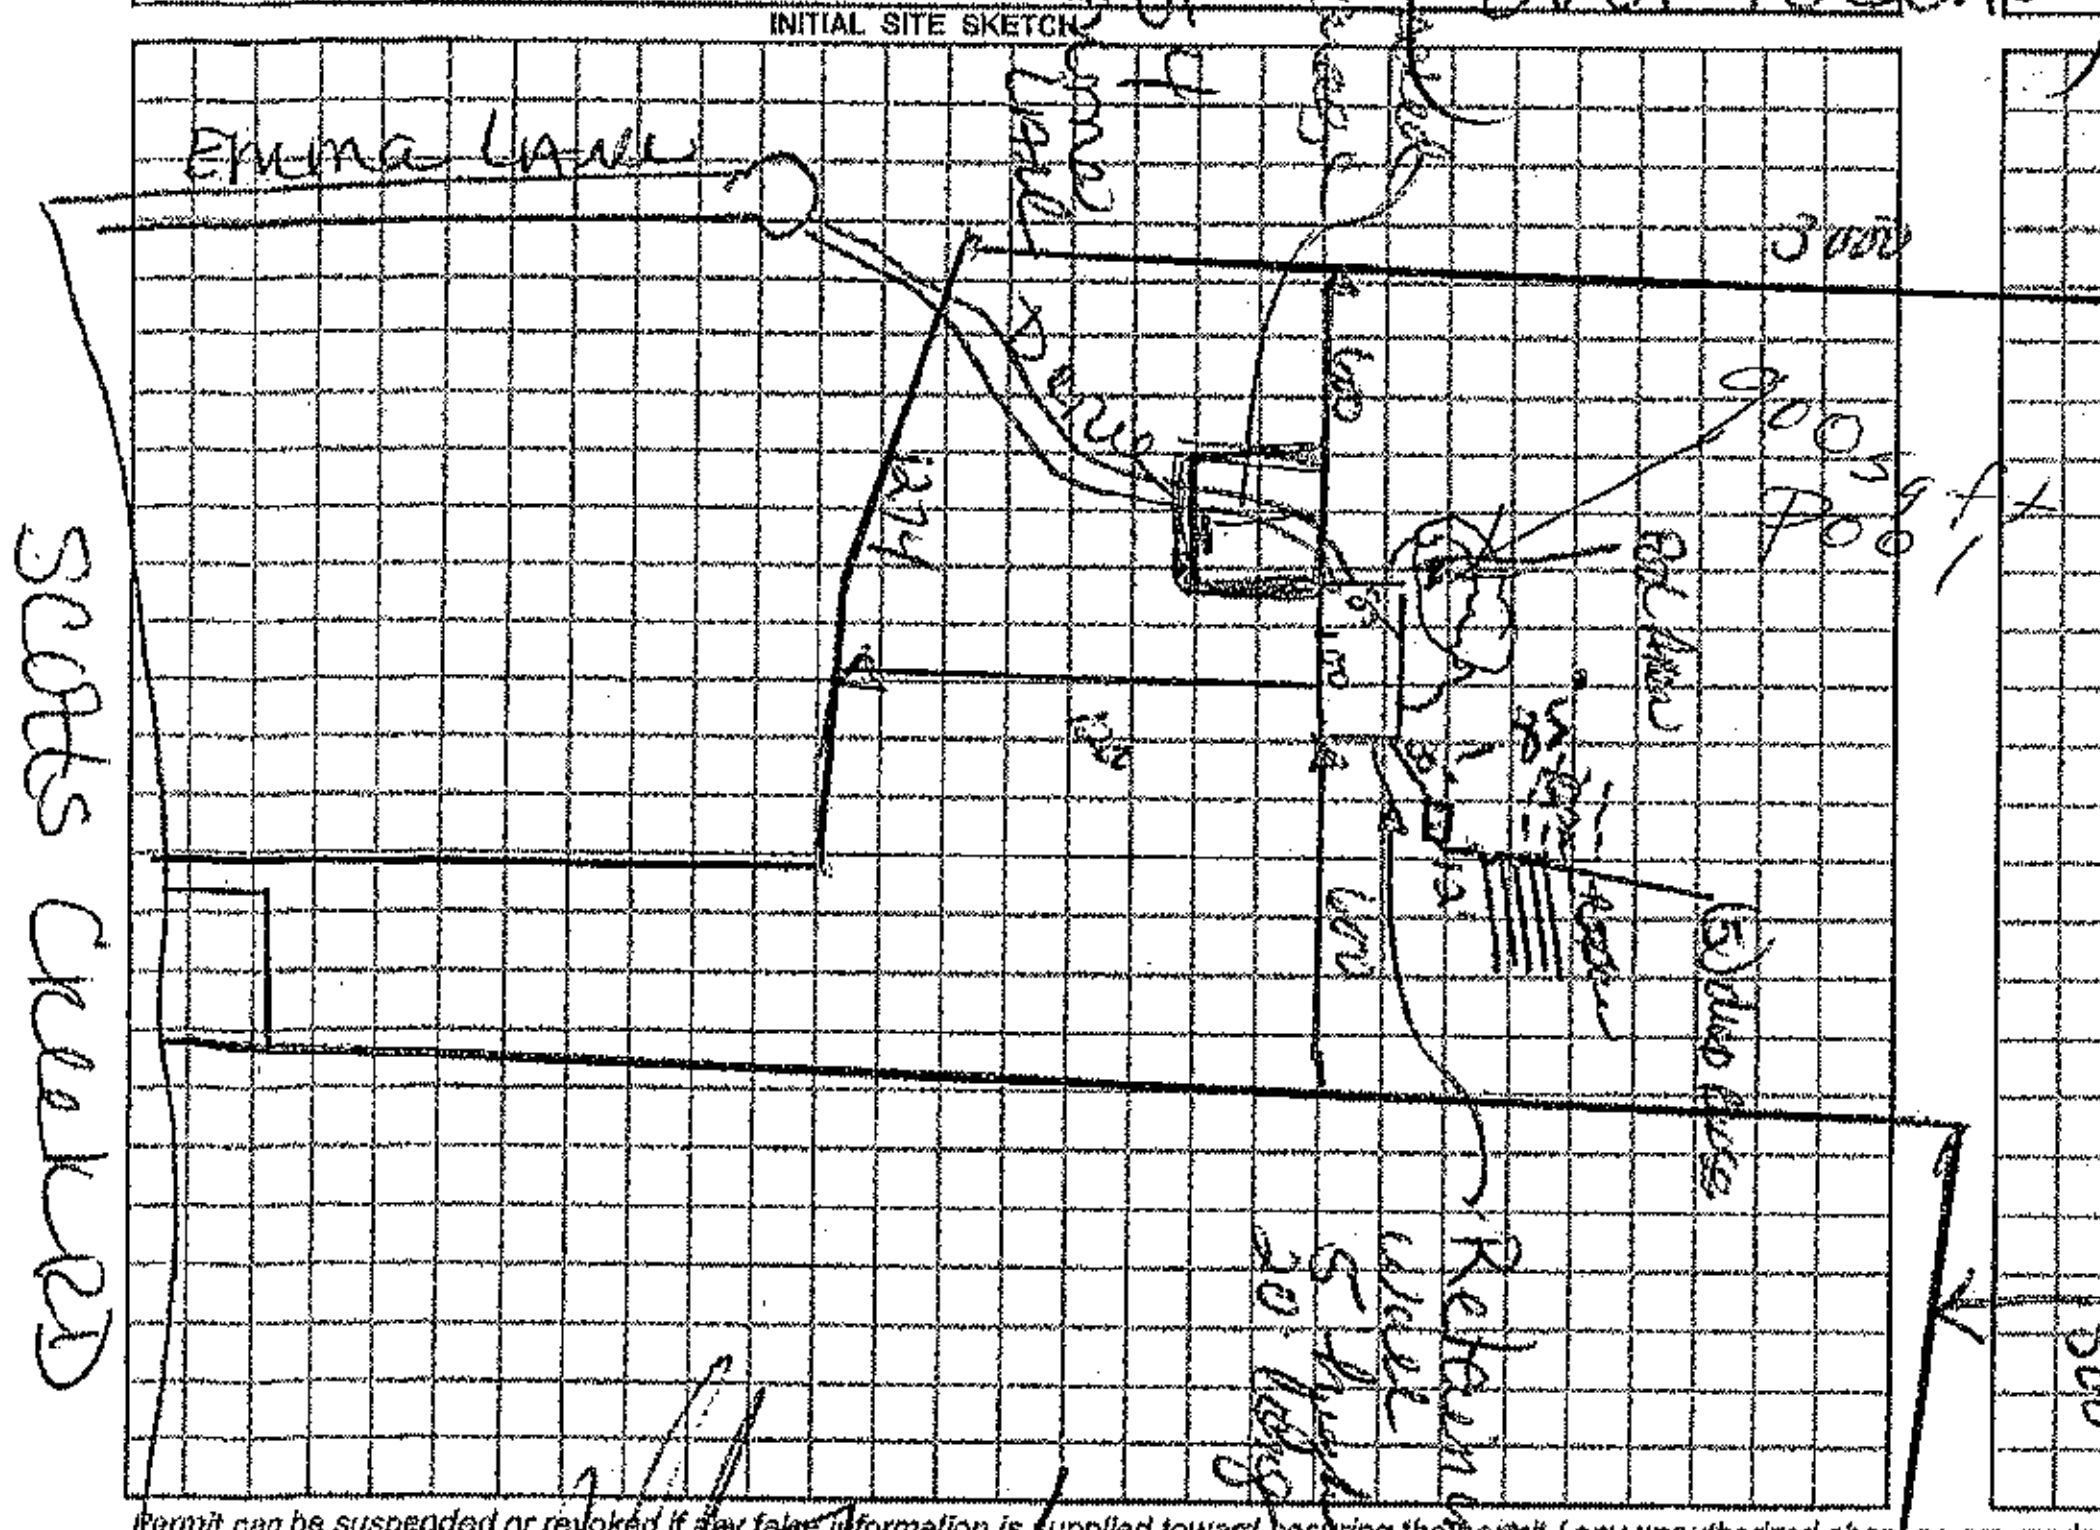

AS BUILT SKETCH

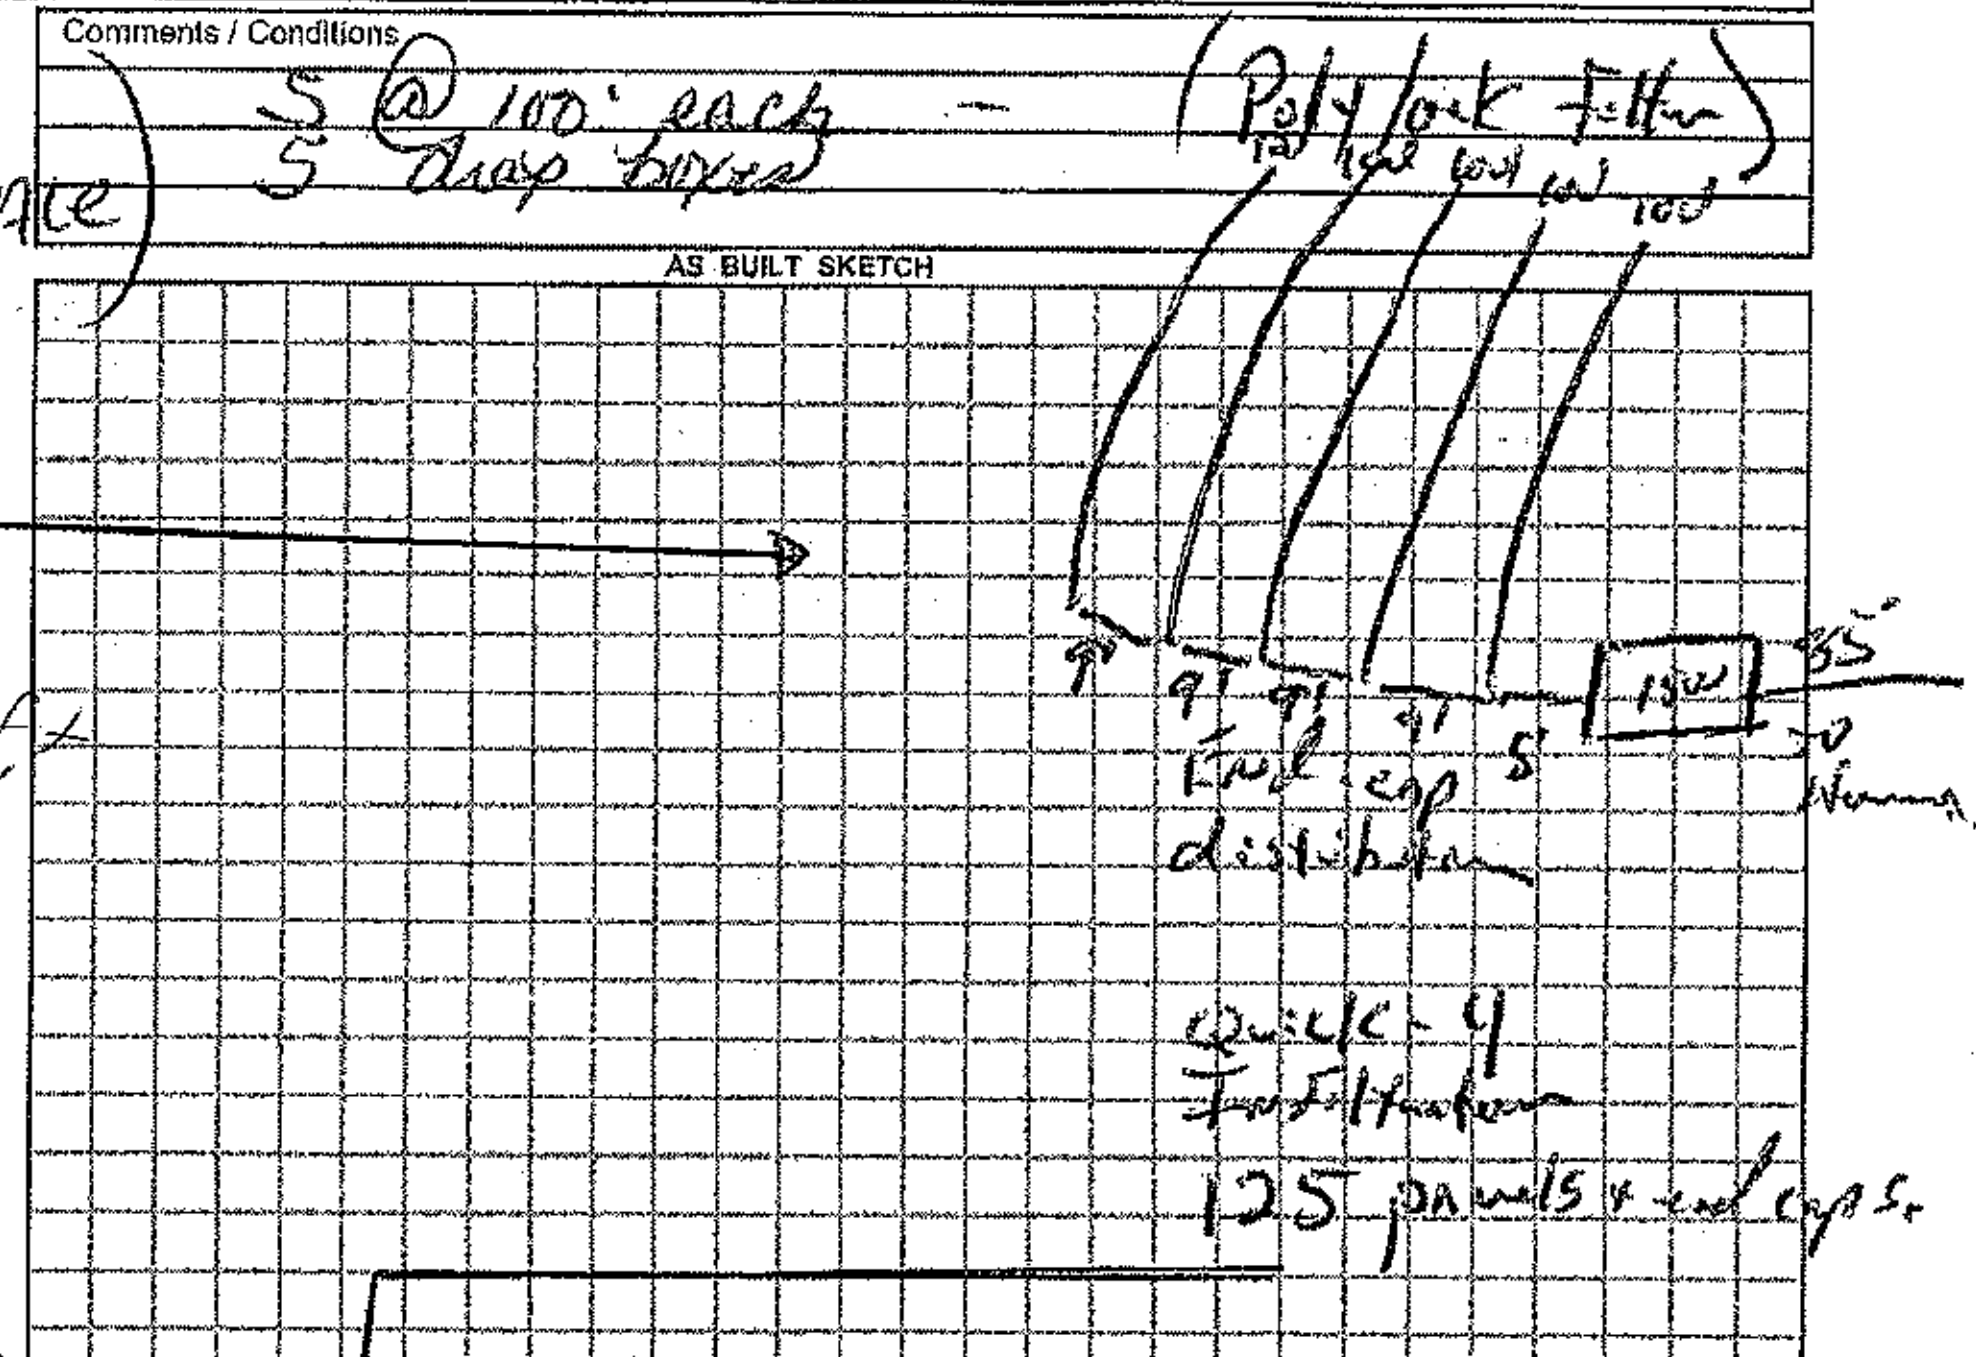

Location of the proposed 900 sq ft Pool addition does not appear to impact the existing on-site septic system or well. *NOTE:
REHS Date: 11/6/14
ICHD-Environmental Health Division

Permit can be suspended or revoked if any false information is supplied toward securing the permit / any unauthorized changes are made to the site / any unauthorized changes are made in the installation of the system.

☐ IMPROVEMENT PERMIT w/ plat valid without expiration ☐ IMPROVEMENT PERMIT w/ site plan valid for 60 mos. ☒ AUTHORIZATION TO CONSTRUCT valid for period equal to IMPROVEMENT PERMIT-not to exceed 60 mo.

Owner / Applicant Signature: — Date 11-2-09
Improvement Permit by: — Date 9-15-09
Authorization to Construct by: — Date 9-15-09

YOU SHOULD CONTACT A LOCATOR SERVICE PRIOR TO ANY EXCAVATION.

Installed by: Al Backhue
Operation Permit by: , R.S. — Date: 9 March 10
Existing System Inspected by: — Date:

WHITE COPY Environmental Health — YELLOW COPY (Final) Owner / Applicant — PINK COPY (Initial) Owner / Applicant