IREDELL COUNTY HEALTH DEPARTMENT

STATESVILLE 704-878-5305 MOORESVILLE 704-664-5281

IMPROVEMENT PERMIT / CERTIFICATE OF COMPLETION / OPERATION PERMIT / EXISTING SYSTEM INSPECTION

PROPERTY DESCRIPTION NO. 24927 DATE 9-23-96 TAX MAP NO. 9E-A-104 Watershed: ☐ Yes ☐ No

OWNER OR CONTRACTOR Stan Holt PHONE: Business Home 873-2145

ADDRESS 314 Hoilands Cr.

LOCATION Hwy 90 W past Loram IR Private Dr. at end

SUBDIVISION Hedrick Property BLOCK / SECTION LOT 1 LOT AREA 17.12 acres SITE CLASS. PS DESIGN FLOW 480 L.T.A.R. 1 3gal/ss/day

Septic Tank: 1000 Gallons; STB 1007 Date 7-24-97

Pump Tank: Gallons; PT Date 6-25-97

Pump Make: Model Serial No.

Nitrification Field: No Fields 1 Square Feet 1600 Linear Feet 533

No Lines 4 Trench Width 36" Max Trench Bottom Depth 36" Gravel Depth 12"

☒ New System ☐ Repair System Type: I, II, III, IV, V, VI

System Description: Conv. Gravity

Repair System Description: Conv. Gravity

Maintenance Agreement Required: ☐ Yes ☒ No

☐ House/Mod. Home No. Bedrooms 4

☐ Mobile Home No. Bathrooms 2 1/2

☐ Business No. Employees

☐ Other


☐ Slab ☐ Crawl Space ☒ Basement w/plumbing ☐ Basement wo/plumbing

Water Supply: ☒ Individual ☐ Community ☐ Public

Comments:


1 1 1 1

INITIAL SITE SKETCH

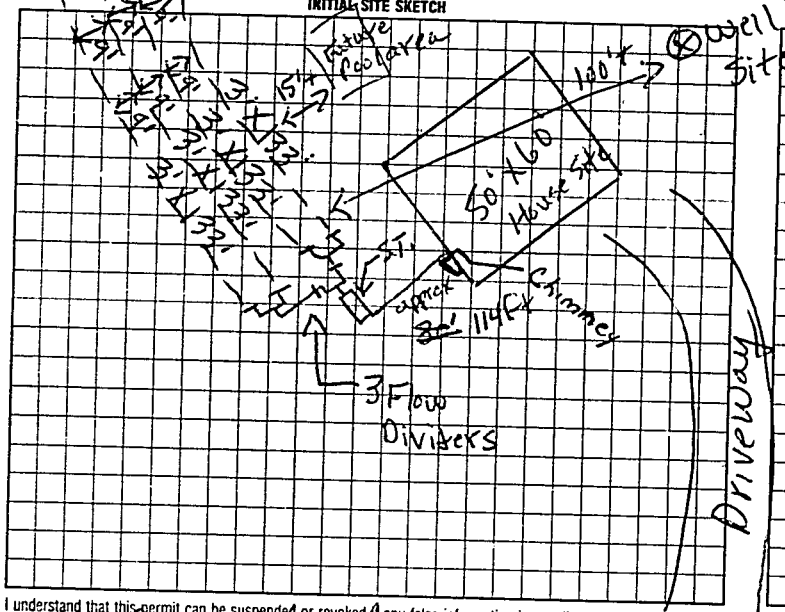

Comments:

AS BUILT SKETCH

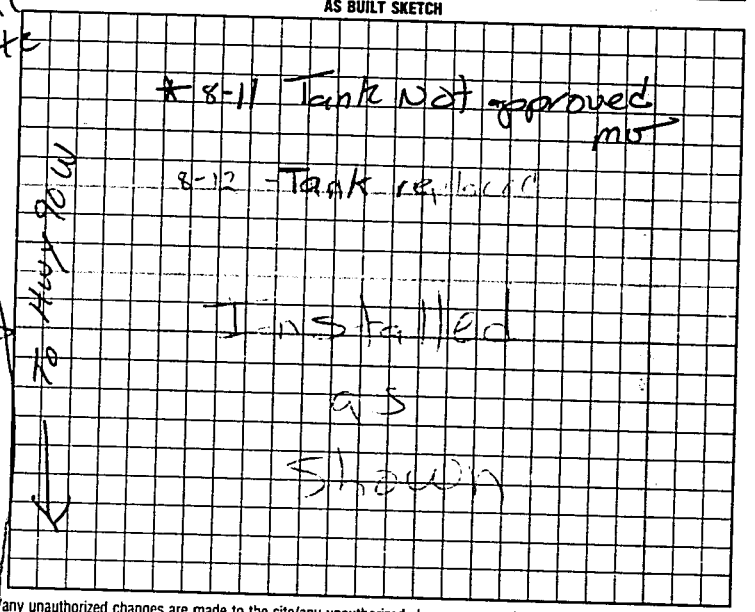

I understand that this permit can be suspended or revoked if any false information is supplied toward securing the permit, any unauthorized changes are made to the site/any unauthorized changes are made in the installation of the system.

Signed: X Carol N. Holt

Improvement Permit by: P.C. Moore date 9-23-96

Authorization to Construct by: P.C. Moore date 9-23-96

Existing System Inspected by: to cover

Installed by: James Hudder

Certificate of Completion by: date

Operation Permit by: [illegible] date 8-12-97

WHITE DEPT. COPY INSPECTION COPY (FINAL) GREEN OWNER COPY (FINAL) YELLOW INSPECTION COPY (INITIAL) PINK OWNER COPY (INITIAL) GOLD

Authorization to Const. Expires 6 months from issue