# IREDELL COUNTY HEALTH DEPARTMENT

STATESVILLE 704-878-5305 (CI) MOORESVILLE 704-664-5281

## IMPROVEMENT PERMIT / AUTHORIZATION TO CONSTRUCT / OPERATION PERMIT / EXISTING SYSTEM INSPECTION

PERMIT# 14705 PIN# 4716-15-1227 DATE 2-22-08

OWNER OR APPLICANT Johnny Morrison PHONE: Business 704-902-4552 Home 704-878-2963

ADDRESS Fortunes Trail

LOCATION 115N turn left Scotts Creek Rd - left on Fortune's Trail

SUBDIVISION Morrison Fields BLOCK / SECTION LOT 9 LOT AREA SITE CLASS. PS DESIGN FLOW 360 L.T.A.R. .03

Water Supply: ☐ Individual ☒ Public ☐ Community

☒ House/Mod. Home ☐ Mobile Home ☐ Business ☐ Other No. Bedrooms 3 No. Persons No. Employees

☒ New System ☐ Repair ☐ Expansion System Type: I II III IV V VI

System Description: 25% Reduction Gravity Start

Repair System Description: 25% Reduction Gravity

Maintenance Agreement Required: ☐ Yes ☒ No

☐ Basement w/plumbing ☐ Basement wo/plumbing

Septic Tank: 1000 Gallons: STB 1012 Date 8-7-07

Pump Tank: Gallons: PT Date

Pump Make: Model Serial No.

Nitrification Field: No Fields 1 Square Feet 1200 Linear Feet 300

No Lines 4 Trench Width 36" Max Trench Bottom Depth 36"

☒ Gravity ☐ Pressure ☒ Slab ☐ Crawl Space


Gravel Depth

Comments:/Conditions:

Comments:/Conditions:

TUFT

INITIAL SITE SKETCH

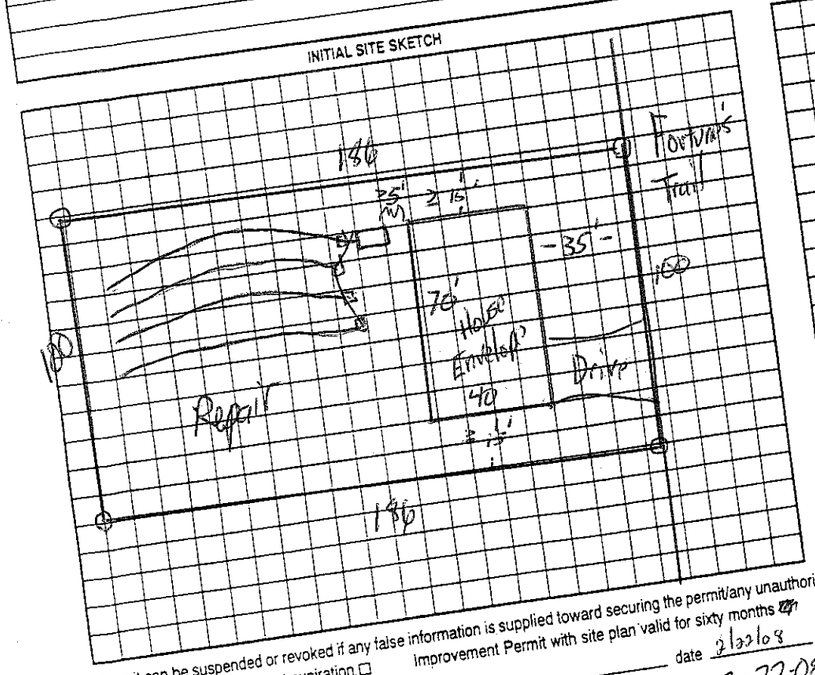


AS BUILT SKETCH

Permit can be suspended or revoked if any false information is supplied toward securing the permit/any unauthorized changes are made to the site/any unauthorized changes are made in the installation of the system. Improvement Permit with plat valid without expiration ☐ Improvement Permit with site plan valid for sixty months ☒ Authorization to Construct is valid for a period equal to that of Improvement Permit – not to exceed sixty months.

Signed:

Improvement Permit by: date 2/22/08

Authorization to Construct by: date 2-22-08

Installed by: David Fourtz date 5-1-08

Operation Permit by: date

Existing System Inspection by: date 2-22-08

HEALTH DEPT. COPY: WHITE OWNER COPY (FINAL): YELLOW OWNER COPY (INITIAL): PINK