IREDELL COUNTY HEALTH DEPARTMENT

Statesville Office (704) 878-5305 Mooresville Office (704) 660-3625 PERMIT # 200153

IMPROVEMENT PERMIT / AUTHORIZATION TO CONSTRUCT / OPERATION PERMIT / EXISTING SYSTEM

PIN # 4716151457

APPLICANT: Johnny Morrison APPLICANT ADDRESS: 122 Fortunes Trail

SITE ADDRESS: 110 Fortunes Trail PHONE: 704-878-2963 ALT. PHONE: N/A

SITE DIRECTIONS: Hwy 115 N TL Scotts Creek Rd TL Fortunes Trail

SUBDIVISION: Morrison Fields SECTION: N/A LOT # 11 LOT AREA: 0.44 acres DESIGN FLOW: 360gpd L.T.A.R.: 0.3

Septic Tank 1000 (gal) STB 1012-1000 Date 7-28-14
Pump Tank (gal) PT Date
Pump Make Model Serial #
Nitrification Fields 1 # Lines 5 Linear Ft: 200
Trench Width 24" Max. Trench Bottom Depth 36" Gravel Depth N/A


☑ New System ☐ Repair ☐ Expansion System Type: I II ☒ III IV V VI
System Description: 50% Reduction
Repair System Description: 50% Reduction
Maintenance Agreement Required: ☐ YES ☑ NO
☑ GRAVITY ☐ PRESSURE

☑ Residence No. Bedrooms 3
☐ Business No. Persons 6
☐ Other No. Employees
☑ Slab ☐ Crawl Space
☐ Basement w/plumbing ☐ Basement w/o plumbing

Water Supply: ☐ Private ☑ Public ☐ Community

Comments / Conditions: Install a 50% Reduction system on contour with parallel distribution utilizing an effluent splitter (such as Zoeller). Water line shall be a minimum of 10' away from septic tank system & repair area. Do NOT Cut for house site.

INITIAL SITE SKETCH

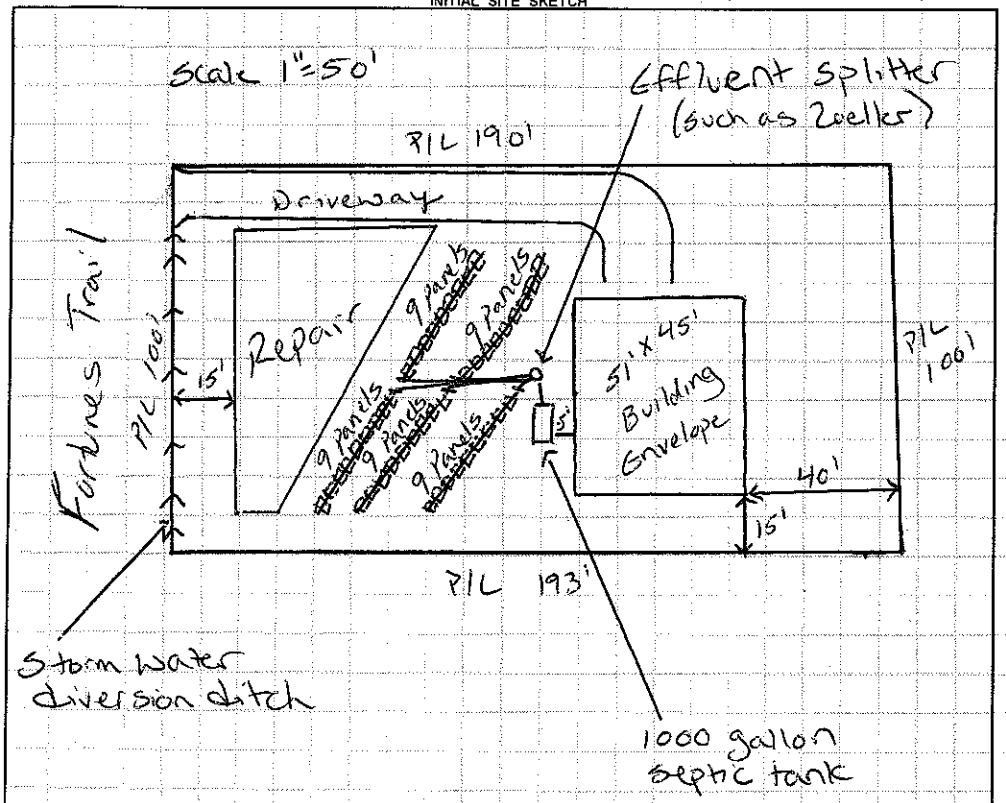

AS BUILT SKETCH

- Yellow Tuf-Tite filter installed
- 2" PVC ST marker installed
- Installed as drawn

Permit can be suspended or revoked if any false information is supplied toward securing the permit / any unauthorized changes are made to the site / any unauthorized changes are made in the installation of the system. **CONTACT A LOCATOR SERVICE PRIOR TO ANY EXCAVATION**

☐ **IMPROVEMENT PERMIT** ***with plat*** *valid without expiration.* ☑ **IMPROVEMENT PERMIT** ***with site plan*** *valid for 60 mos.* ☑ **AUTHORIZATION TO CONSTRUCT** *valid for period equal to IMPROVEMENT PERMIT--not to exceed 60 mo.*

Owner / Applicant Signature: Date: 12/23/13 Installed by: David Yountz Grading

IMPROVEMENT PERMIT by: Justin Henderson Date: 12-12-13 OPERATION PERMIT by: Justin Henderson Date: 5-9-14

AUTHORIZATION TO CONSTRUCT by: Justin Henderson Date: 12-12-13 Existing System Inspected by: Date:

Health Dept. Copy - WHITE Applicant (Final Approval) - YELLOW Applicant (Conditional Approval) - PINK