IREDELL COUNTY HEALTH DEPARTMENT - *ENVIRONMENTAL HEALTH* CF ☑ STATESVILLE OFFICE 704-878-5305 ☐ MOORESVILLE OFFICE 704-664-5281

IMPROVEMENT PERMIT / AUTHORIZATION TO CONSTRUCT / OPERATION PERMIT / EXISTING SYSTEM INSPECTION

PERMIT # 170549 PIN # 4716 15 3498 DATE FEBRUARY

OWNER JOHNNY MORRISON APPLICANT: SAME PHONE: Home/Cell # 704-878-2963 Business # 704-902-4552

SITE ADDRESS 109 FORTUNES TRAIL OWNER / APPLICANT ADDRESS 122 FORTUNES TRAIL, STATESVILLE, NC

SITE DIRECTIONS NC 115 N, TL SCOTTS CREEK ROAD, TL FORTUNES TRAIL 2ND LOT ON LEFT

SUBDIVISION MORRISON FIELDS BLOCK / SECTION LOT # 2 LOT AREA 0.433 AC DESIGN FLOW 360 L.T.A.R. 0.30 GPD/FT2

Septic Tank 1000 Gallons: STB 1012 Date 2-6-12

Pump Tank Gallons: P T Date

Pump Make Model Serial #

No. Nitrification Fields: 1 No. Lines 4 Linear Feet 300

Trench Width 36" Max. Trench Bottom Depth 36" Gravel Depth N/A

☑ New System ☐ Repair ☐ Expansion System Type I II (III) IV V VI

System Description: 25% REDUCTION, GRAVITY

Repair System Description: 50% REDUCTION, LOW-PRESS

Maintenance Agreement Required ☐ YES ☑ NO

☑ GRAVITY ☐ PRESSURE

☑ Residence No. Bedrooms 3

☐ Business No. Persons

☐ Other No. Employees

☑ Slab ☐ Crawl Space


☐ Basement w/plumbing ☐ Basement w/o plumbing

Water Supply: ☐ Private ☑ Public ☐ Community


Comments / Conditions ① INSTALL 25% REDUCTION SYSTEM ON CONTOUR AS SHOWN USING SERIAL DISTRIBUTION (2) KEEP SYSTEM MIN. 15' FROM SURFACE DIVERSION DITCH 5' FROM FOUNDATION (3) REMOVE STOCKPILED SOIL PRIOR TO ISSUANCE OF A.C.

④ GRADE OUT OLD FIELD TERRACE TO UNIFORM SLOPE

INITIAL SITE SKETCH

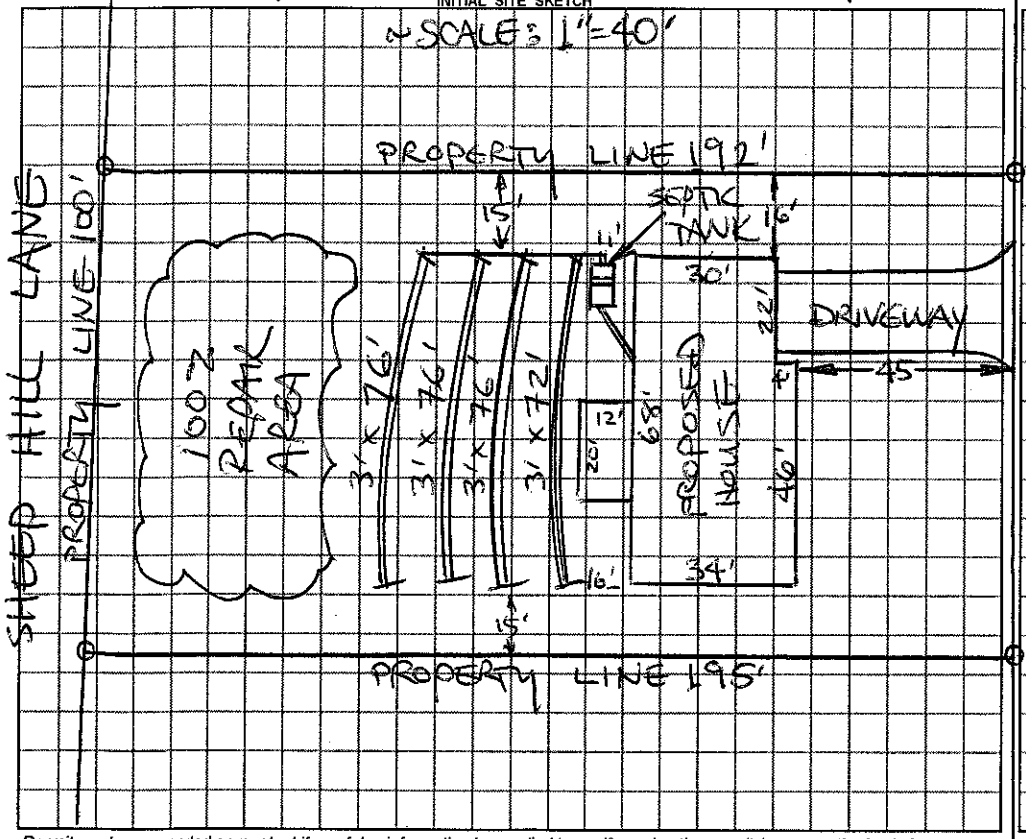

AS BUILT SKETCH

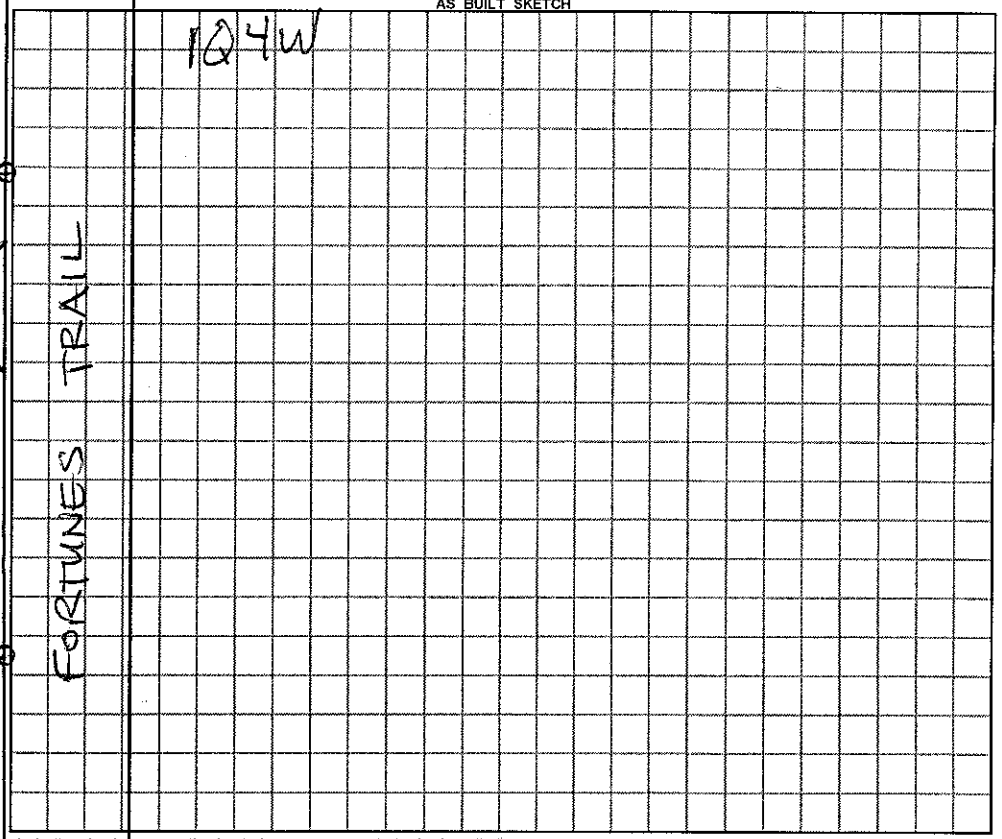

Permit can be suspended or revoked if any false information is supplied toward securing the permit / any unauthorized changes are made to the site / any unauthorized changes are made in the installation of the system.

☐ ***IMPROVEMENT PERMIT*** with plat valid without expiration. ☑ ***IMPROVEMENT PERMIT*** with plat ~~valid without expiration~~ site plan valid 60 mo. ☐ ***AUTHORIZATION TO CONSTRUCT*** valid for period equal to IMPROVEMENT PERMIT--not to exceed 60 mo.

Owner / Applicant Signature: Date 2/22/12 Installed by: Yountz Grading

IMPROVEMENT PERMIT by: R. STEVE HEDRICK REHS Date 2-22-12 OPERATION PERMIT by: REHS Date 6-8-12

AUTHORIZATION TO CONSTRUCT by: R. STEVE HEDRICK REHS Date 3-12-12 Existing System Inspected by: REHS Date

YOU SHOULD CONTACT A LOCATOR SERVICE PRIOR TO ANY EXCAVATION

White Copy – Environmental Health YELLOW COPY (Final) Owner / Applicant PINK COPY (Initial) Owner / Applicant