IREDELL COUNTY HEALTH DEPARTMENT - *ENVIRONMENTAL HEALTH* ☑ STATESVILLE OFFICE 704-878-5305 ☐ MOORESVILLE OFFICE 704-664-5281

IMPROVEMENT PERMIT / AUTHORIZATION TO CONSTRUCT / OPERATION PERMIT / EXISTING SYSTEM INSPECTION

PERMIT # 170548 PIN # 4716 15 4518 DATE FEBRUARY 22, 2012

OWNER JOHNNY MORRISON APPLICANT: SAME PHONE: Home/Cell # 704-878-2963 Business # 704-902-4552

SITE ADDRESS 105 FORTUNES TRAIL OWNER / APPLICANT ADDRESS 122 FORTUNES TRAIL, STATESVILLE, NC

SITE DIRECTIONS NC 115 N, TL SCOTTS CREEK ROAD, TL FORTUNES TRAIL, 1ST LOT ON LEFT

SUBDIVISION MORRISON FIELDS BLOCK / SECTION LOT # 1 LOT AREA 0.499 AC± DESIGN FLOW 360 L.T.A.R. 0.30 gpd/ft²

Septic Tank 1000 Gallons: STB 1017 Date 7-18-12 ☑ New System ☐ Repair ☐ Expansion System Type I II (III) IV V VI

Pump Tank ____ Gallons: P T ____ Date ____ System Description: 25% REDUCTION EQUIM

Pump Make ____ Model ____ Serial # ____ Repair System Description: 50% REDUCTION, LOW-PRESSURE

No. Nitrification Fields: 1 No. Lines 4 Linear Feet 300 Maintenance Agreement Required ☐ YES ☒ NO

Trench Width 36" Max. Trench Bottom Depth 36" Gravel Depth N/A ☑ GRAVITY ☐ PRESSURE

☑ Residence No. Bedrooms 3 Water Supply

☐ Business No. Persons ____ ☐ Private

☐ Other No. Employees ____ ☑ Public


☑ Slab ☐ Crawl Space ☐ Community

☐ Basement w/plumbing ☐ Basement w/o plumbing


Comments / Conditions: 1) INSTALL 25% REDUCTION SYSTEM ON CONTOUR AS SHOWN. KEEP SYSTEM MINIMUM 15' FROM SURFACE DIVERSION DITCH, 5' FROM BUILDING FOUNDATION

2) REMOVE STOCK PILED SOIL PRIOR TO ISSUANCE OF AC.

INITIAL SITE SKETCH

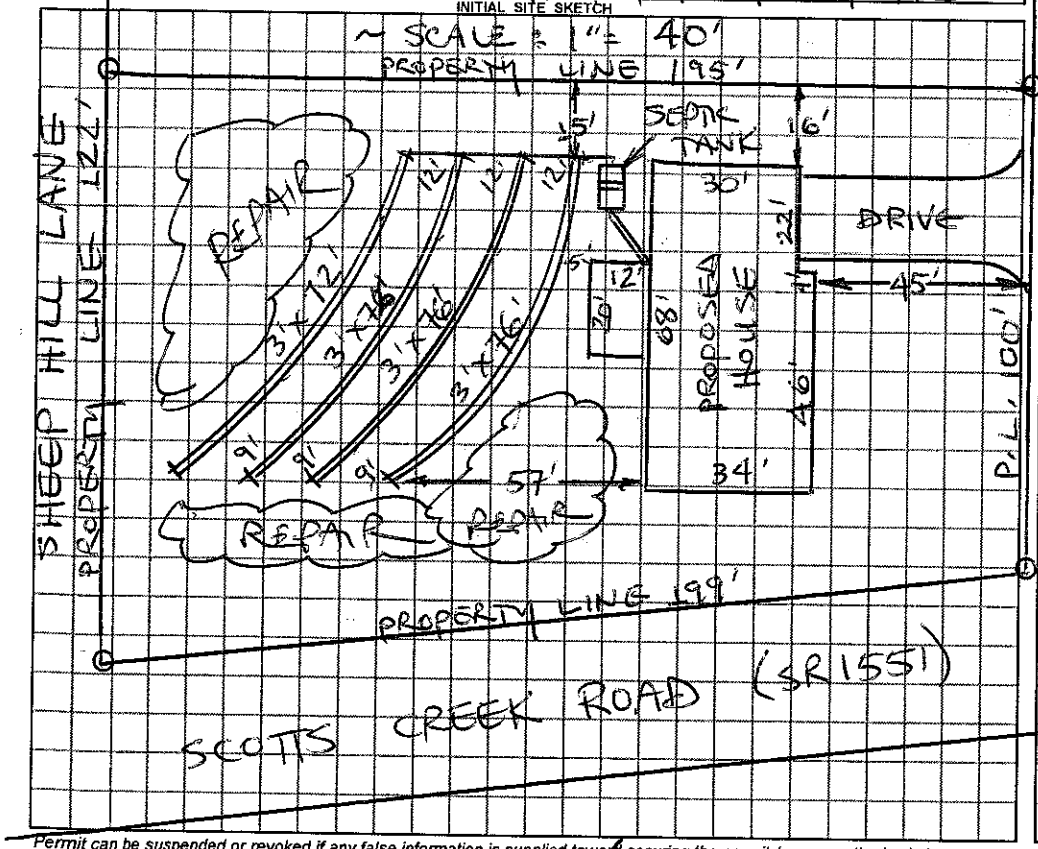

AS BUILT SKETCH

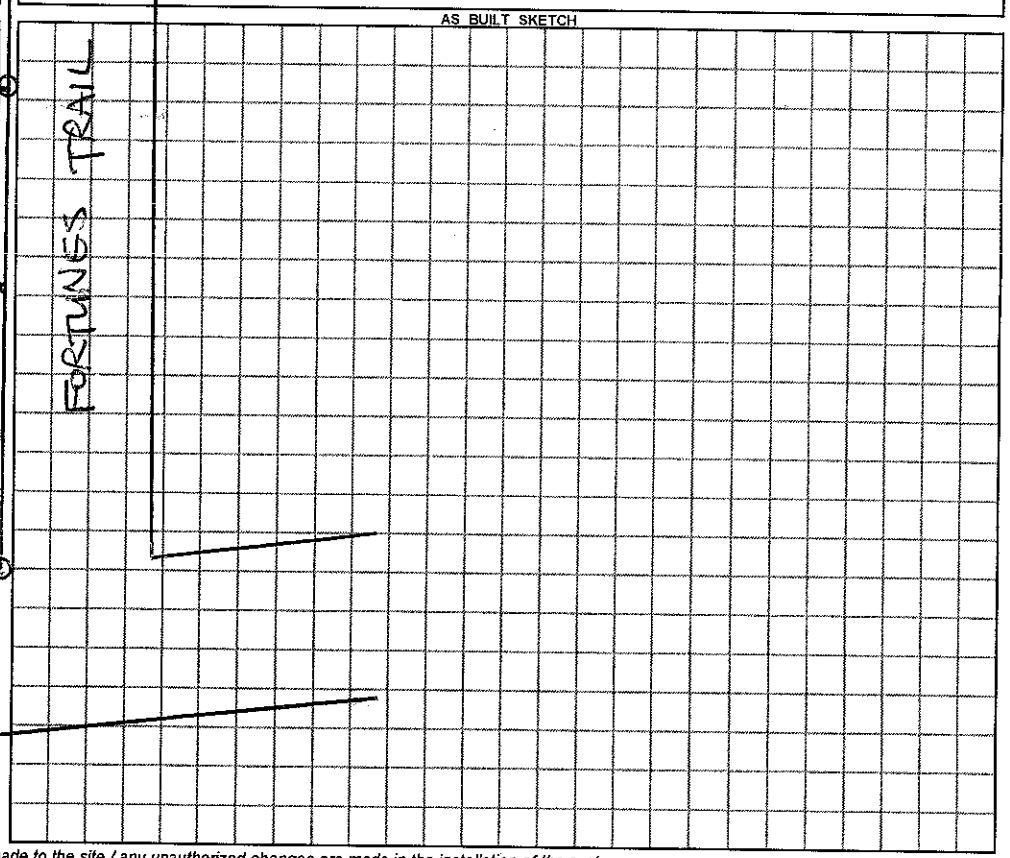

Permit can be suspended or revoked if any false information is supplied toward securing the permit / any unauthorized changes are made to the site / any unauthorized changes are made in the installation of the system.

☐ ***IMPROVEMENT PERMIT*** with plat valid without expiration. ☑ ***IMPROVEMENT PERMIT*** with plat valid without expiration. site plan valid 60 mo. ☐ ***AUTHORIZATION TO CONSTRUCT*** valid for period equal to IMPROVEMENT PERMIT--not to exceed 60 mo.

Owner / Applicant Signature: John Morrison Date 2/22/12 Installed by: Yountz Grading

IMPROVEMENT PERMIT by: R. STEVE HEDRICK REHS Date 2-22-12 OPERATION PERMIT by: Jimmy Yountz REHS Date 7-14-13

AUTHORIZATION TO CONSTRUCT by: R. STEVE HEDRICK REHS Date 3-12-12 Existing System Inspected by: ____ REHS Date ____

YOU SHOULD CONTACT A LOCATOR SERVICE PRIOR TO ANY EXCAVATION

White Copy – Environmental Health YELLOW COPY (Final) Owner / Applicant PINK COPY (Initial) Owner / Applicant