IREDELL COUNTY HEALTH DEPARTMENT

STATESVILLE 704-878-5305 MOORESVILLE 704-664-5281

IMPROVEMENT PERMIT / CERTIFICATE OF COMPLETION / OPERATION PERMIT / EXISTING SYSTEM INSPECTION

PROPERTY DESCRIPTION NO. 066396 DATE 5-14-97 TAX MAP NO. 4716156303 (PT) Watershed: ☐ Yes ☒ No

OWNER OR CONTRACTOR MARSHALL LEE GODFREY PHONE: Business 872-3976 Home

ADDRESS 482 MILLER FARM ROAD, STATESVILLE NC 28677

LOCATION NC 115 N, TL SCOTTS CREEK RD, TL SHEEP HILL LANE LOT AT END ON LEFT

SUBDIVISION SCOTTS CREEK UNNAMED BLOCK / SECTION LOT 7 LOT AREA 22,759 FT² SITE CLASS. PSI DESIGN FLOW 240 L.T.A.R. 0.3 GPD/FT²

Septic Tank: 1000 Gallons; STB 794 Date 2-21-97

Pump Tank: Gallons; PT Date

Pump Make: Model Serial No.

Nitrification Field: No Fields 1 Square Feet 860 Linear Feet 270

No Lines THREE Trench Width 36" Max Trench Bottom Depth 36" Gravel Depth 12"

☒ New System ☐ Repair System Type: I, II, III, IV, V, VI

System Description: CONVENTIONAL GRAVITY

Repair System Description: CHAMBERED, GRAVITY

Maintenance Agreement Required: ☐ Yes ☒ No

☐ House/Mod. Home No. Bedrooms 2

☐ Mobile Home No. Bathrooms 2

☐ Business No. Employees

☐ Other 240 GPD ONLY


☐ Slab ☒ Crawl Space ☐ Basement w/plumbing ☐ Basement wo/plumbing

Water Supply: ☐ Individual ☐ Community ☒ Public


Comments:

Comments:

INITIAL SITE SKETCH

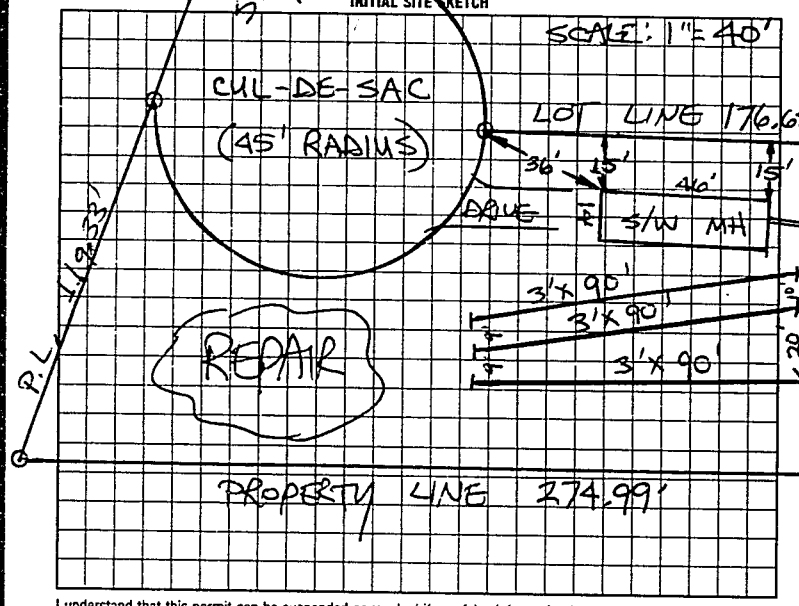

AS BUILT SKETCH

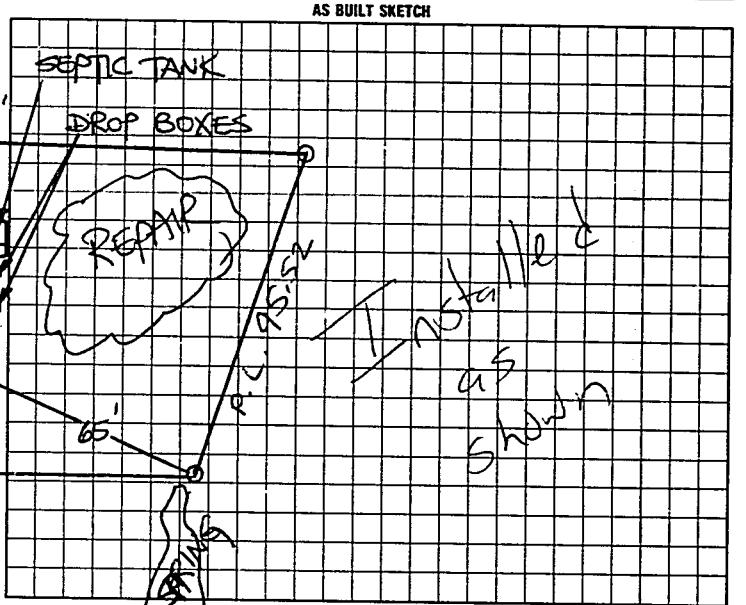

I understand that this permit can be suspended or revoked if any false information is supplied toward securing the permit/any unauthorized changes are made to the site/any unauthorized changes are made in the installation of the system. Improvement Permit is valid for 60 months from date of issuance. AUTHORIZATION TO CONSTRUCT IS VALID FOR 60 MONTHS FROM DATE OF ISSUANCE.

Signed:

Installed by: James Huddler

Improvement Permit by: STEVE HEDRICK date 5-14-97

AUTH. TO CONST. ~~Existing System Inspection~~ by: STEVE HEDRICK date 5-14-97

~~Certificate of Completion by:~~ date

Operation Permit by: date 5-28-97

HEALTH DEPT. COPY: WHITE INSPECTION COPY (FINAL): GREEN OWNER COPY (FINAL): YELLOW INSPECTION COPY (INITIAL): PINK OWNER COPY (INITIAL): GOLD

E 69000