IREDELL COUNTY HEALTH DEPARTMENT

STATESVILLE 704-878-5305 MOORESVILLE 704-664-5281

IMPROVEMENT PERMIT / CERTIFICATE OF COMPLETION / OPERATION PERMIT / EXISTING SYSTEM INSPECTION

PROPERTY DESCRIPTION NO. 066395 DATE 5-14-97 TAX MAP NO. 4716156303 (PT) Watershed: ☐ Yes ☒ No

OWNER OR CONTRACTOR MARSHALL LEE GODFREY PHONE: Business Home 872-3976

ADDRESS 482 MILLER FARM ROAD, STATESVILLE, NC 28677

LOCATION NC 115 N, TL SCOTTS CREEK ROAD, TL SHEEP HILL LANE, LOT # 6 ON LEFT

SUBDIVISION SCOTTS CREEK LANDING BLOCK / SECTION ____ LOT 6 LOT AREA 19,528 SITE CLASS. PS DESIGN FLOW 240 L.T.A.R. 0.30 GPD/FT²

Septic Tank: 1000 Gallons; STB 794 Date 2-20-97

Pump Tank: ____ Gallons; PT ____ Date ____

Pump Make: ____ Model ____ Serial No. ____

Nitrification Field: No Fields 1 Square Feet 810 Linear Feet 270

No Lines THREE Trench Width 36" Max Trench Bottom Depth 36" Gravel Depth 12"

☒ New System ☐ Repair System Type: I, II, III, IV, V, VI

System Description: CONVENTIONAL, GRAVITY

Repair System Description: PPBPS, GRAVITY pump

Maintenance Agreement Required: ☐ Yes ☒ No

☐ House/Mod. Home No. Bedrooms 3

☒ Mobile Home No. Bathrooms 2

☐ Business No. Employees ____

☐ Other ____


☐ Slab ☒ Crawl Space ☐ Basement w/plumbing ☐ Basement wo/plumbing

Water Supply: ☐ Individual ☐ Community ☒ Public


Comments:

Comments:

INITIAL SITE SKETCH

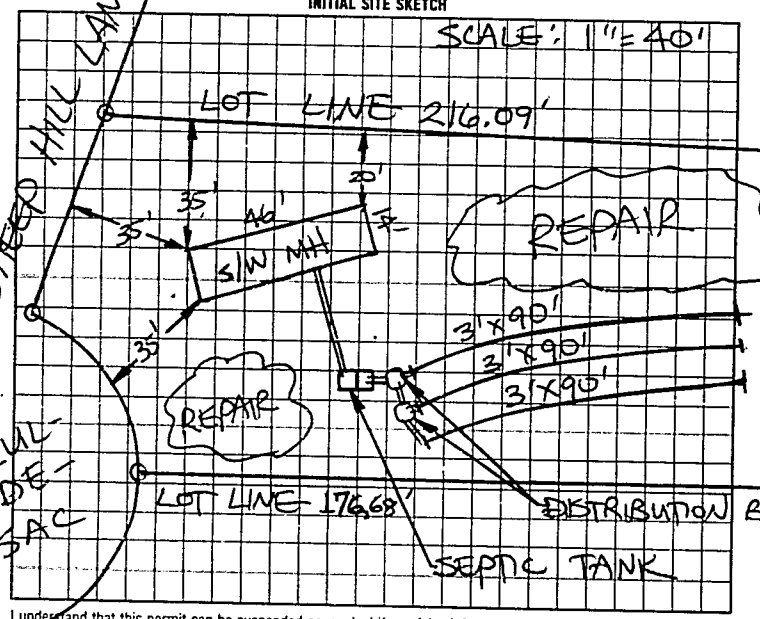

AS BUILT SKETCH

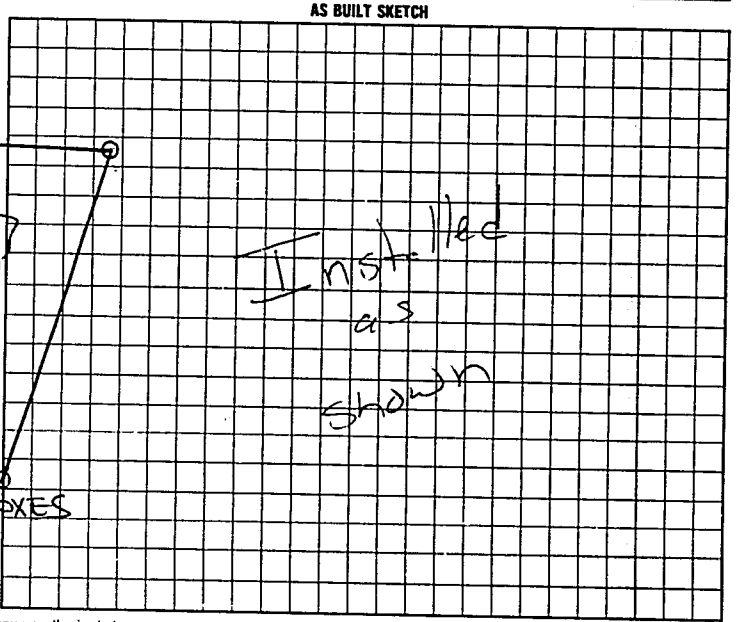

I understand that this permit can be suspended or revoked if any false information is supplied toward securing the permit/any unauthorized changes are made to the site/any unauthorized changes are made in the installation of the system. Improvement Permit is valid for 60 months from date of issuance. AUTHORIZATION TO CONSTRUCT IS VALID FOR 60 MONTHS FROM DATE OF ISSUANCE.

Signed: Marshall Lee Godfrey

Improvement Permit by: STEVE HEDRICK date 5-14-97

~~Authorization to Construct~~ by: STEVE HEDRICK date 5-14-97

Installed by: James Hudler

~~Certificate of Completion by:~~ ____ date ____

Operation Permit by ____ date 5-28-97

HEALTH DEPT. COPY: WHITE INSPECTION COPY (FINAL): GREEN OWNER COPY (FINAL): YELLOW INSPECTION COPY (INITIAL): PINK OWNER COPY (INITIAL): GOLD