IREDELL COUNTY HEALTH DEPARTMENT

STATESVILLE 704-878-5305 MOORESVILLE 704-664-5281

IMPROVEMENT PERMIT / CERTIFICATE OF COMPLETION / OPERATION PERMIT / EXISTING SYSTEM INSPECTION

PROPERTY DESCRIPTION NO. 066394 DATE 5-14-97 TAX MAP NO. 4716156303 (PT) Watershed: ☐ Yes ☑ No

OWNER OR CONTRACTOR MARSHALL LEE GODFREY PHONE: Business Home 872-3976

ADDRESS 482 MILLER FARM ROAD, STATESVILLE, NC 28677

LOCATION NC 115 N, TL SCOTTS CREEK RD, TL SHEEP HILL LANE 5TH LOT ON LEFT

SUBDIVISION SCOTTS CREEK LANDING BLOCK / SECTION LOT 5 LOT AREA 20,420 FT² SITE CLASS. PS DESIGN FLOW 240 L.T.A.R. 0.30 GPD/FT²

Septic Tank: 1000 Gallons; STB 794 Date 2-24-97

Pump Tank: Gallons; PT Date

Pump Make: Model Serial No.

Nitrification Field: No Fields 1 Square Feet 810 Linear Feet 270

No Lines THREE Trench Width 36" Max Trench Bottom Depth 36" Gravel Depth 12"

☑ New System ☐ Repair System Type: I, II, III, IV, V, VI

System Description: CONVENTIONAL GRAVITY

Repair System Description: PDP85 PUMP 600 GAL

Maintenance Agreement Required: ☐ Yes ☑ No

☐ House/Mod. Home ☑ Mobile Home ☐ Business ☐ Other

No. Bedrooms 2 No. Bathrooms 2 No. Employees


☐ Slab ☑ Crawl Space ☐ Basement w/plumbing ☐ Basement wo/plumbing

Water Supply: ☐ Individual ☐ Community ☑ Public


Comments:

Comments:

INITIAL SITE SKETCH

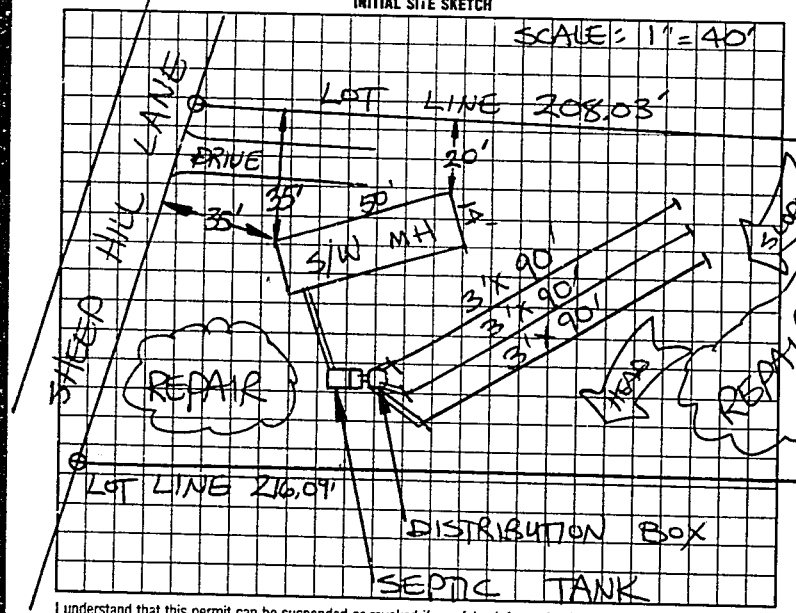

AS BUILT SKETCH

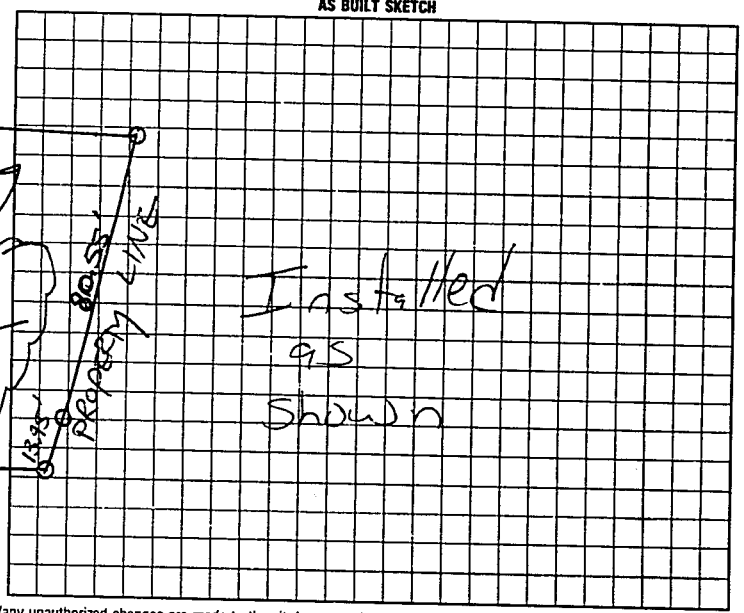

I understand that this permit can be suspended or revoked if any false information is supplied toward securing the permit/any unauthorized changes are made to the site/any unauthorized changes are made in the installation of the system. Improvement Permit is valid for 60 months from date of issuance. AUTHORIZATION TO CONSTRUCT IS VALID FOR 60 MONTHS FROM DATE OF ISSUANCE.

Signed: Marshall Lee Godfrey

Improvement Permit by: STEVE HEDRICK date 5-14-97

AUTH. TO CONST. ~~Existing System Inspection~~ by: STEVE HEDRICK date 5-14-97

Installed by: James Huddle

~~Certificate of Completion by:~~ date

Operation Permit by: Mark C Ostrus date 5-28-97

HEALTH DEPT. COPY: WHITE INSPECTION COPY (FINAL): GREEN OWNER COPY (FINAL): YELLOW INSPECTION COPY (INITIAL): PINK OWNER COPY (INITIAL): GOLD