IREDELL COUNTY HEALTH DEPARTMENT

STATESVILLE 704-878-5305 MOORESVILLE 704-664-5281

IMPROVEMENT PERMIT / CERTIFICATE OF COMPLETION / OPERATION PERMIT / EXISTING SYSTEM INSPECTION

PROPERTY DESCRIPTION NO. 066393 DATE 5-14-97 TAX MAP NO. 4716 156303 (PT)

OWNER OR CONTRACTOR MARSHALL LEE GODFREY PHONE: Business Home 872-3976

ADDRESS 482 MILLER FARM RD STATESVILLE, NC 28677

LOCATION NC 115 N, TL SCOTTS CREEK RD, TL STEEP HILL LANE, 4TH LOT ON LEFT

SUBDIVISION SCOTTS CREEK LANDING BLOCK / SECTION LOT 4 LOT AREA 19,773 FT² SITE CLASS. PS DESIGN FLOW 240 L.T.A.R. 0.30 GPD/FT²

Septic Tank: 1000 Gallons; STB 794 Date 2-21-97
Pump Tank: Gallons; PT Date
Pump Make: Model Serial No.
Nitrification Field: No Fields 1 Square Feet 810 Linear Feet 270
No Lines THREE Trench Width 36" Max Trench Bottom Depth 36" Gravel Depth 12"

☑ New System ☐ Repair System Type: I, II, III, IV, V, VI
System Description: CONVENTIONAL GRAVITY
Repair System Description: PPBPS PUMP
Maintenance Agreement Required: ☐ Yes ☑ No

☐ House/Mod. Home ☑ Mobile Home ☐ Business ☐ Other
No. Bedrooms 2 No. Bathrooms 2 No. Employees


☐ Slab ☑ Crawl Space ☐ Basement w/plumbing ☐ Basement wo/plumbing

Water Supply: ☐ Individual ☐ Community ☑ Public


Comments:

Comments:

INITIAL SITE SKETCH

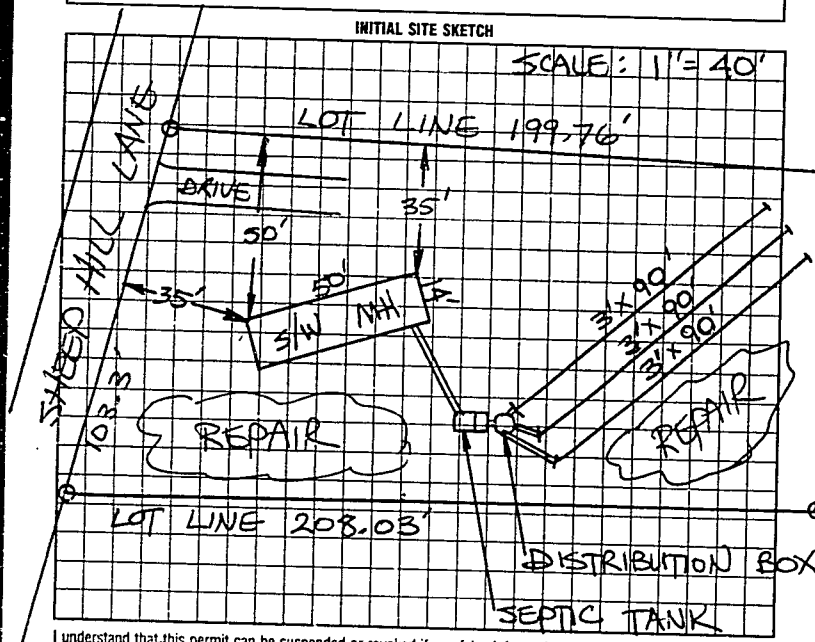

AS BUILT SKETCH

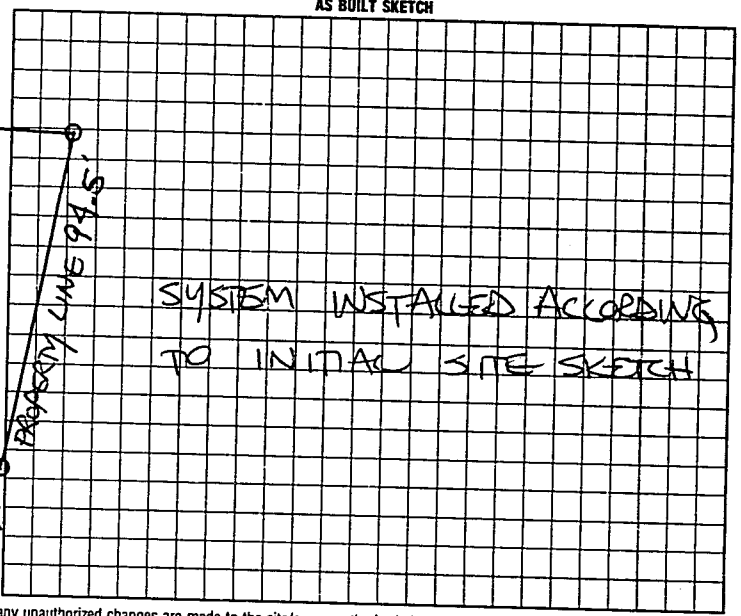

I understand that this permit can be suspended or revoked if any false information is supplied toward securing the permit/any unauthorized changes are made to the site/any unauthorized changes are made in the installation of the system. Improvement Permit is valid for ~~60~~ months from date of issuance. AUTHORIZATION TO CONSTRUCT IS VALID FOR 60 MONTHS FROM DATE OF ISSUANCE.

Signed: Marshall Lee Godfrey

Improvement Permit by: STEVE HEDRICK date 5-14-97

AUTH. TO CONST. ~~Existing System Inspection~~ by: STEVE HEDRICK date 5-14-97

Installed by: JAMES HUDLER

~~Certificate of Completion~~ by: date

Operation Permit by: STEVE HEDRICK date 5-29-97

HEALTH DEPT. COPY WHITE INSPECTION COPY (FINAL) GREEN OWNER COPY (FINAL) YELLOW INSPECTION COPY (INITIAL) PINK OWNER COPY (INITIAL) GOLD