IREDELL COUNTY HEALTH DEPARTMENT

STATESVILLE 704-878-5305 MOORESVILLE 704-664-5281

IMPROVEMENT PERMIT / CERTIFICATE OF COMPLETION / OPERATION PERMIT / EXISTING SYSTEM INSPECTION

PROPERTY DESCRIPTION NO. 066392 DATE 5-14-97 TAX MAP NO. 4716156303 (PT) Watershed: ☐ Yes ☒ No

OWNER OR CONTRACTOR MARSHALL LEE GODFREY PHONE: Business _____ Home 872-3976

ADDRESS 482 MILLER FARM RD. STATESVILLE NC 28677

LOCATION NC 115 N, TL SCOTTS CREEK RD, TL SHEEP HILL LANE, 3RD LOT ON LEFT

SUBDIVISION SCOTTS CREEK LANDING BLOCK / SECTION _____ LOT 3 LOT AREA 19.10 Ac SITE CLASS. PS DESIGN FLOW 360 L.T.A.R. 0.30 GPD/FT²

Septic Tank: 1000 Gallons; STB 794 Date 3-19-97

Pump Tank: _____ Gallons; PT _____ Date _____

Pump Make: _____ Model _____ Serial No. _____

Nitrification Field: No Fields 1 Square Feet 1200 Linear Feet 400

No Lines FOUR Trench Width 36" Max Trench Bottom Depth 36" Gravel Depth 12"

☑ New System ☐ Repair System Type: I, II, III, IV, V, VI

System Description: CONVENTIONAL GRAVITY

Repair System Description: PPBPS pump

Maintenance Agreement Required: ☐ Yes ☒ No

☐ House/Mod. Home ☑ Mobile Home ☐ Business ☐ Other

No. Bedrooms 3 No. Bathrooms 2 No. Employees ____


☐ Slab ☑ Crawl Space ☐ Basement w/plumbing ☐ Basement wo/plumbing

Water Supply: ☐ Individual ☐ Community ☒ Public


Comments:

Comments:

INITIAL SITE SKETCH

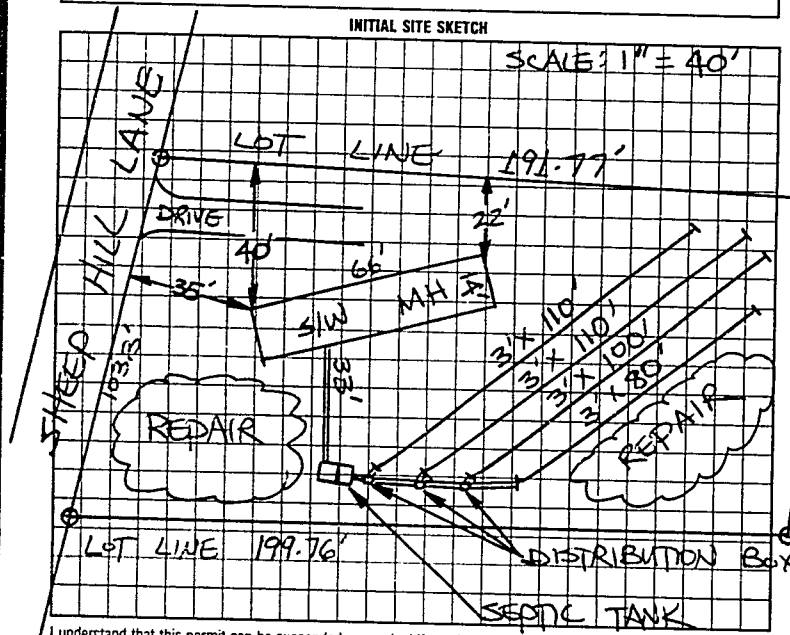

AS BUILT SKETCH

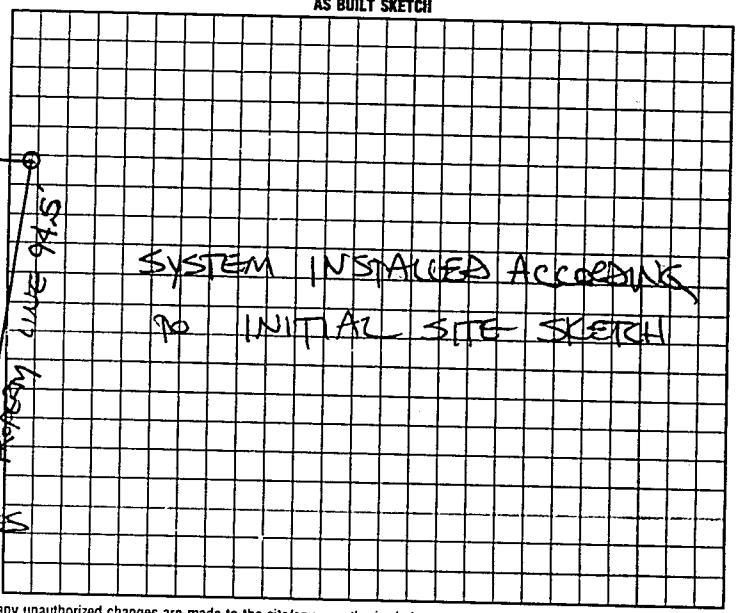

I understand that this permit can be suspended or revoked if any false information is supplied toward securing the permit/any unauthorized changes are made to the site/any unauthorized changes are made in the installation of the system. Improvement Permit is valid for 60 months from date of issuance. AUTHORIZATION TO CONSTRUCT IS VALID FOR 60 MONTHS FROM DATE OF ISSUANCE.

Signed: Marshall Lee Godfrey

Improvement Permit by: STEVE HEDRICK date 5-14-97

~~Authorization~~ Auth. to Const. by: STEVE HEDRICK date 5-14-97

Installed by: JAMES HUDLER

~~Certificate of Completion by:~~ _____ date _____

Operation Permit by: STEVE HEDRICK date 5-27-97

HEALTH DEPT. COPY: WHITE INSPECTION COPY (FINAL): GREEN OWNER COPY (FINAL): YELLOW INSPECTION COPY (INITIAL): PINK OWNER COPY (INITIAL): GOLD

S 0 2 0 0 0