# IREDELL COUNTY HEALTH DEPARTMENT

STATESVILLE 704-878-5305 MOORESVILLE 704-664-5281

## IMPROVEMENT PERMIT / CERTIFICATE OF COMPLETION / OPERATION PERMIT / EXISTING SYSTEM INSPECTION

PROPERTY DESCRIPTION NO. 26283 DATE 3-21-97 TAX MAP NO. 4617 15 6303 Watershed: ☐ Yes ☑ No

OWNER OR CONTRACTOR MARSHALL L. GODFREY PHONE: Business Home 872-3976

ADDRESS 482 MILLER FARM ROAD, STATESVILLE, NC 28677

LOCATION NC 115 N, TL SCOTTS CREEK RD, TL PT BOX #1216, 2ND LOT ON LEFT

SUBDIVISION SCOTTS CREEK LANDING BLOCK / SECTION LOT 2 LOT AREA 18,447 FT² SITE CLASS. PS DESIGN FLOW 360 L.T.A.R. 0.30 GPD/FT²

Septic Tank: 1000 Gallons; STB 794 Date 12-13-96

Pump Tank: Gallons; PT Date

Pump Make: Model Serial No.

Nitrification Field: No Fields ☐ Square Feet 600 TO 1200 Linear Feet 300+

No Lines FOUR Trench Width 36" Max Trench Bottom Depth 36" Gravel Depth N/A

☑ New System ☐ Repair System Type: I, II, III, IV, V, VI

System Description: CHAMBERED GRAVITY

Repair System Description: LPP - PUMPS

Maintenance Agreement Required: ☐ Yes ☑ No

☐ House/Mod. Home ☑ Mobile Home ☐ Business ☐ Other

No. Bedrooms 3 No. Bathrooms 2 No. Employees


☐ Slab ☑ Crawl Space ☐ Basement w/plumbing ☐ Basement wo/plumbing

Water Supply: ☐ Individual ☐ Community ☑ Public


Comments: INSTALL 50 CHAMBERS IN FOUR LINES AS SHOWN USING STEPDOWNS FOR SERIAL DISTRIBUTION

Comments:

INITIAL SITE SKETCH

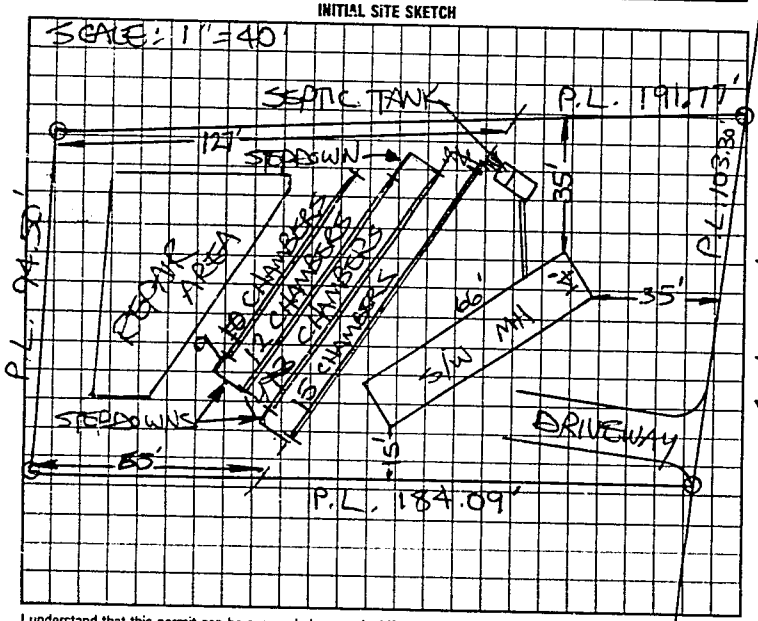


AS BUILT SKETCH

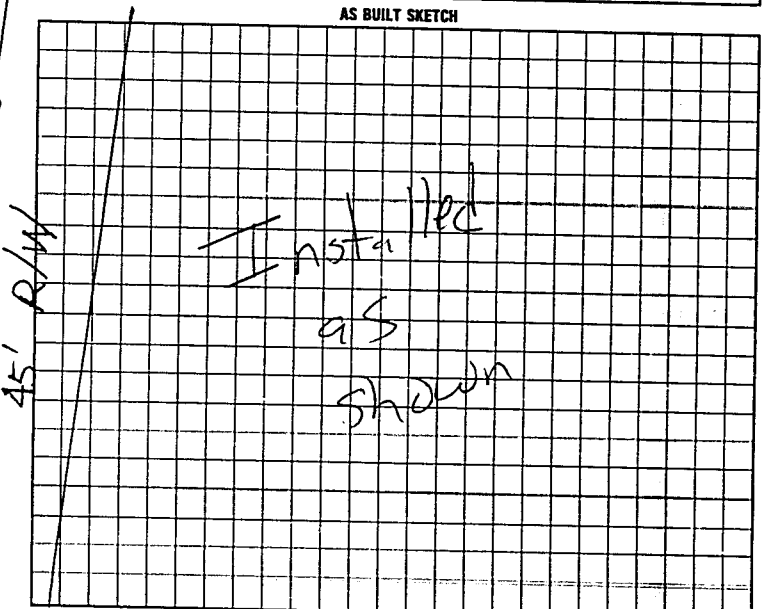


I understand that this permit can be suspended or revoked if any false information is supplied toward securing the permit/any unauthorized changes are made to the site/any unauthorized changes are made in the installation of the system. Improvement Permit is valid for 60 months from date of issuance. AUTHORIZATION TO CONSTRUCT IS VALID FOR 60 MONTHS FROM DATE OF ISSUANCE.

Signed:

Improvement Permit by: STEVE HEDRICK date 3-21-97

AUTH. TO CONST.

Existing System Inspection by: STEVE HEDRICK date 3-21-97

Installed by: James Huddle

~~Certificate of Completion by:~~ date

Operation Permit by: Mary C. Ott date 4-9-97

HEALTH DEPT. COPY WHITE INSPECTION COPY (FINAL) GREEN OWNER COPY (FINAL) YELLOW INSPECTION COPY (INITIAL) PINK OWNER COPY (INITIAL) GOLD