IREDELL COUNTY HEALTH DEPARTMENT

STATESVILLE 704-878-5305 MOORESVILLE 704-664-5281

IMPROVEMENT PERMIT / CERTIFICATE OF COMPLETION / OPERATION PERMIT / EXISTING SYSTEM INSPECTION

PROPERTY DESCRIPTION NO. 26284 DATE 3-21-97 TAX MAP NO. 4716 15 6303 Watershed: ☐ Yes ☑ No

OWNER OR CONTRACTOR MARSHALL L. GODFREY PHONE: Business Home 872-3976

ADDRESS 482 MILLER FARM ROAD STATESVILLE NC 28677

LOCATION NC 115 N TO SCOTTS CREEK RD, ON LEFT AT BOX #1216

SUBDIVISION SCOTTS CREEK LAND BLOCK / SECTION LOT 1 LOT AREA 15,730 FT² SITE CLASS. PS DESIGN FLOW 240 L.T.A.R. 0.30 GPD/FT²

Septic Tank: 1000 Gallons; STB 794 Date 12-13-96

Pump Tank: Gallons; PT Date

Pump Make: Model Serial No.

Nitrification Field: No Fields 1 Square Feet 720 to 810 Linear Feet 204 FT

No Lines THREE Trench Width 36" Max Trench Bottom Depth 36" Gravel Depth N/A

☑ New System ☐ Repair System Type: I, II, III, IV, V, VI

System Description: CHAMBERED GRAVITY

Repair System Description: LPP-PPBPS

Maintenance Agreement Required: ☐ Yes ☑ No

☐ House/Mod. Home No. Bedrooms 3

☑ Mobile Home No. Bathrooms 2

☐ Business No. Employees

☐ Other

☐ Slab ☑ Crawl Space ☐ Basement w/plumbing ☐ Basement wo/plumbing


Water Supply: ☑ Individual ☐ Community ☑ Public

Comments: INSTALL 34 CHAMBERS IN THREE LINES AS SHOWN USING STEPDOWNS FOR SERIAL DISTRIBUTION


Comments:

SCALE: 1" = 40'

INITIAL SITE SKETCH

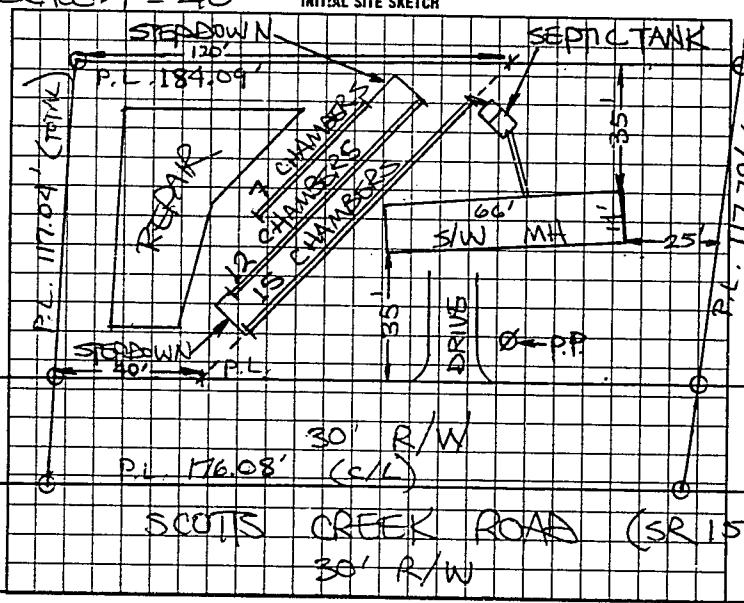

AS BUILT SKETCH

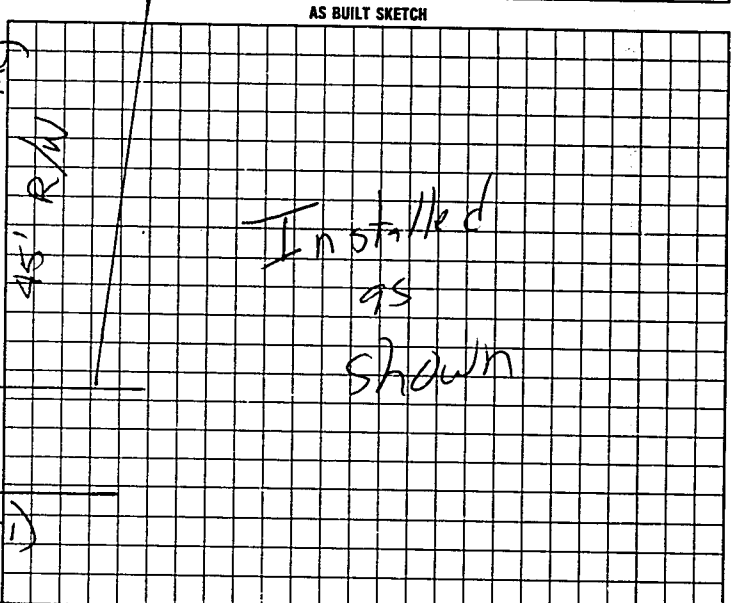

I understand that this permit can be suspended or revoked if any false information is supplied toward securing the permit/any unauthorized changes are made to the site/any unauthorized changes are made in the installation of the system. Improvement Permit is valid for 60 months from date of issuance. AUTHORIZATION TO CONSTRUCT IS VALID FOR 60 MONTHS FROM DATE OF ISSUANCE

Signed: Marshall L. Godfrey

Improvement Permit by: STEVE HEDRICK date 3-21-97

~~Authorization~~ to Construct ~~Existing System Inspection~~ by: STEVE HEDRICK date 3-21-97

Installed by: James Huddleston

~~Certificate of Completion~~ by: date

Operation Permit by: Mary C Ogles date 4-8-97

HEALTH DEPT. COPY: WHITE INSPECTION COPY (FINAL): GREEN OWNER COPY (FINAL): YELLOW INSPECTION COPY (INITIAL): PINK OWNER COPY (INITIAL): GOLD