IREDELL COUNTY HEALTH DEPARTMENT

Statesville Office (704) 878-5305 Mooresville Office (704) 660-3625 PERMIT # 21793

IMPROVEMENT PERMIT / AUTHORIZATION TO CONSTRUCT / OPERATION PERMIT / EXISTING SYSTEM

PIN # 4716270029

APPLICANT: Paul Cram APPLICANT ADDRESS: 177 Amos Lake Dr.

SITE ADDRESS: 177 Amos Lake Dr. PHONE: 704-872-5999 ALT. PHONE: N/A


SITE DIRECTIONS: Hwy 115 N TL Scotts Creek Rd. TR Amos Lake Dr.

SUBDIVISION: N/A SECTION: N/A LOT # N/A LOT AREA: 34.11 acres DESIGN FLOW: 480gpd L.T.A.R.: Existing

Septic Tank	1500	(gal)	STB	190-1500	Date	10-14-15	☐ New System	☑ Repair	☐ Expansion	System Type: I (II) III IV V VI	☑ Residence	No. Bedrooms	4	Water Supply	
Pump Tank		(gal)	PT		Date		System Description:	~~Repair~~ TANK			☐ Business	No. Persons	8	☑ Private	
Pump Make			Model		Serial #		Repair System Description:				☐ Other	No. Employees		☐ Public	
# Nitrification Fields	Ex	# Lines	Ex	Linear Ft:	Ex		Maintenance Agreement Required:	☐ YES	☑ NO		☐ Slab	☑ Crawl Space		☐ Community	
Trench Width	Ex	Max. Trench Bottom Depth	Ex	Gravel Depth	Ex			☑ GRAVITY	☐ PRESSURE		☐ Basement w/plumbing		☐ Basement w/o plumbing		

Comments / Conditions: This is a repair permit issued to replace existing septic tank due to presence of several cracks. Pump & Crush existing septic tank, Install 1500 gallon septic tank (per owners request) & connect to existing drainfield. Replace existing distribution box if needed.

INITIAL SITE SKETCH

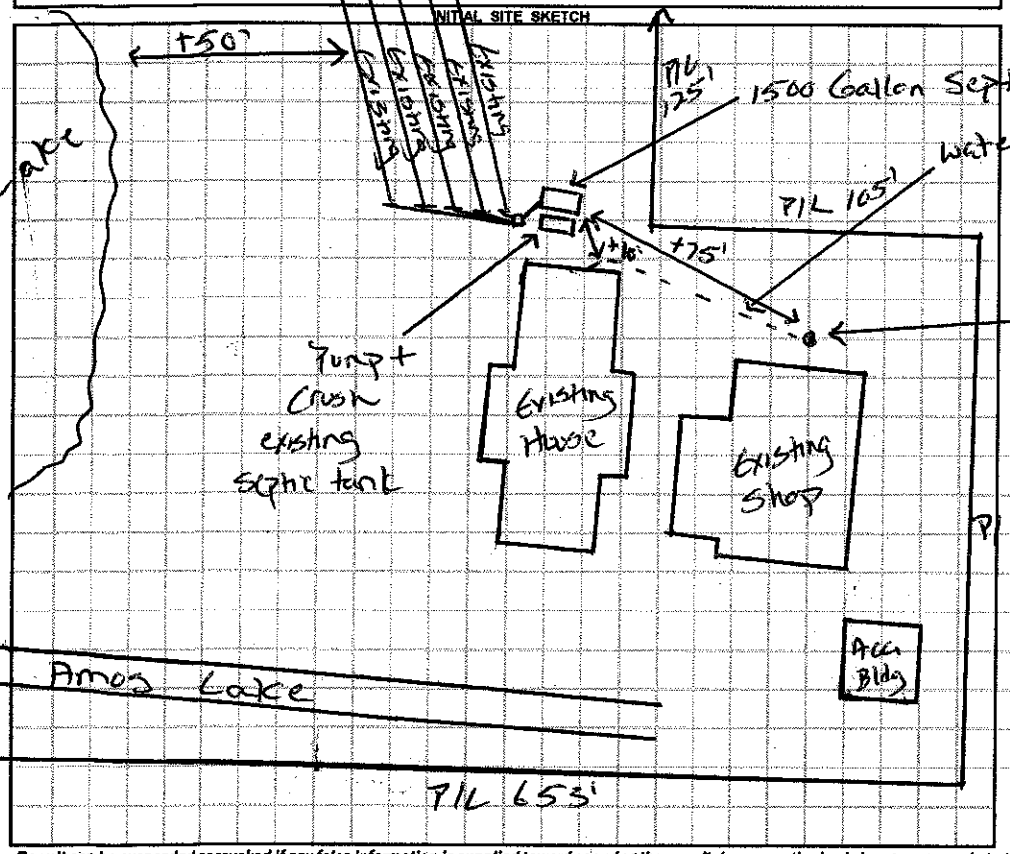

AS BUILT SKETCH

- Maintain a minimum of 10' between water line & septic tank system.
- Install risers if deeper than 6"
- Red Polylok filter installed on S.T.
- Risers installed on S.T.

1" = 60'

Permit can be suspended or revoked if any false information is supplied toward securing the permit / any unauthorized changes are made to the site / any unauthorized changes are made in the installation of the system. **CONTACT A LOCATOR SERVICE PRIOR TO ANY EXCAVATION**

☐ **IMPROVEMENT PERMIT** *with plat valid without expiration.* ☑ **IMPROVEMENT PERMIT** *with site plan valid for 60 mos.* ☑ **AUTHORIZATION TO CONSTRUCT** *valid for period equal to IMPROVEMENT PERMIT--not to exceed 60 mo.*

Owner / Applicant Signature: Paul Cram Date: 16 Mar-16 Installed by: K + M Grading

IMPROVEMENT PERMIT by: Justin Henderson Date: 3-16-16 OPERATION PERMIT by: Justin Henderson Date: 3-17-16

AUTHORIZATION TO CONSTRUCT by: Justin Henderson Date: 3-16-16 Existing System Inspected by: Date:

Health Dept. Copy - WHITE Applicant (Final Approval) - YELLOW Applicant (Conditional Approval) - PINK