11:00

IREDELL COUNTY HEALTH DEPARTMENT - *ENVIRONMENTAL HEALTH* ☑ STATESVILLE OFFICE 704-878-5305 ☐ MOORESVILLE OFFICE 704-664-5281

IMPROVEMENT PERMIT / AUTHORIZATION TO CONSTRUCT / OPERATION PERMIT / EXISTING SYSTEM INSPECTION

PERMIT # 171459 PIN # 4716-44-2248 DATE APRIL 9, 2012

OWNER KRISTA + SHANE BOLICK APPLICANT: KRISTA BOLICK PHONE: Home/Cell # (704) 924-8716 Business # (704) 902-4809

SITE ADDRESS 538 STEVENSON FARM ROAD, OWNER / APPLICANT ADDRESS 155 SIGMON RIDGE DR, STATESVILLE, NC 28677


SITE DIRECTIONS HWY 115 (N), (L) SCOTTS CREEK RD (L) STEVENSON FARM RD ≈ 1/2 MILE ON (L) ACROSS FROM POND

SUBDIVISION NA BLOCK / SECTION NA LOT # NA LOT AREA 5 AC DESIGN FLOW 480 L.T.A.R. 0.30 GPD/FT²


Septic Tank 1000	Gallons: STB 760	Date 10-12	☒ New System	☐ Repair	☐ Expansion System	Type I II (III) IV V VI	☒ Residence	No. Bedrooms 4	Water Supply
Pump Tank	Gallons: PT	Date	System Description: 25% REDUCTION GRAVITY				☐ Business	No. Persons	☐ Private
Pump Make	Model	Serial #	Repair System Description: 25% REDUCTION GRAVITY				☐ Other	No. Employees	☒ Public
No. Nitrification Fields: 1	No. Lines 4	Linear Feet 400	Maintenance Agreement Required ☐ YES ☒ NO				☐ Slab	☒ Crawl Space	☐ Community
Trench Width 36"	Max. Trench Bottom Depth 36"		Gravel Depth N/A	☒ GRAVITY	☐ PRESSURE		☐ Basement w/plumbing	☐ Basement w/o plumbing	

Comments / Conditions INSTALL 25% REDUCTION SYSTEM ON CONTOUR AS SHOWN USING SERIAL DISTRIBUTION

INITIAL SITE SKETCH

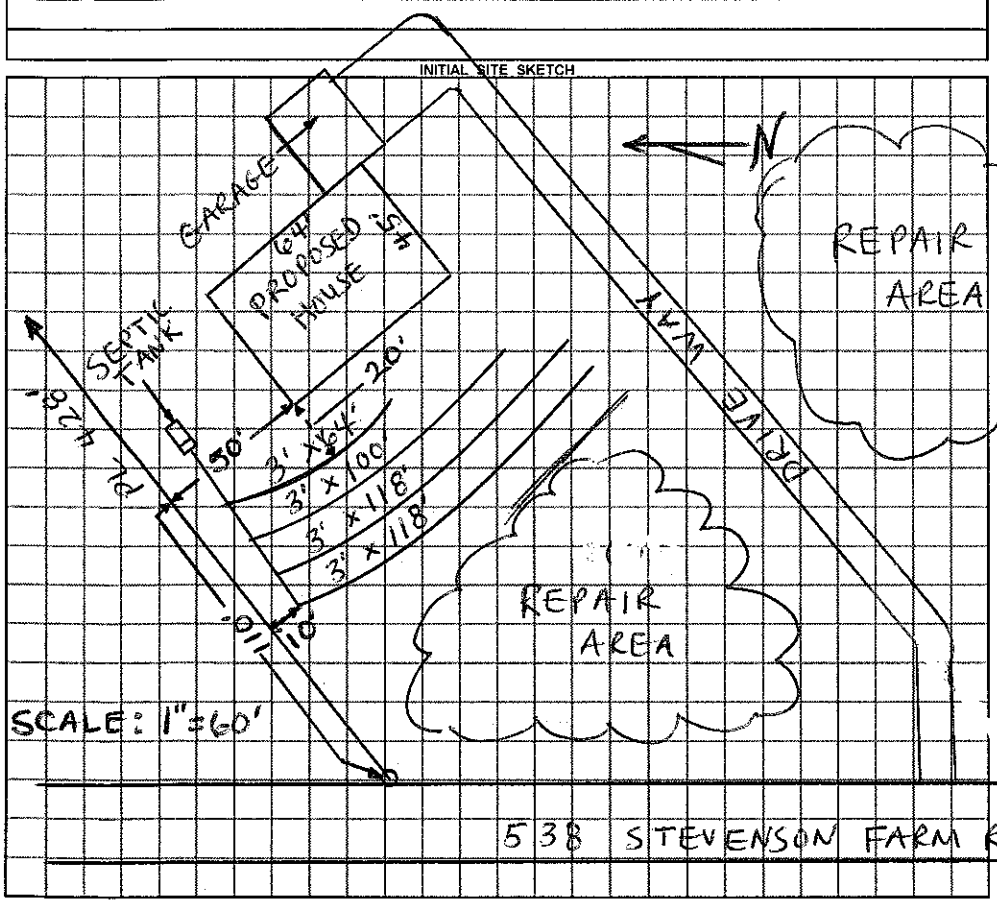

AS BUILT SKETCH

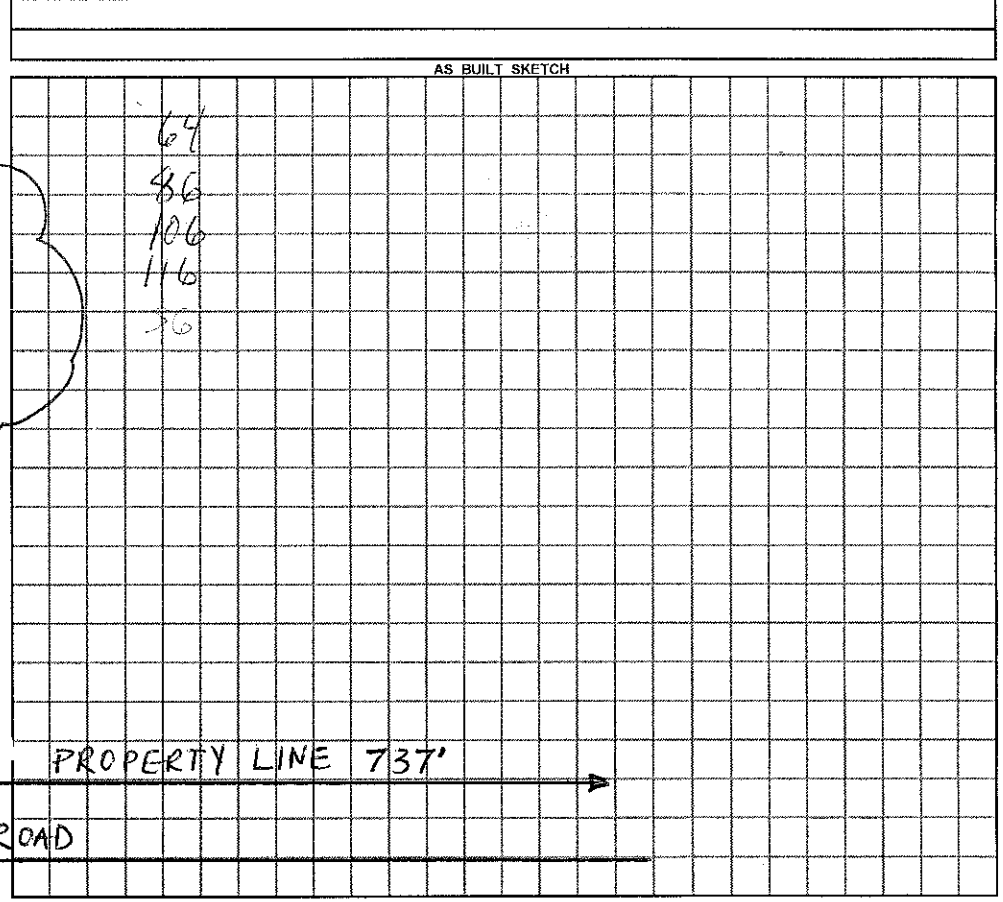

Permit can be suspended or revoked if any false information is supplied toward securing the permit / any unauthorized changes are made to the site / any unauthorized changes are made in the installation of the system.

☐ ***IMPROVEMENT PERMIT*** with plat valid without expiration. ☒ ***IMPROVEMENT PERMIT*** with plat valid without expiration. site plan valid 60 mo. ☒ ***AUTHORIZATION TO CONSTRUCT*** valid for period equal to IMPROVEMENT PERMIT--not to exceed 60 mo.

Owner / Applicant Signature: Krista S. Bolick Date 4.24.12 Installed by: A-1 Backhoe

IMPROVEMENT PERMIT by: Kimberley Meemine #1377 REHS Date 4-9-12 OPERATION PERMIT by: James REHS Date 2-15-13

AUTHORIZATION TO CONSTRUCT by: Kimberley Meemine #1377 REHS Date 4-9-12 Existing System Inspected by: REHS Date

YOU SHOULD CONTACT A LOCATOR SERVICE PRIOR TO ANY EXCAVATION

White Copy – Environmental Health YELLOW COPY (Final) Owner / Applicant PINK COPY (Initial) Owner / Applicant