IREDELL COUNTY HEALTH DEPARTMENT

STATESVILLE 704-878-5305 MOORESVILLE 704-664-5281

IMPROVEMENT PERMIT / AUTHORIZATION TO CONSTRUCT / OPERATION PERMIT / EXISTING SYSTEM INSPECTION

PERMIT# 082871 PIN# 4716 45 0440 (PART) DATE 12-20-99

OWNER OR CONTRACTOR JOSEPH PAYNE PHONE: Business Home 878-2553

ADDRESS 1305 SCOTTS CREEK ROAD, STATESVILLE, NC 28625

LOCATION NC 115 N, TL SCOTTS CREEK ROAD, LOT ON LEFT PAST STEVENSON FARM ROAD

SUBDIVISION BLOCK / SECTION LOT LOT AREA 1.44 ACRES SITE CLASS. PS DESIGN FLOW 360 L.T.A.R. 0.25 GPD/FT²

Septic Tank: 1000 Gallons; STB 1012 Date 11-9-00

Pump Tank: 1000 Gallons; PT 17 Date 1-29-00

Pump Make: Goulds Model WE03HM Serial No M9901198

Nitrification Field: No Fields Square Feet 1440 Linear Feet 480

No Lines SIX Trench Width 36" Max Trench Bottom Depth 36" Gravel Depth 12"

☑ New System ☐ Repair System Type: I, II, (III), IV, V, VI

System Description: CONVENTIONAL, PUMP

Repair System Description:

Maintenance Agreement Required: ☐ Yes ☑ No

☐ Slab ☐ Crawl Space ☑ Basement w/plumbing ☐ Basement wo/plumbing

☑ House/Mod. Home No. Bedrooms 3

☐ Mobile Home No. Bathrooms 2

☐ Business No. Employees


☐ Other

Water Supply: ☐ Individual ☑ Public ☐ Community


Comments/Conditions: SEE ATTACHED SHEETS FOR PUMP AND PRESSURE MANIFOLD REQUIREMENTS

Comments/Conditions: Pump Tank & Septic Tank & Lines installed 6-1 6-2 pressure set

INITIAL SITE SKETCH SCALE: 1" = 50'

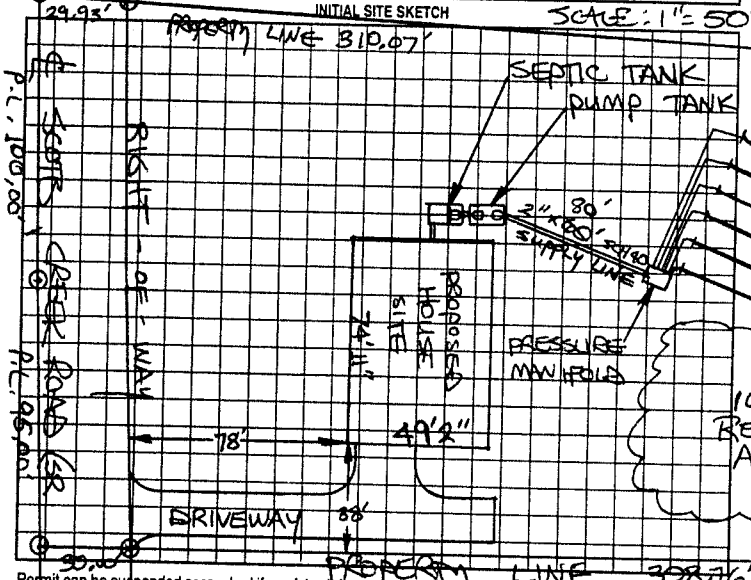

AS BUILT SKETCH

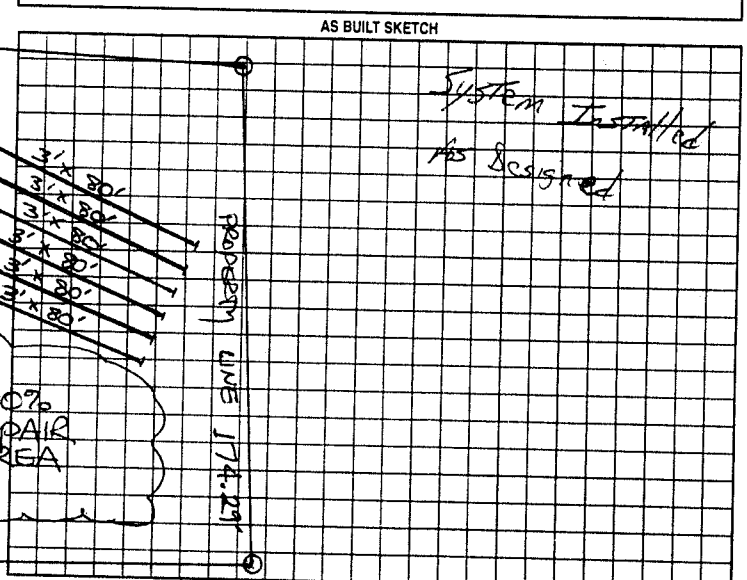

Permit can be suspended or revoked if any false information is supplied toward securing the permit/any unauthorized changes are made to the site/any unauthorized changes are made in the installation of the system. Improvement Permit with plat valid without expiration. Improvement Permit with site plan valid for sixty months. Authorization to Construct is valid for a period equal to that of Improvement Permit – not to exceed sixty months.

Signed: J.C. Payne date 12/28/99 Installed by: Tommy Frye

Improvement Permit by: STEVE HEDRICK date 12-20-99 Operation Permit by: STEVE HEDRICK date 7-21-00

Authorization to Construct by: STEVE HEDRICK date 12-20-99 Existing System Inspection by: date

HEALTH DEPT. COPY WHITE OWNER COPY (FINAL): YELLOW OWNER COPY (INITIAL): PINK